


LAKEVIEW MEDICAL ARTS CENTER

Floor 01

Suite 71
AS-BUILT

1,717 SF
AVAILABLE

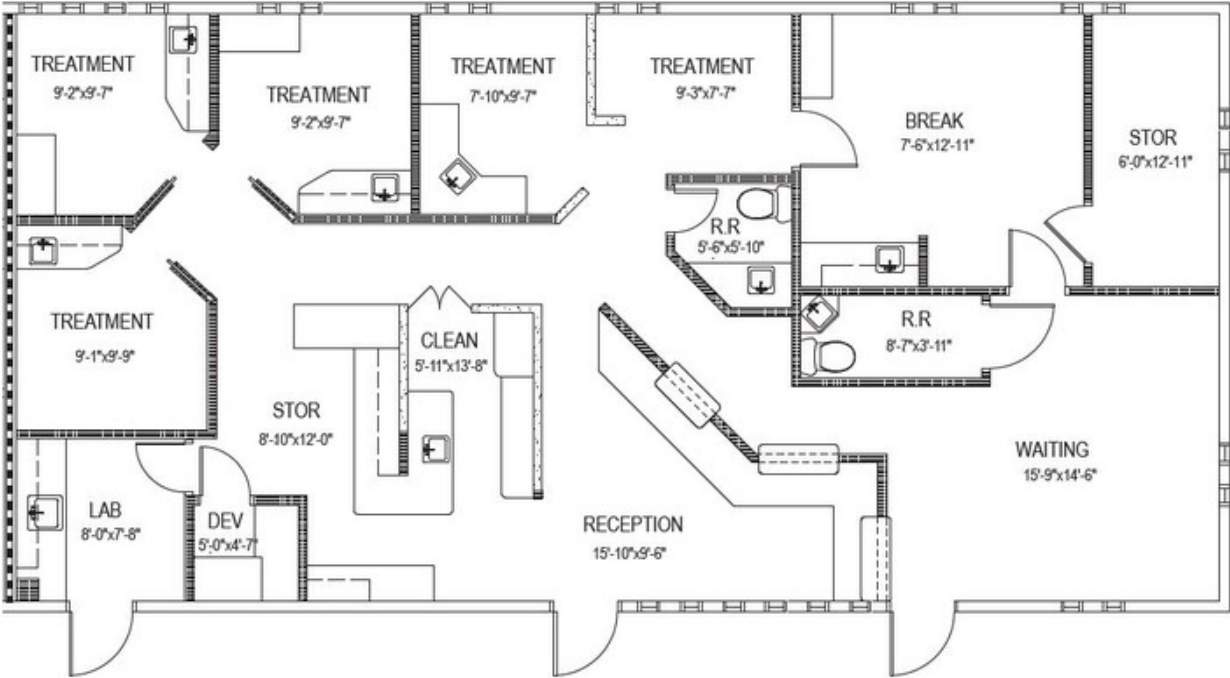

RACHAEL THOMPSON
Senior Vice President
602.513.5122
rachael.thompson@kidder.com

PERRY GABUZZI, CCIM
Senior Vice President
602.513.5116
perry.gabuzzi@kidder.com