



# 2828 MIDLAND MEDICAL BUILDING

2828 CHICAGO AVE SOUTH, MINNEAPOLIS, MN 55407

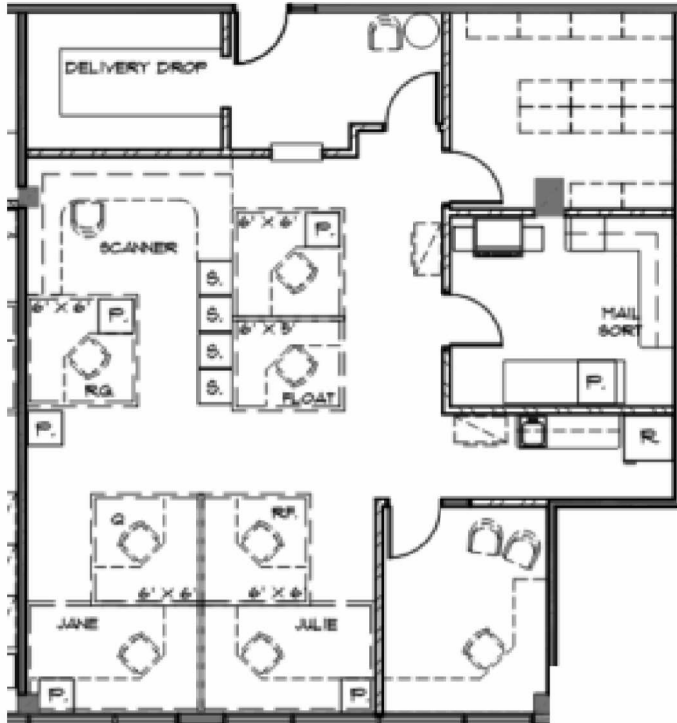

Building Key

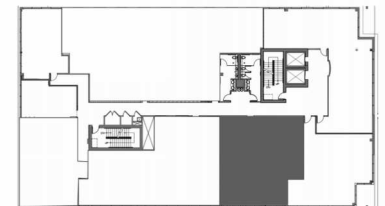

Suite: 301C

1,765 Rentable Square Feet

Mike Fleetham  
952-767-2842 (direct)  
612-386-0993 (mobile)  
mfleetham@medcraft.com

Jolene Ludvigsen  
952-838-7126 (direct)  
612-889-7586 (mobile)  
jludvigsen@medcraft.com

Leased by:  
 **MedCraft**<sup>®</sup>  
Healthcare Real Estate

Managed by:  
 **CUSHMAN & WAKEFIELD**