
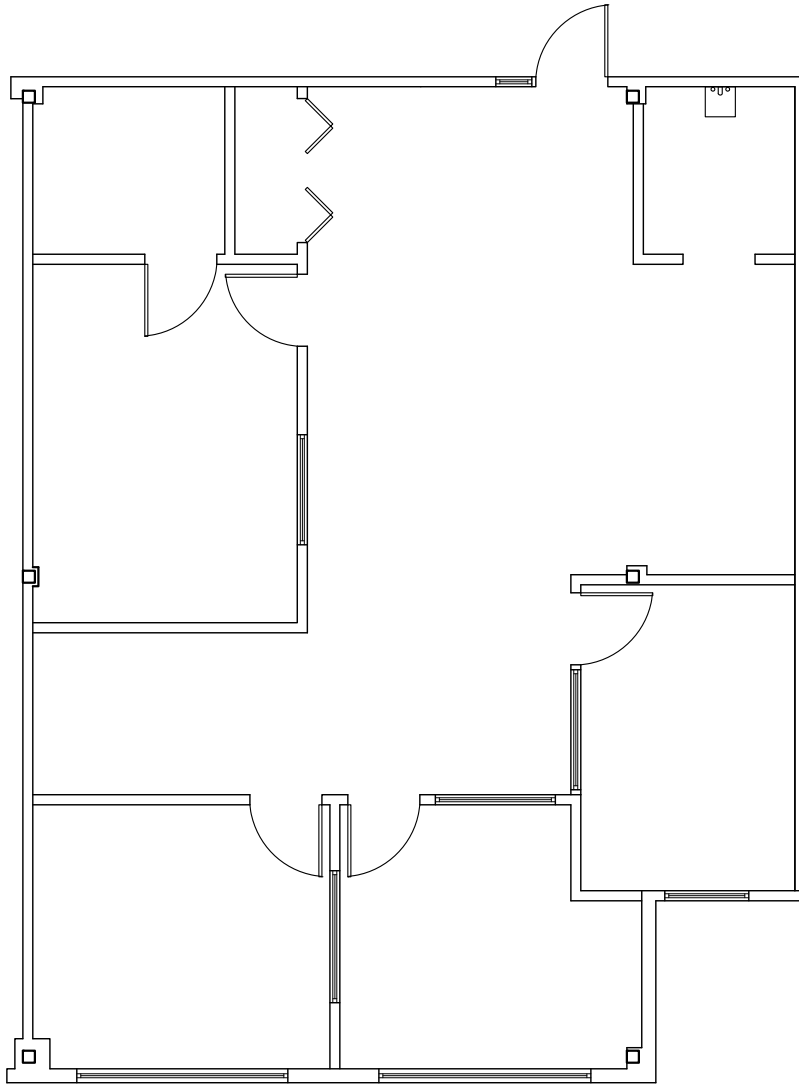


GREGG JORDAN & ASSOCIATES

1330 CENTRE STREET
NEWTON CENTER, MA 02459
TEL.: (617) 527-1800

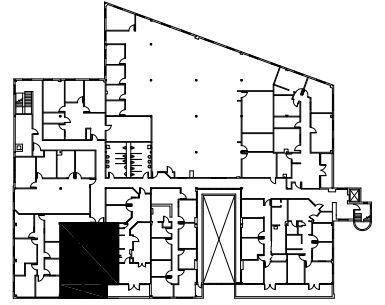

1340 CENTRE STREET, NEWTON CENTER, MA
SECOND FLOOR, SUITE #208

SCALE: 1/8" = 1'-0"
03/11