
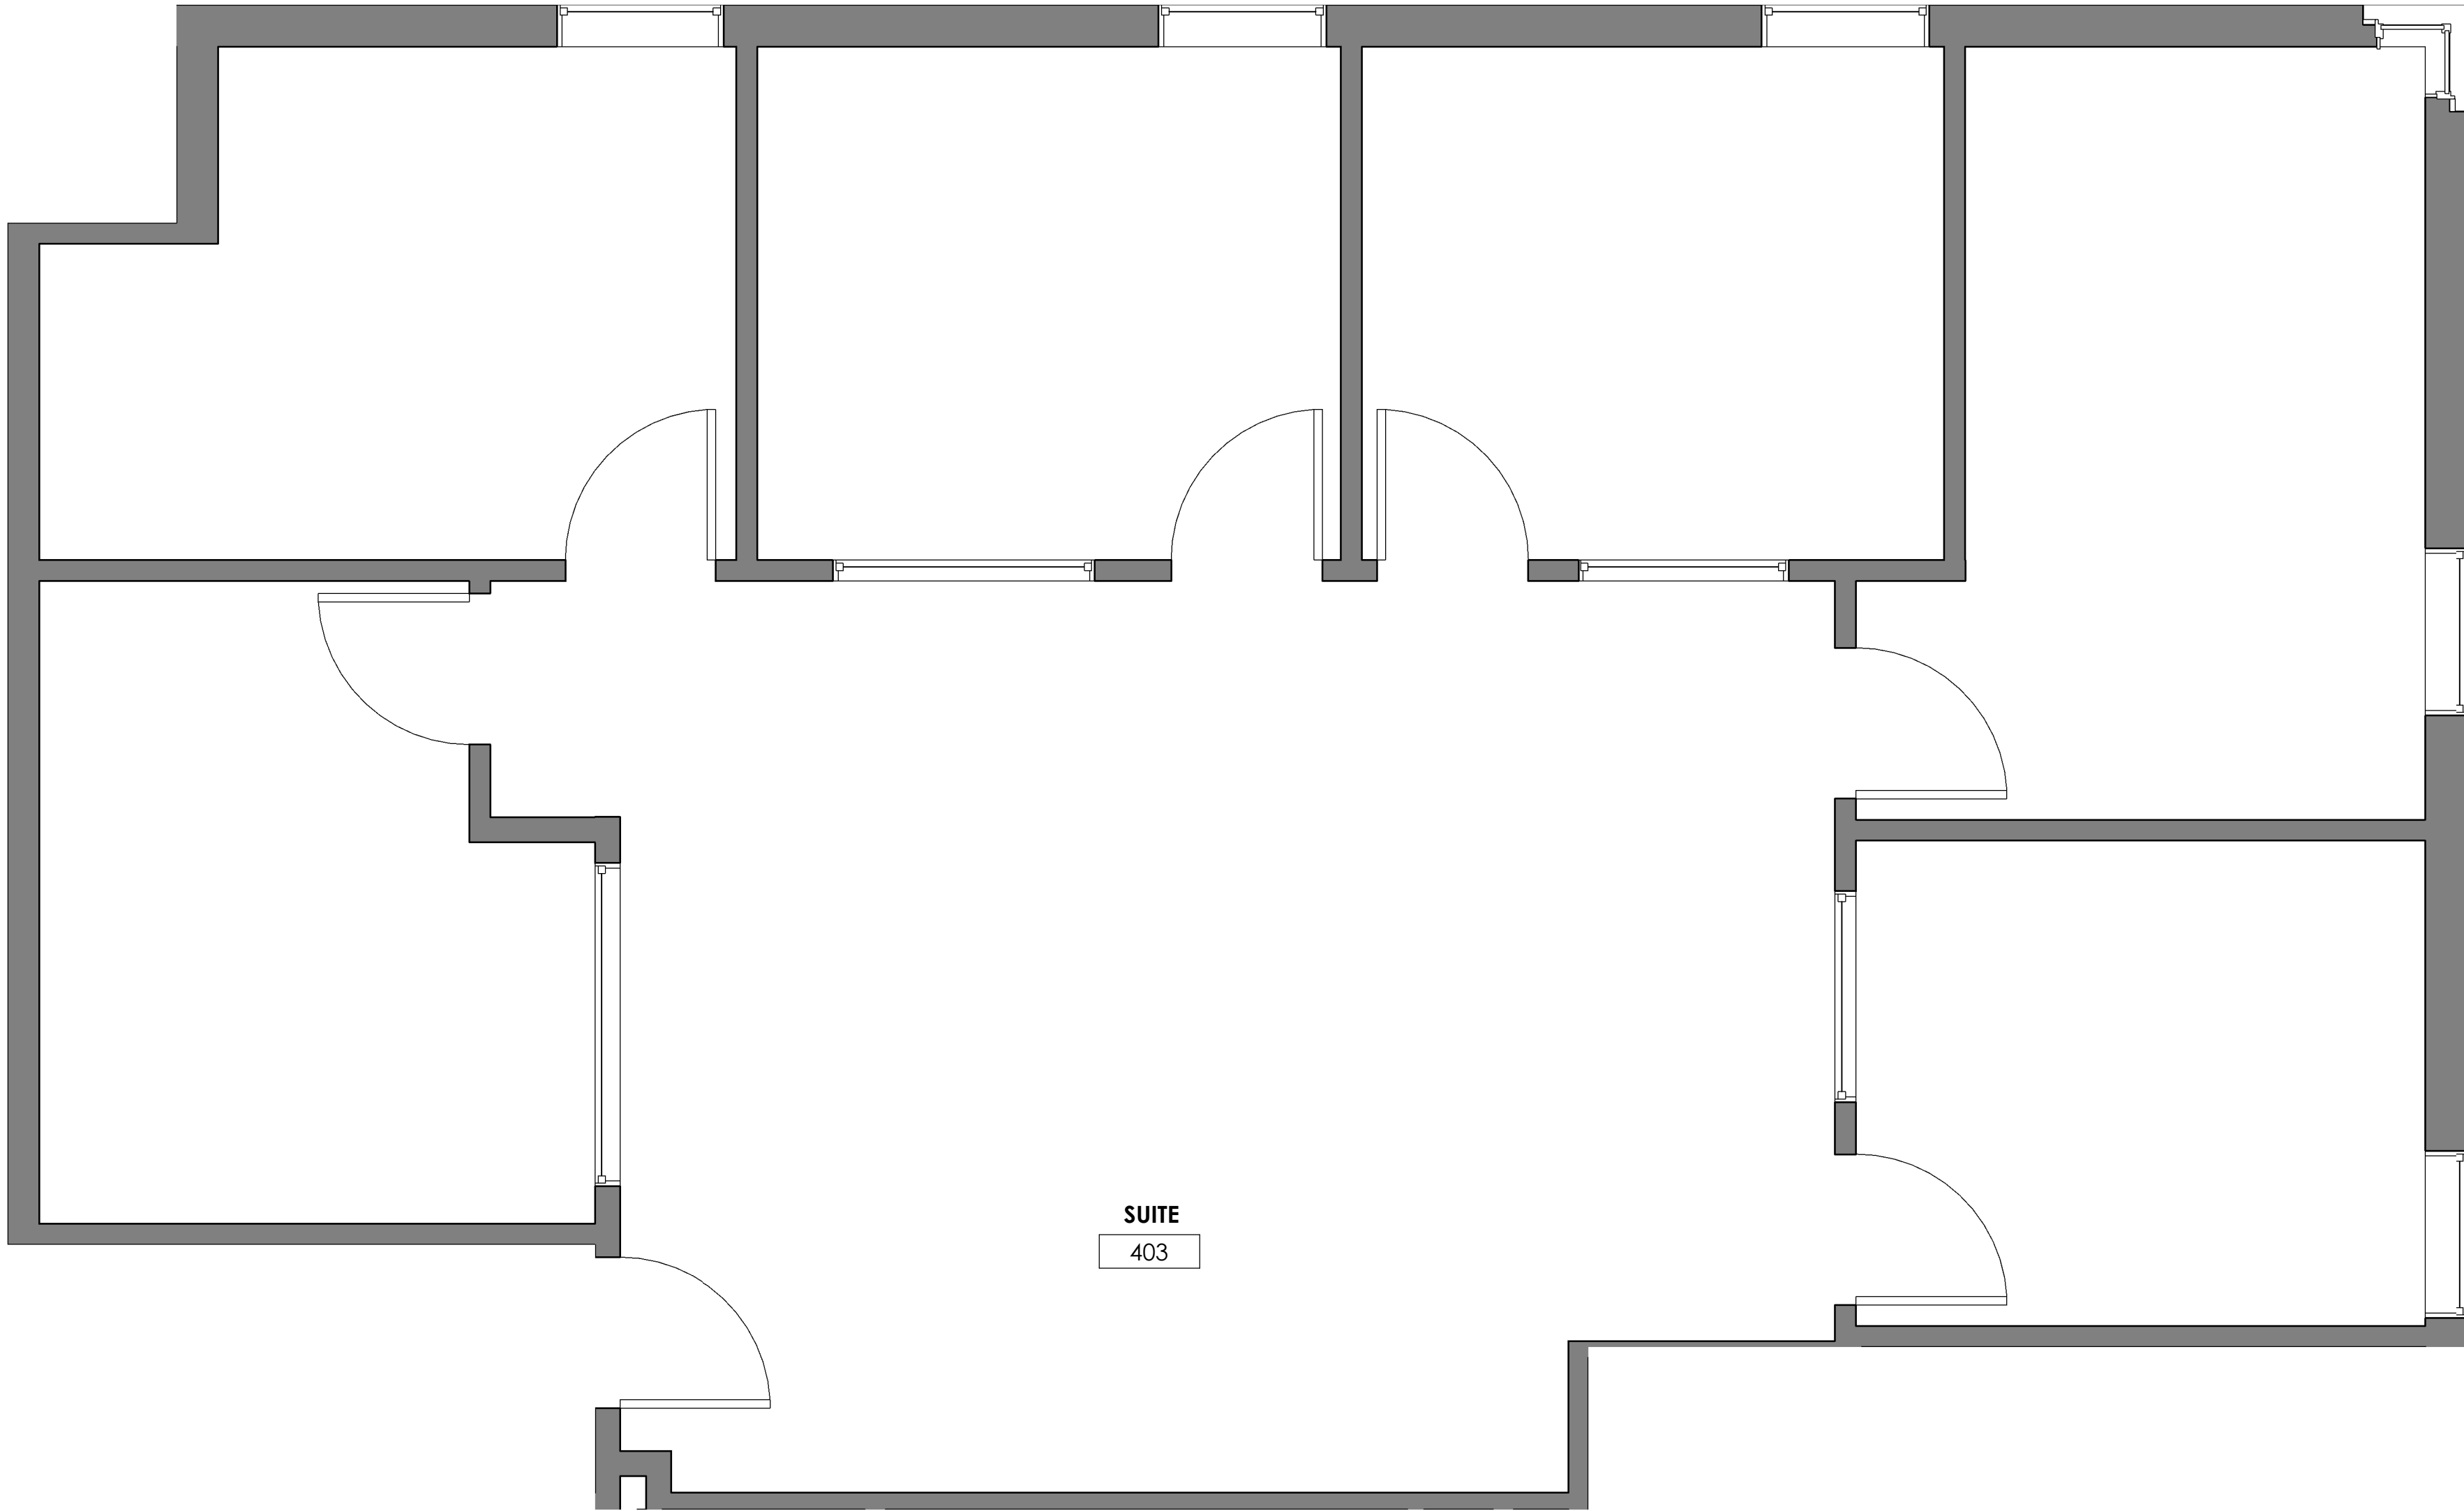


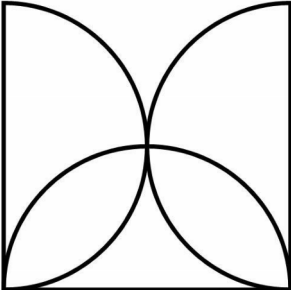

1

SUITE 403 - AS-BUILT PLAN

Scale: 3/8" = 1'-0"

DATE	#	DESCRIPTION
CONSULTANTS:		
DESIGNER:		
 DENVER DRAFTING & DESIGN 98 WADSWORTH BLVD #127-3216 LAKEWOOD, CO 80226 303.906.6801 www.denverdrafting.com		
PROJECT NAME:		
90 MADISON PLAZA - AS-BUILTS 90 Madison St Denver, CO 80206		
DATE:	10/05/2023	
SCALE:	3/8" = 1'-0"	
SHEET NAME:	SUITE 403 - AS-BUILT PLAN	
SHEET NUMBER:	A-135	