

Plan A Services Inc.

70 Gilbert St,
Monroe, NY 10950

718.219.4749

info@planaservices.com
planaservices.com

Project

128 Bingham Rd,
Asheville, NC 28806

Drawing

Floor plan

 As-built
Floor Plans

A - 002.19


Area _____

Scale 3/16":1'

Date 7/6/2025

Drawn By M.O.

Notes _____

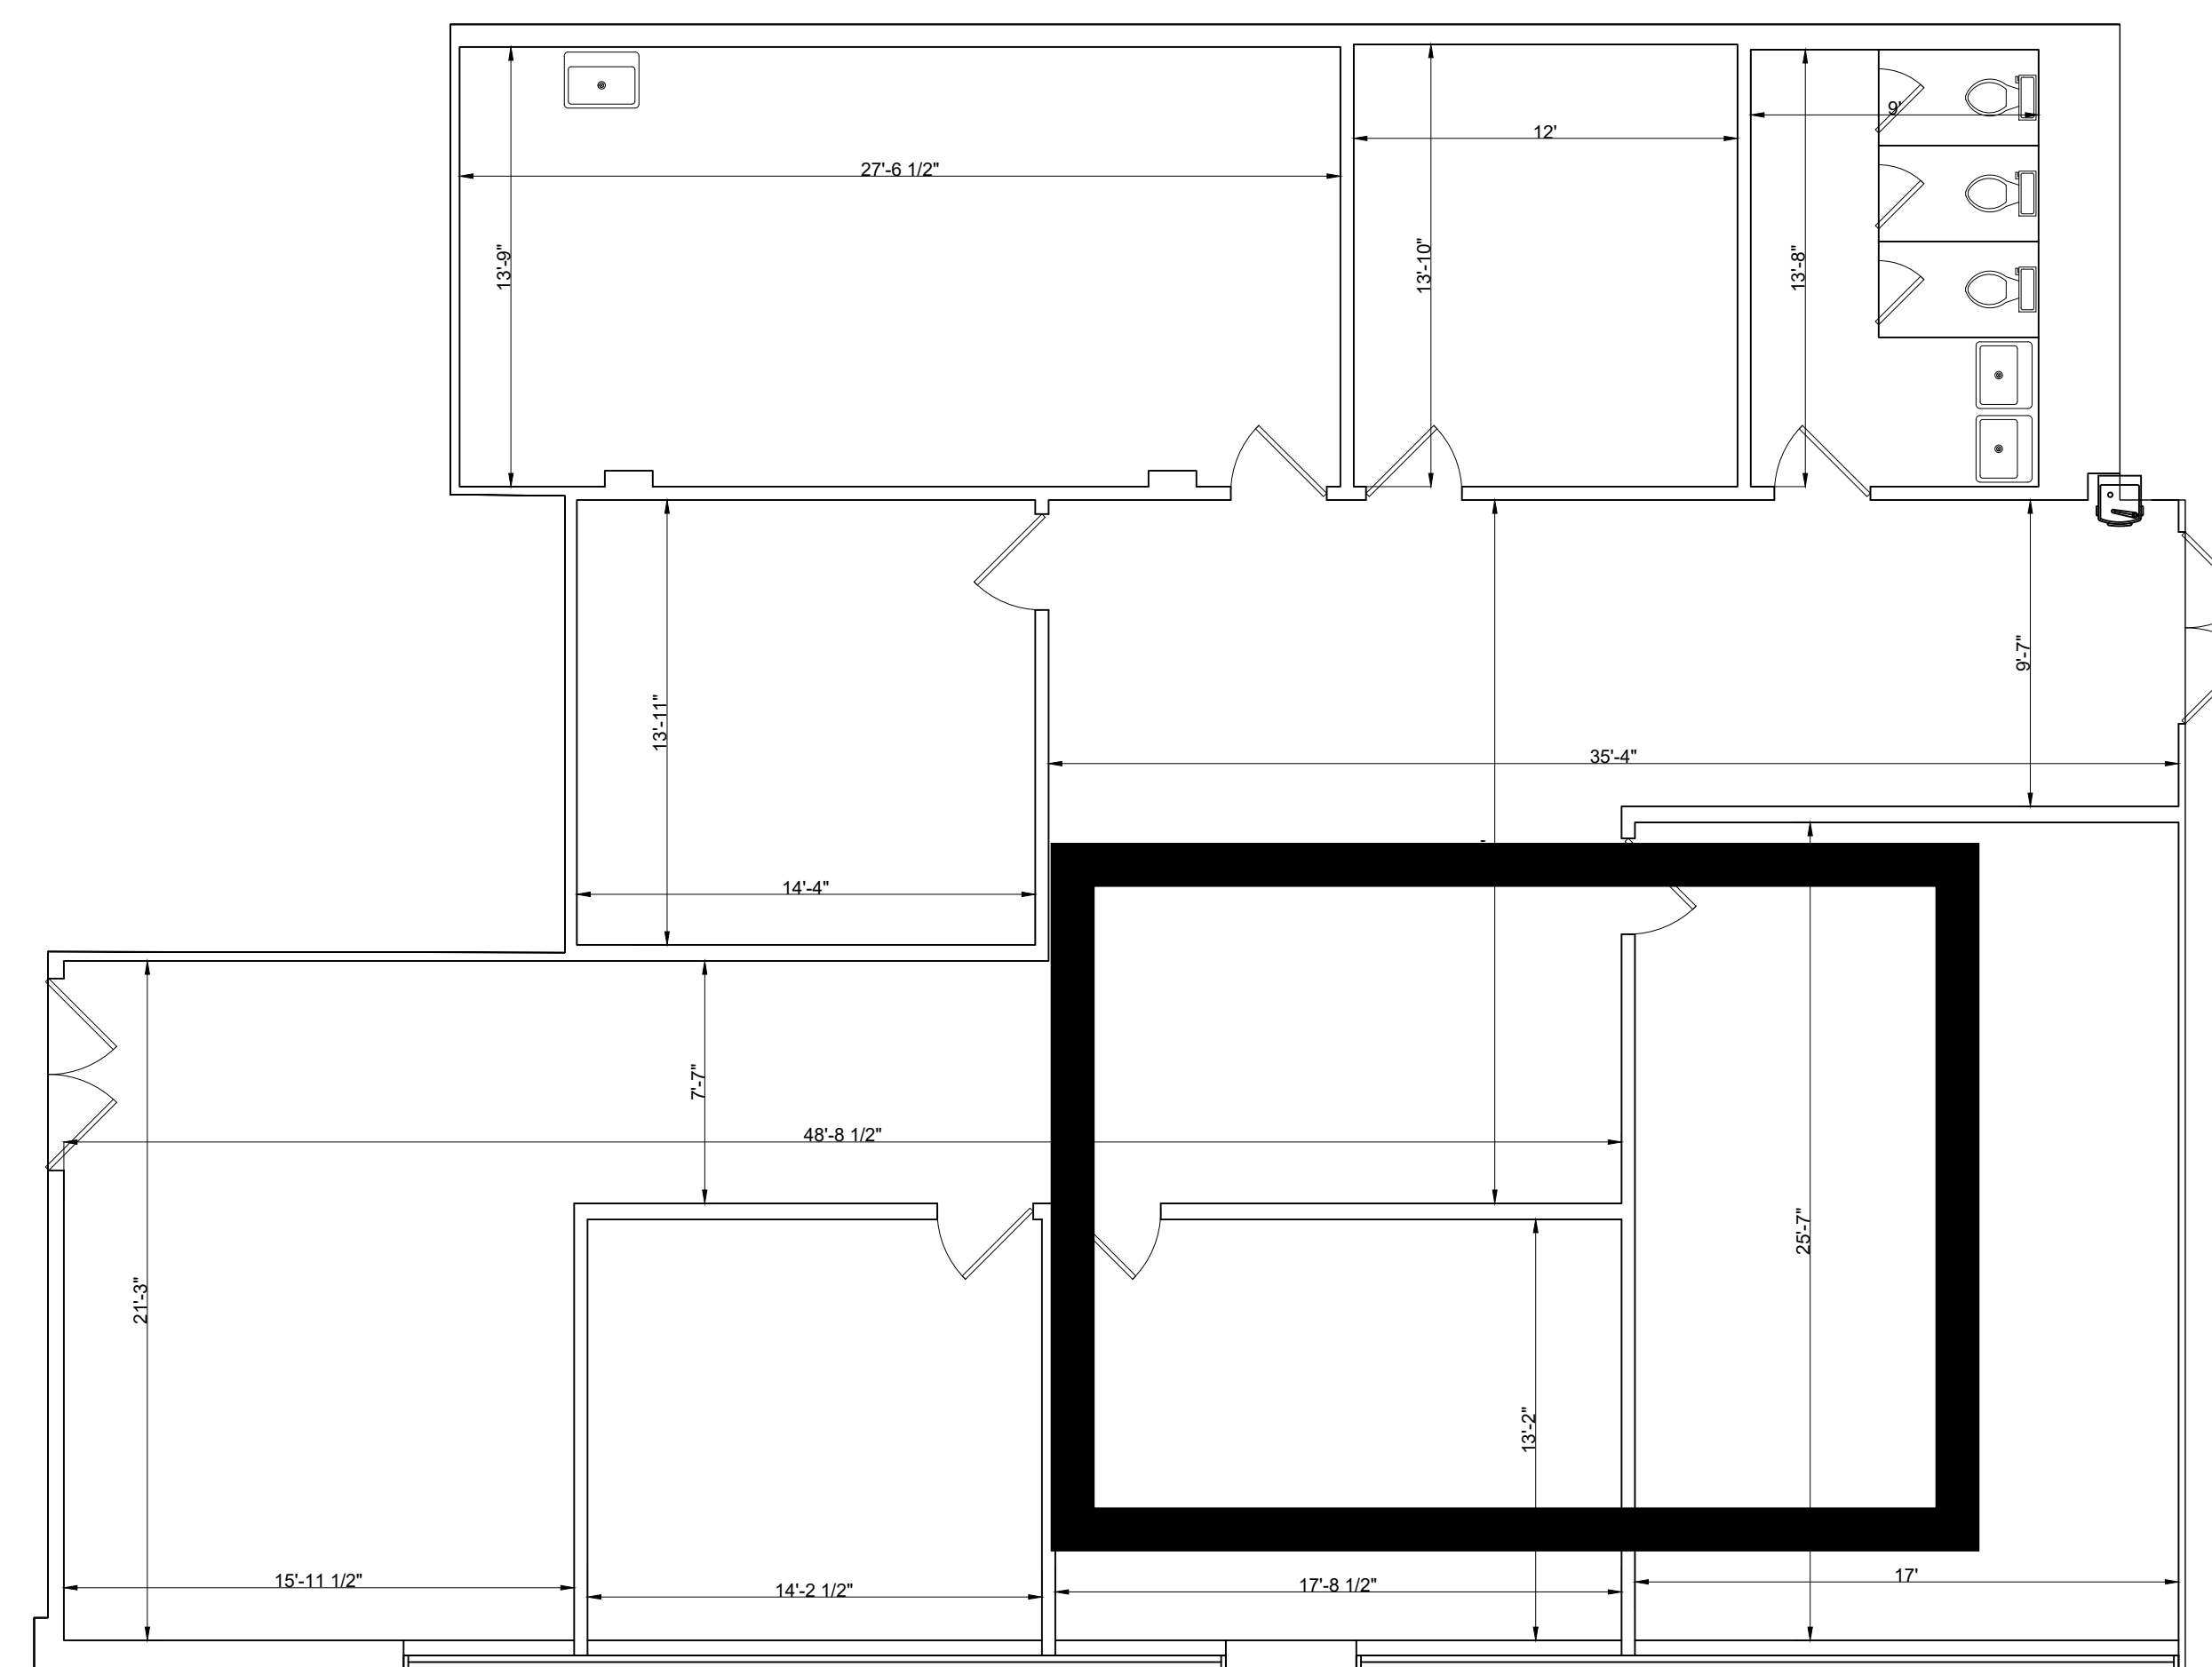

Suite # 750

S=3018 sq.ft.