


TWIN CENTRAL OFFICE BUILDING

1401 North Central Expressway, Richardson, Texas

SUITE 201
1,823 RSF

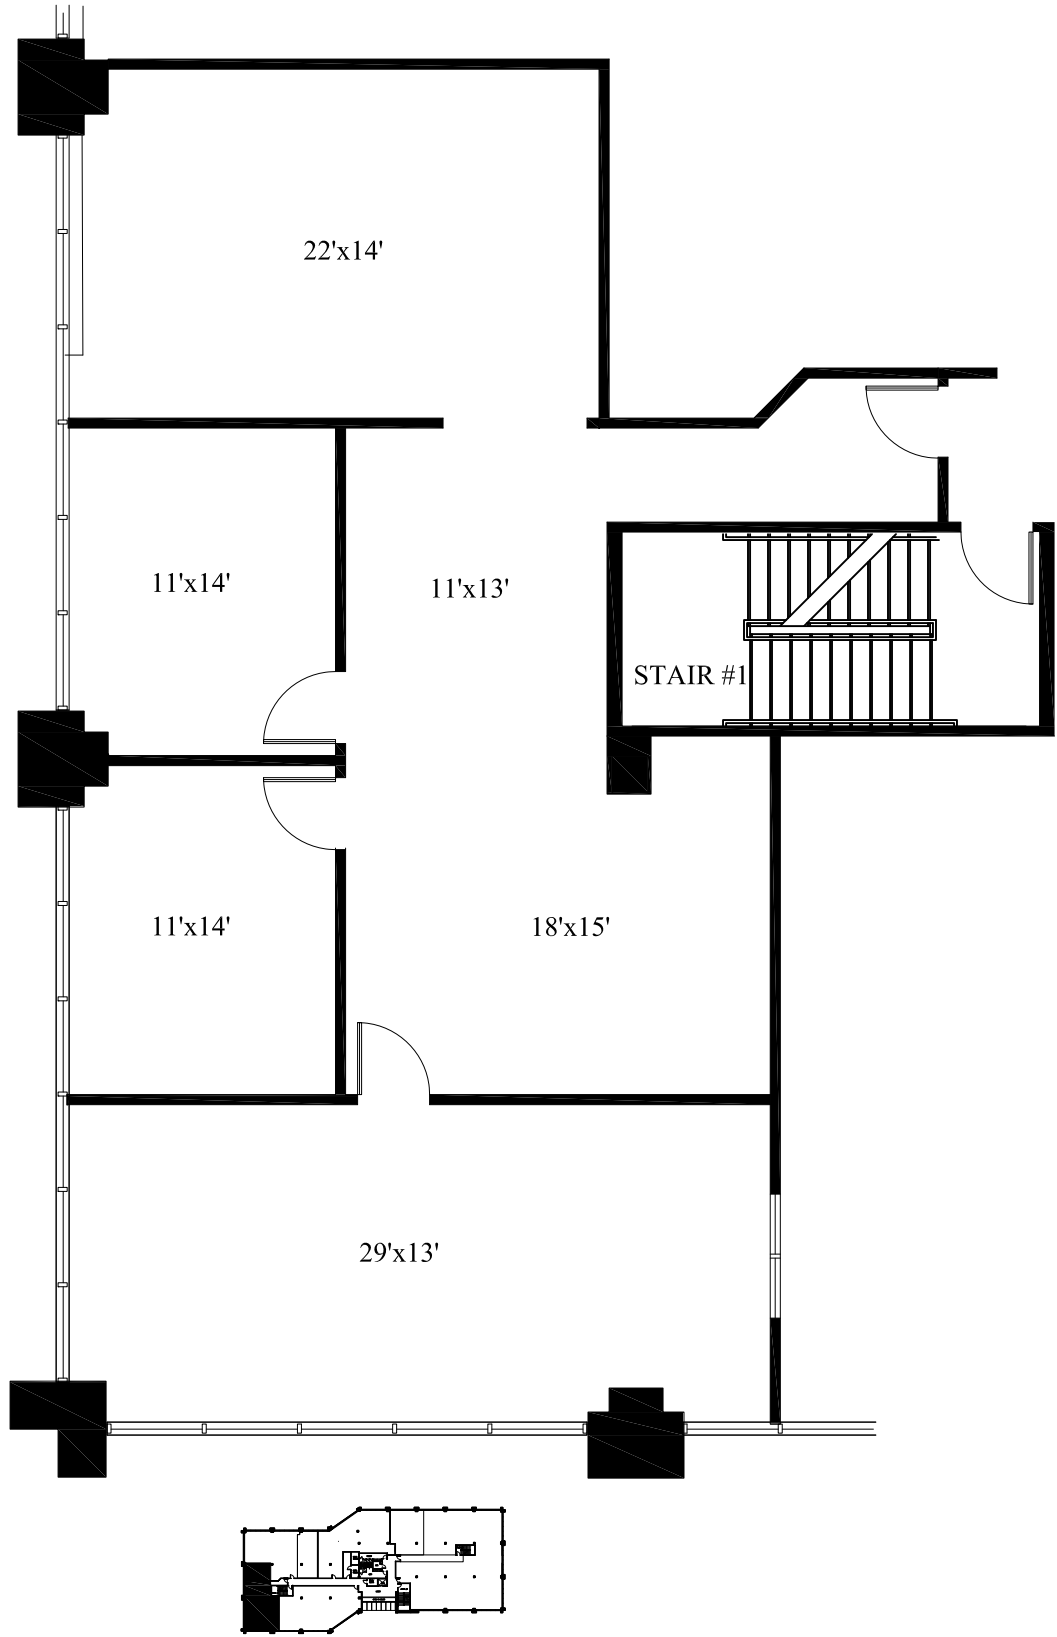

2ND FLOOR

Scale: 1/8"=1'-0"

All dimensions and square footages are approximate.

January 17, 2024

