
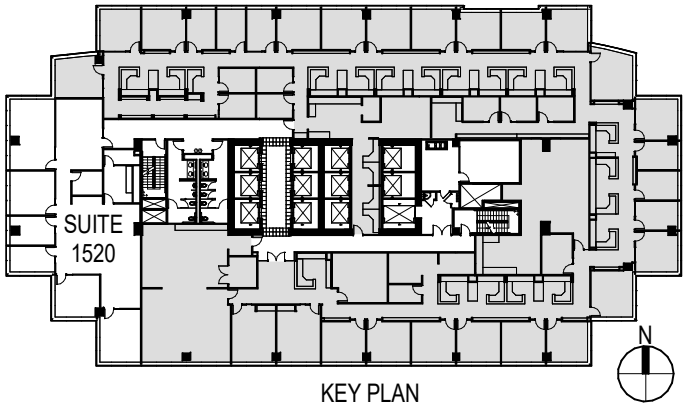


CITYSCAPE

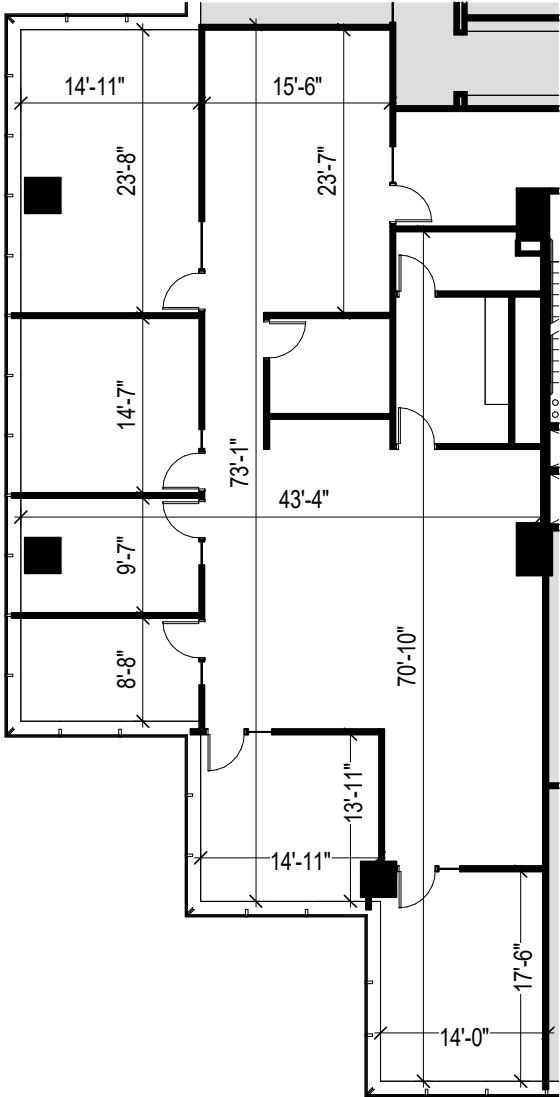

JOHN BROWNLEE
jbrownlee@reddevelopment.com
972.672.8560

JEFF MOLOZNIK
jmoloznik@reddevelopment.com
480.556.7735

SUITE 1520
3,824 RSF

