
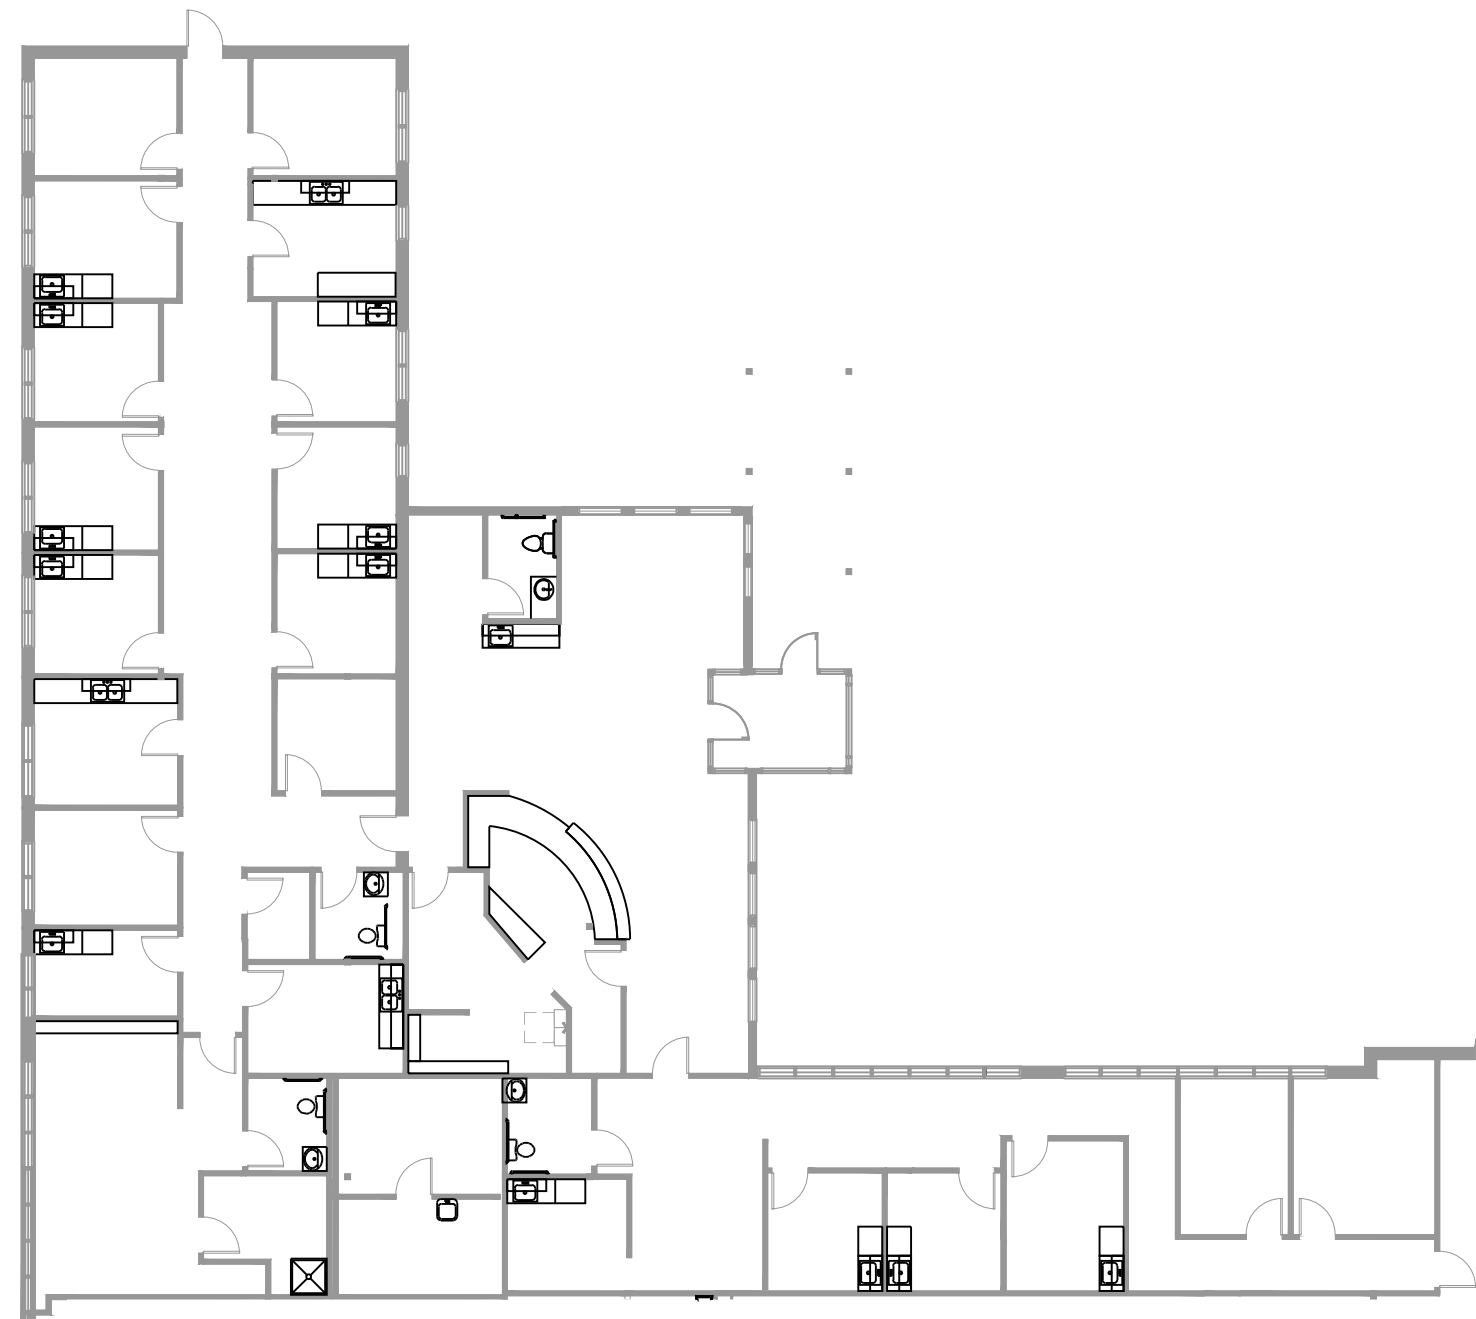


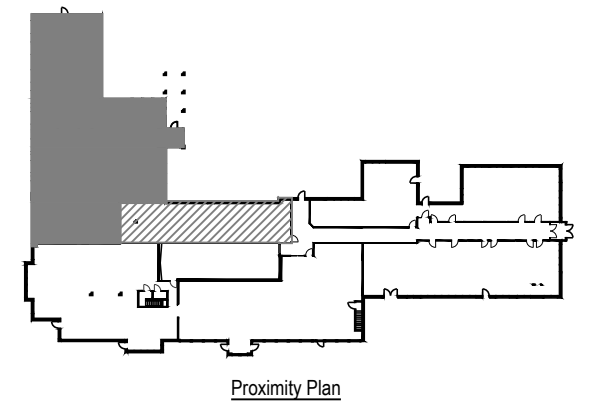

1675 18th Ave

Concordia Building

As-Built Plan

Sheet 1 of 1

As-Built Plan
Issued: 24July2026
Drawn by: MCP / AT / AT
TPS Project #:

Concordia Building
Level One; Suite 1 & 2
1675 18th Ave.
Greeley, CO 80631

TPS
1660 Lincoln St, Ste. 100
Denver, Colorado 80264
(303) 861-4800
www.TPS.design