


**ENCOMPASS STUDIO**  
architecture + interiors

241 W. Charleston Blvd, Suite 155 | Las Vegas, NV 89102  
design@encompassstudiovegas.com 702.733.7759

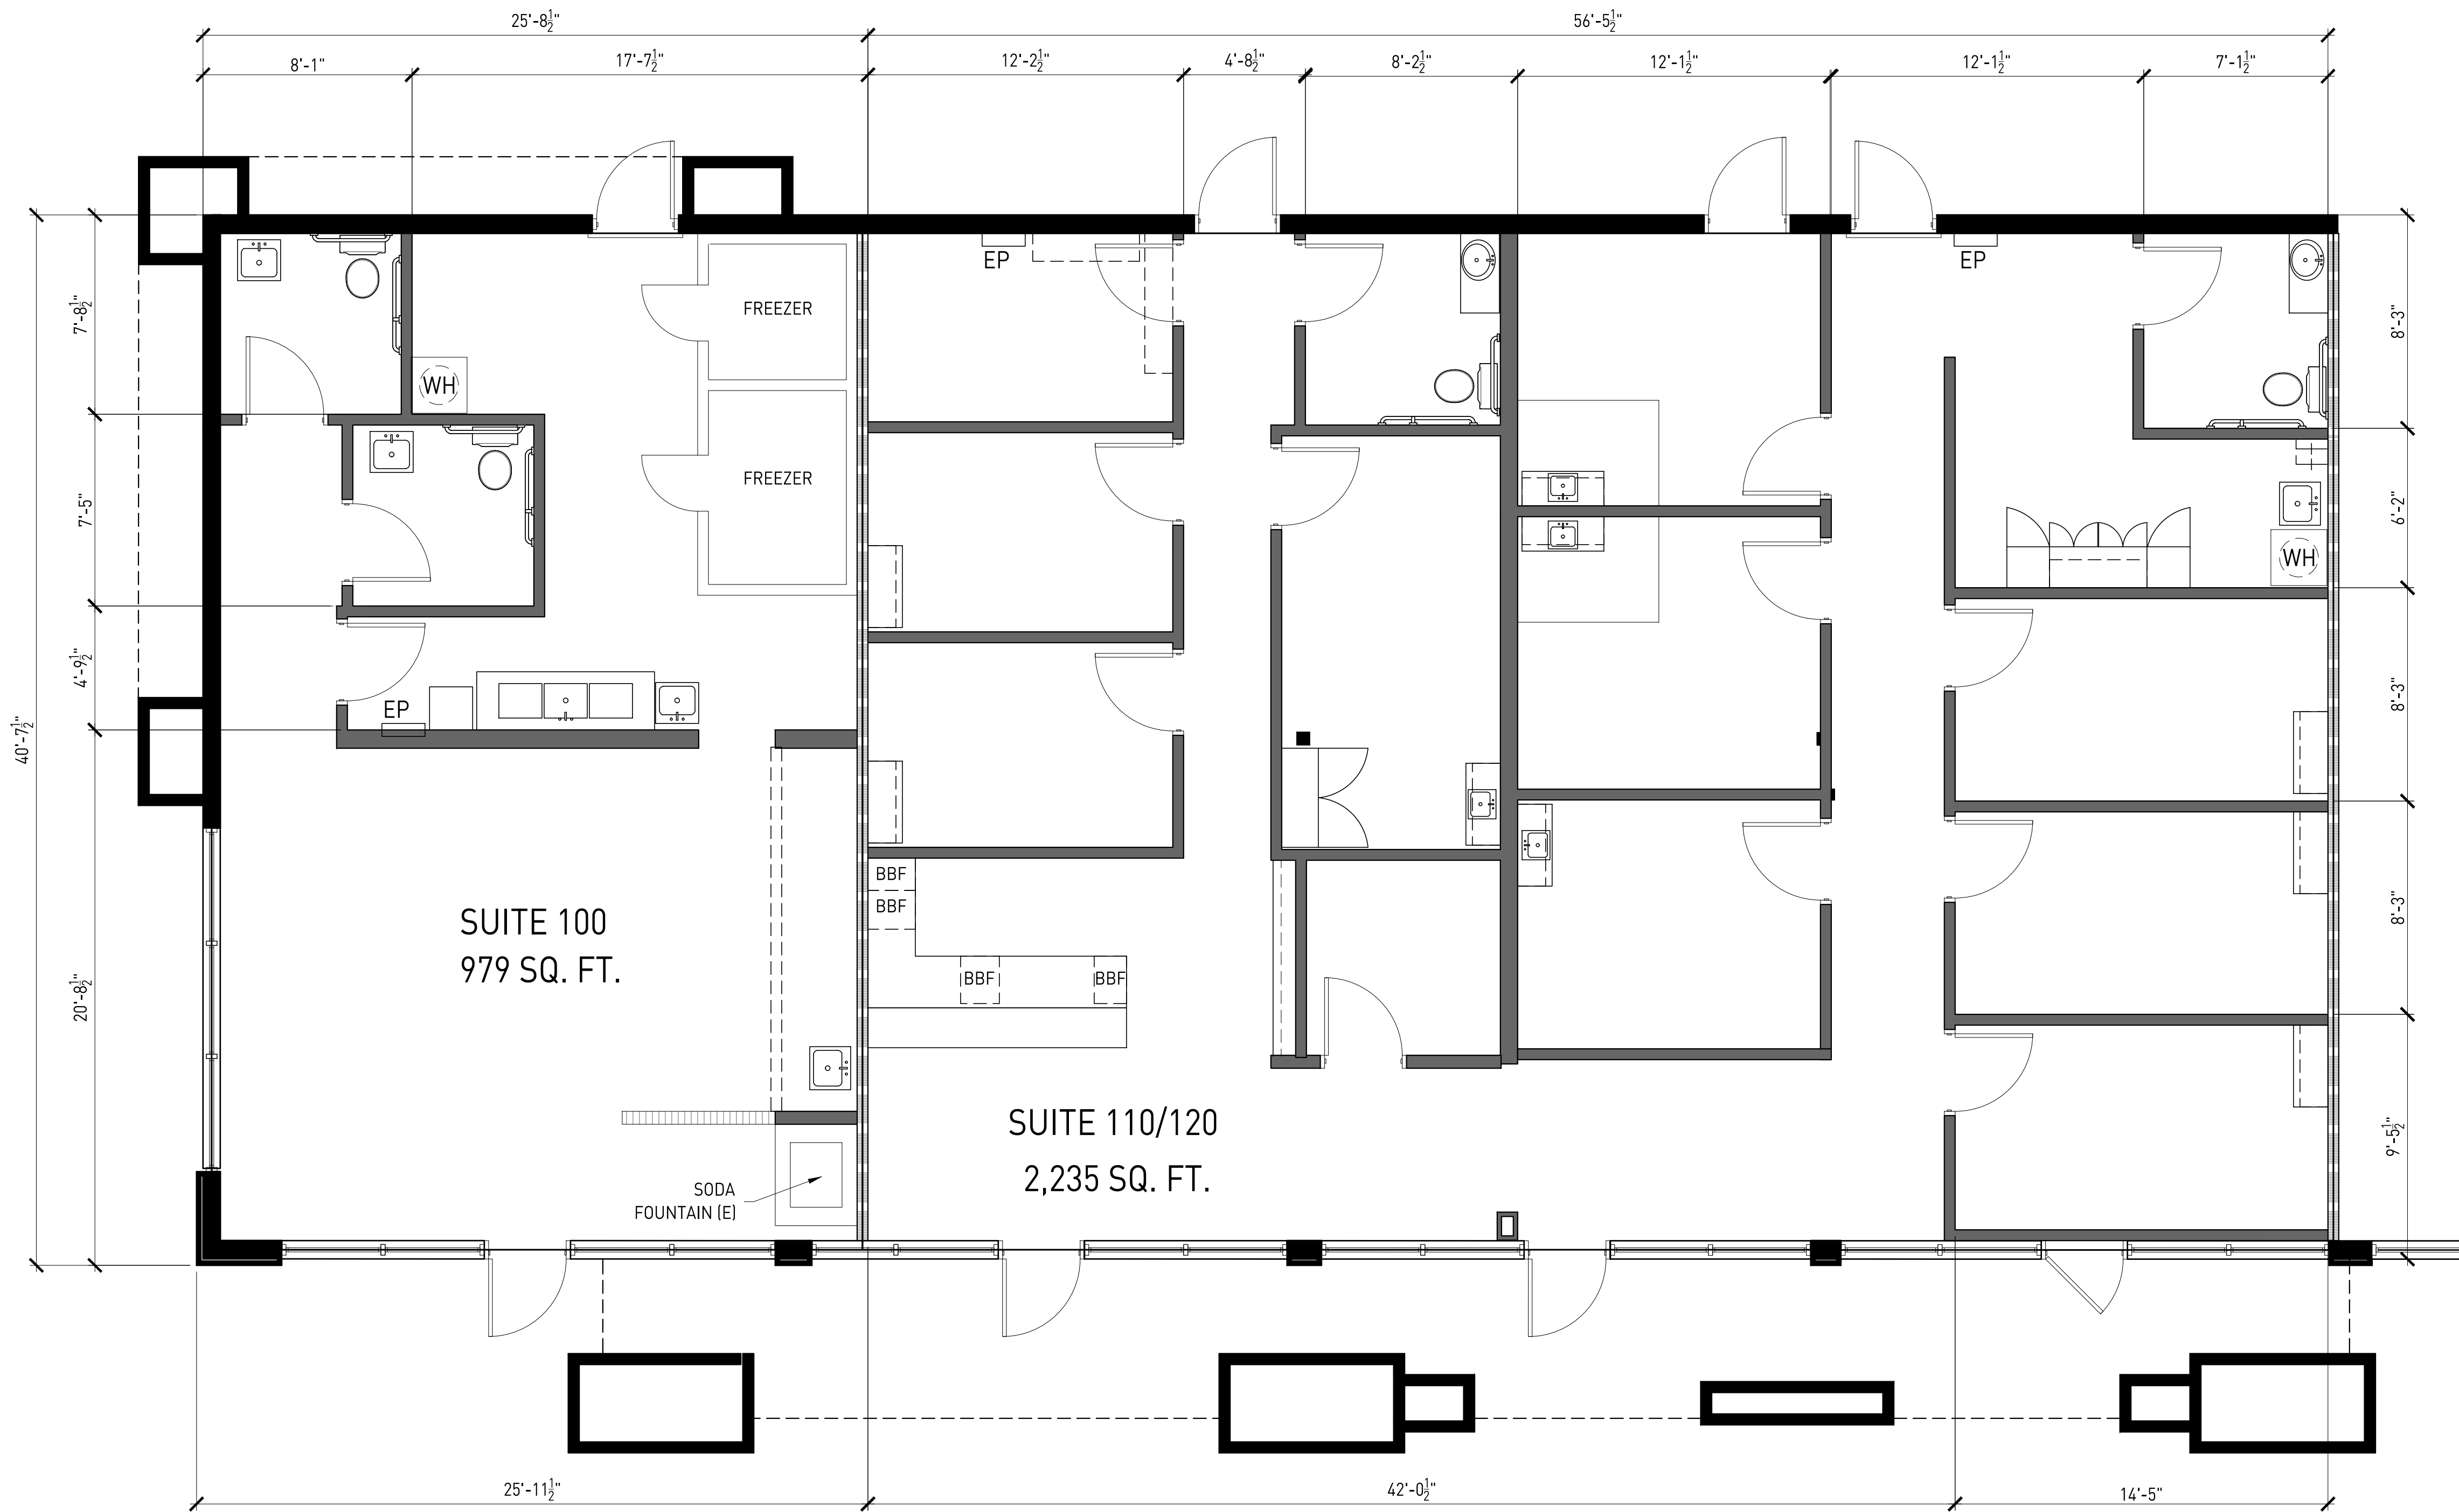

**AS-BUILT**  
LEVEL ONE

for  
VALLE VERDE 215 CENTER  
34 & 40 NORTH VALLE VERDE, SUITE 100 AND 110/120  
HENDERSON, NEVADA 89074

SEAL

NO.	REVISIONS

DATE: 04.28.21      DRAWN BY: E.E.  
PROJECT NO: 8797      CHECKED BY: D.H.

SHEET NUMBER

**AI-1.0**

**AS BUILT - 3,214 S.F. / SUITE 100 - 979 S.F. - SUITE 110/120 - 2,235 S.F.**

SCALE: 1/4" = 1'-0"

