



## **GENERAL NOTES**

THIS DRAWING IS INTENDED TO DOCUMENT EXISITING CONDITIONS AND IS NOT INTENDED FOR CONSTRUCTION.


THIS DRAWING IS BASED UPON RESONABLE EFFORTS TO DOCUMENT MEASUREMENTS TAKEN IN THE FIELD.

SOME FIELD MEASUREMENTS ARE APPROXIMATED AS NEARLY AS REASONABLE.

OWNER SHALL BRING ANY DISCREPANCY OR QUESTION TO OUR ATTENTION.

GROSS SQUARE FOOTAGE MEASURED FROM CENTERLINE OF TENANT SEPARATION WALL TO CENTERLINE OF TENANT SEPARATION WALL AND OUTSIDE FACE OF EXTERIOR WALL TO CENTERLINE OF TENANT SEPARATION WALL.

Commons irise Dr. E B TN 37186 Westmoreland

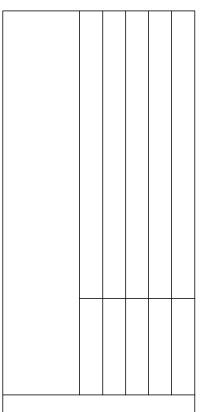

EX 1.0