



SUITE 260
AS BUILT - 1 OF 1
CHARLOTTE PARK III
4,874 RSF
SCALE: 3/32" = 1'-0"
DATE: MAY 5, 2022

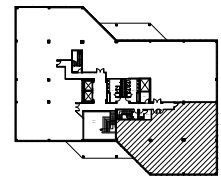

KEY PLAN

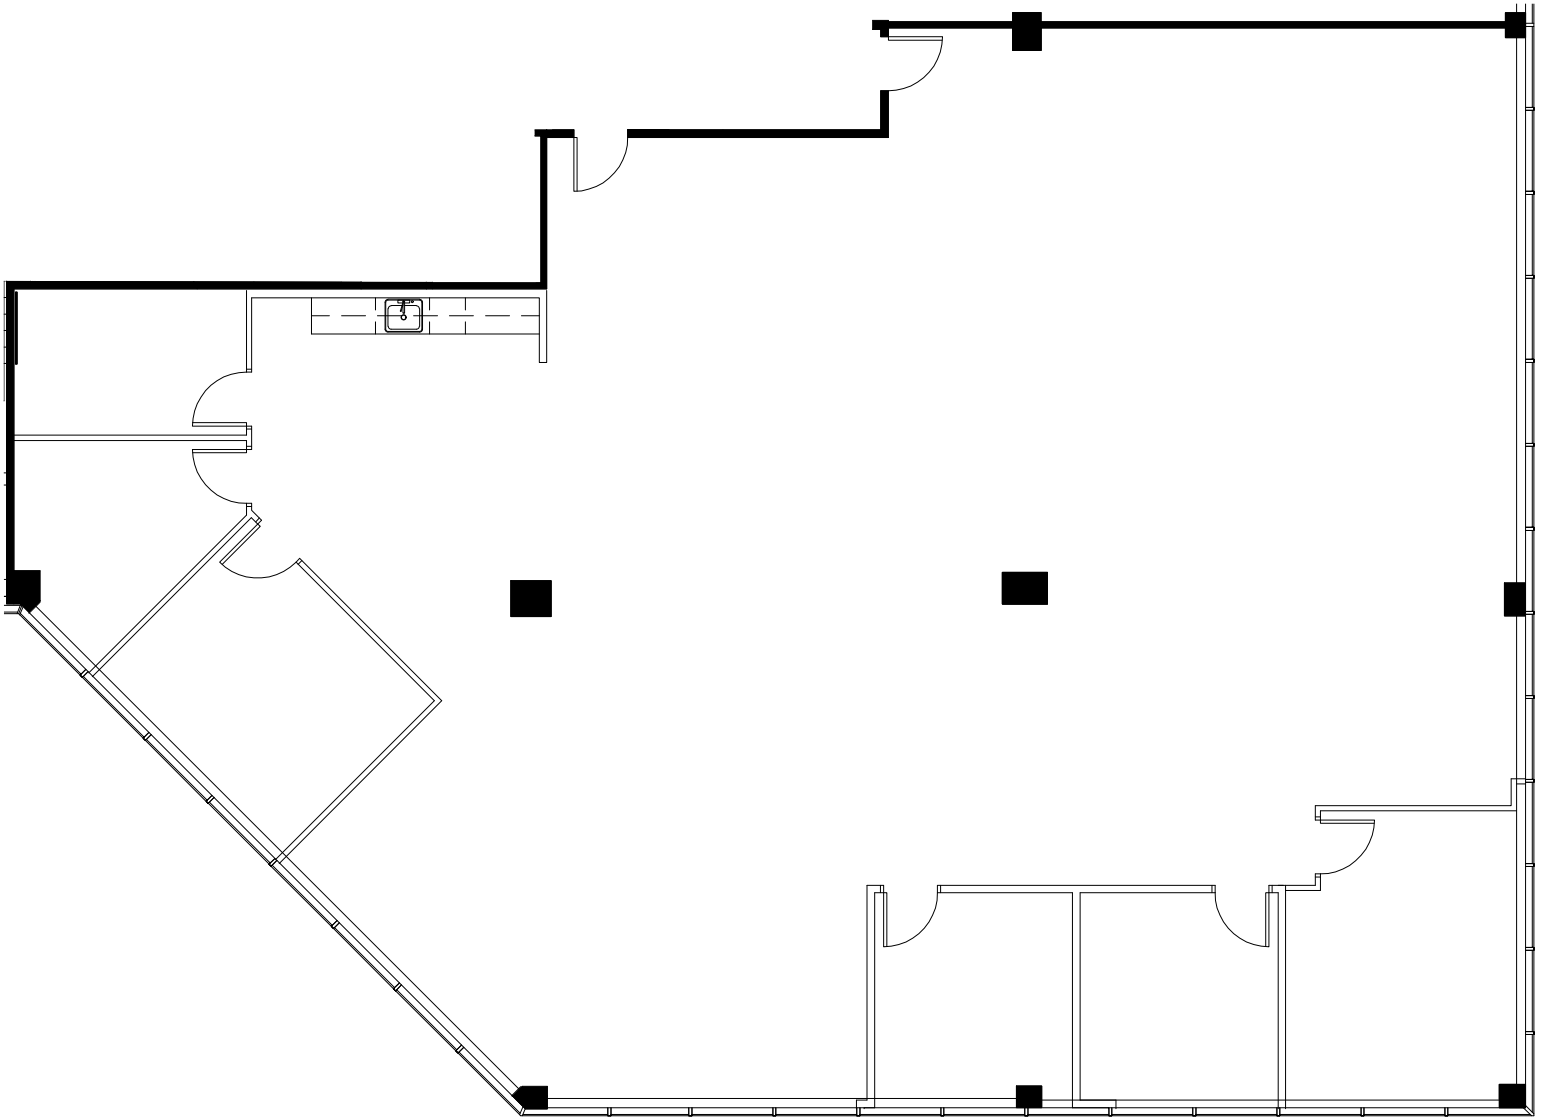

SMITH
HARRIS
DESIGN
associates