


# SHEA MEDICAL PLAZA

7425 E SHEA BLVD, SCOTTSDALE, AZ 85260

FOR LEASE

SUITE 101 - 8,174 SF

AS BUILT

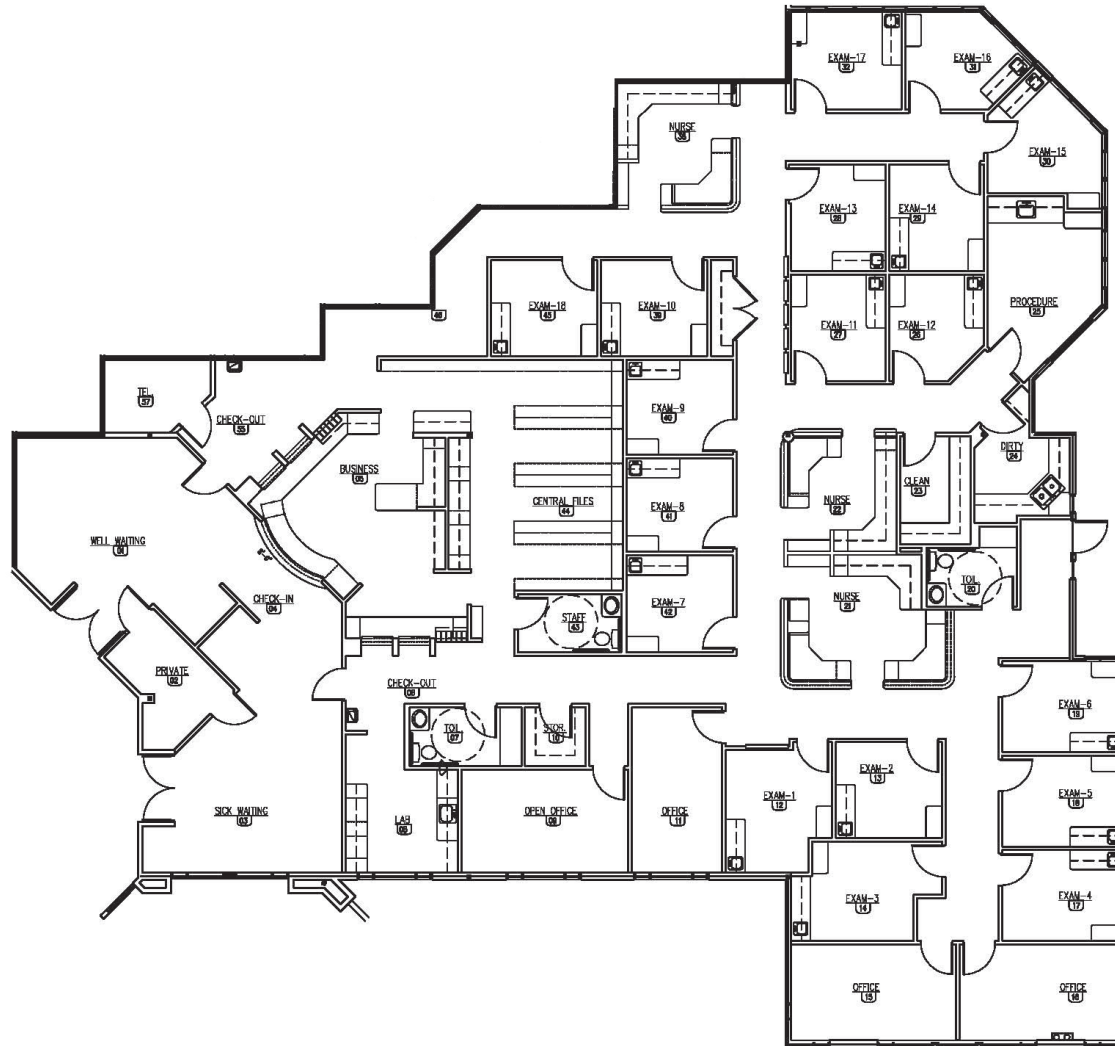

RACHAEL THOMPSON  
602.513.5122  
rachael.thompson@kidder.com

PERRY GABUZZI  
602.513.5116  
perry.gabuzzi@kidder.com

[kidder.com](http://kidder.com)

 **Kidder  
Mathews**