



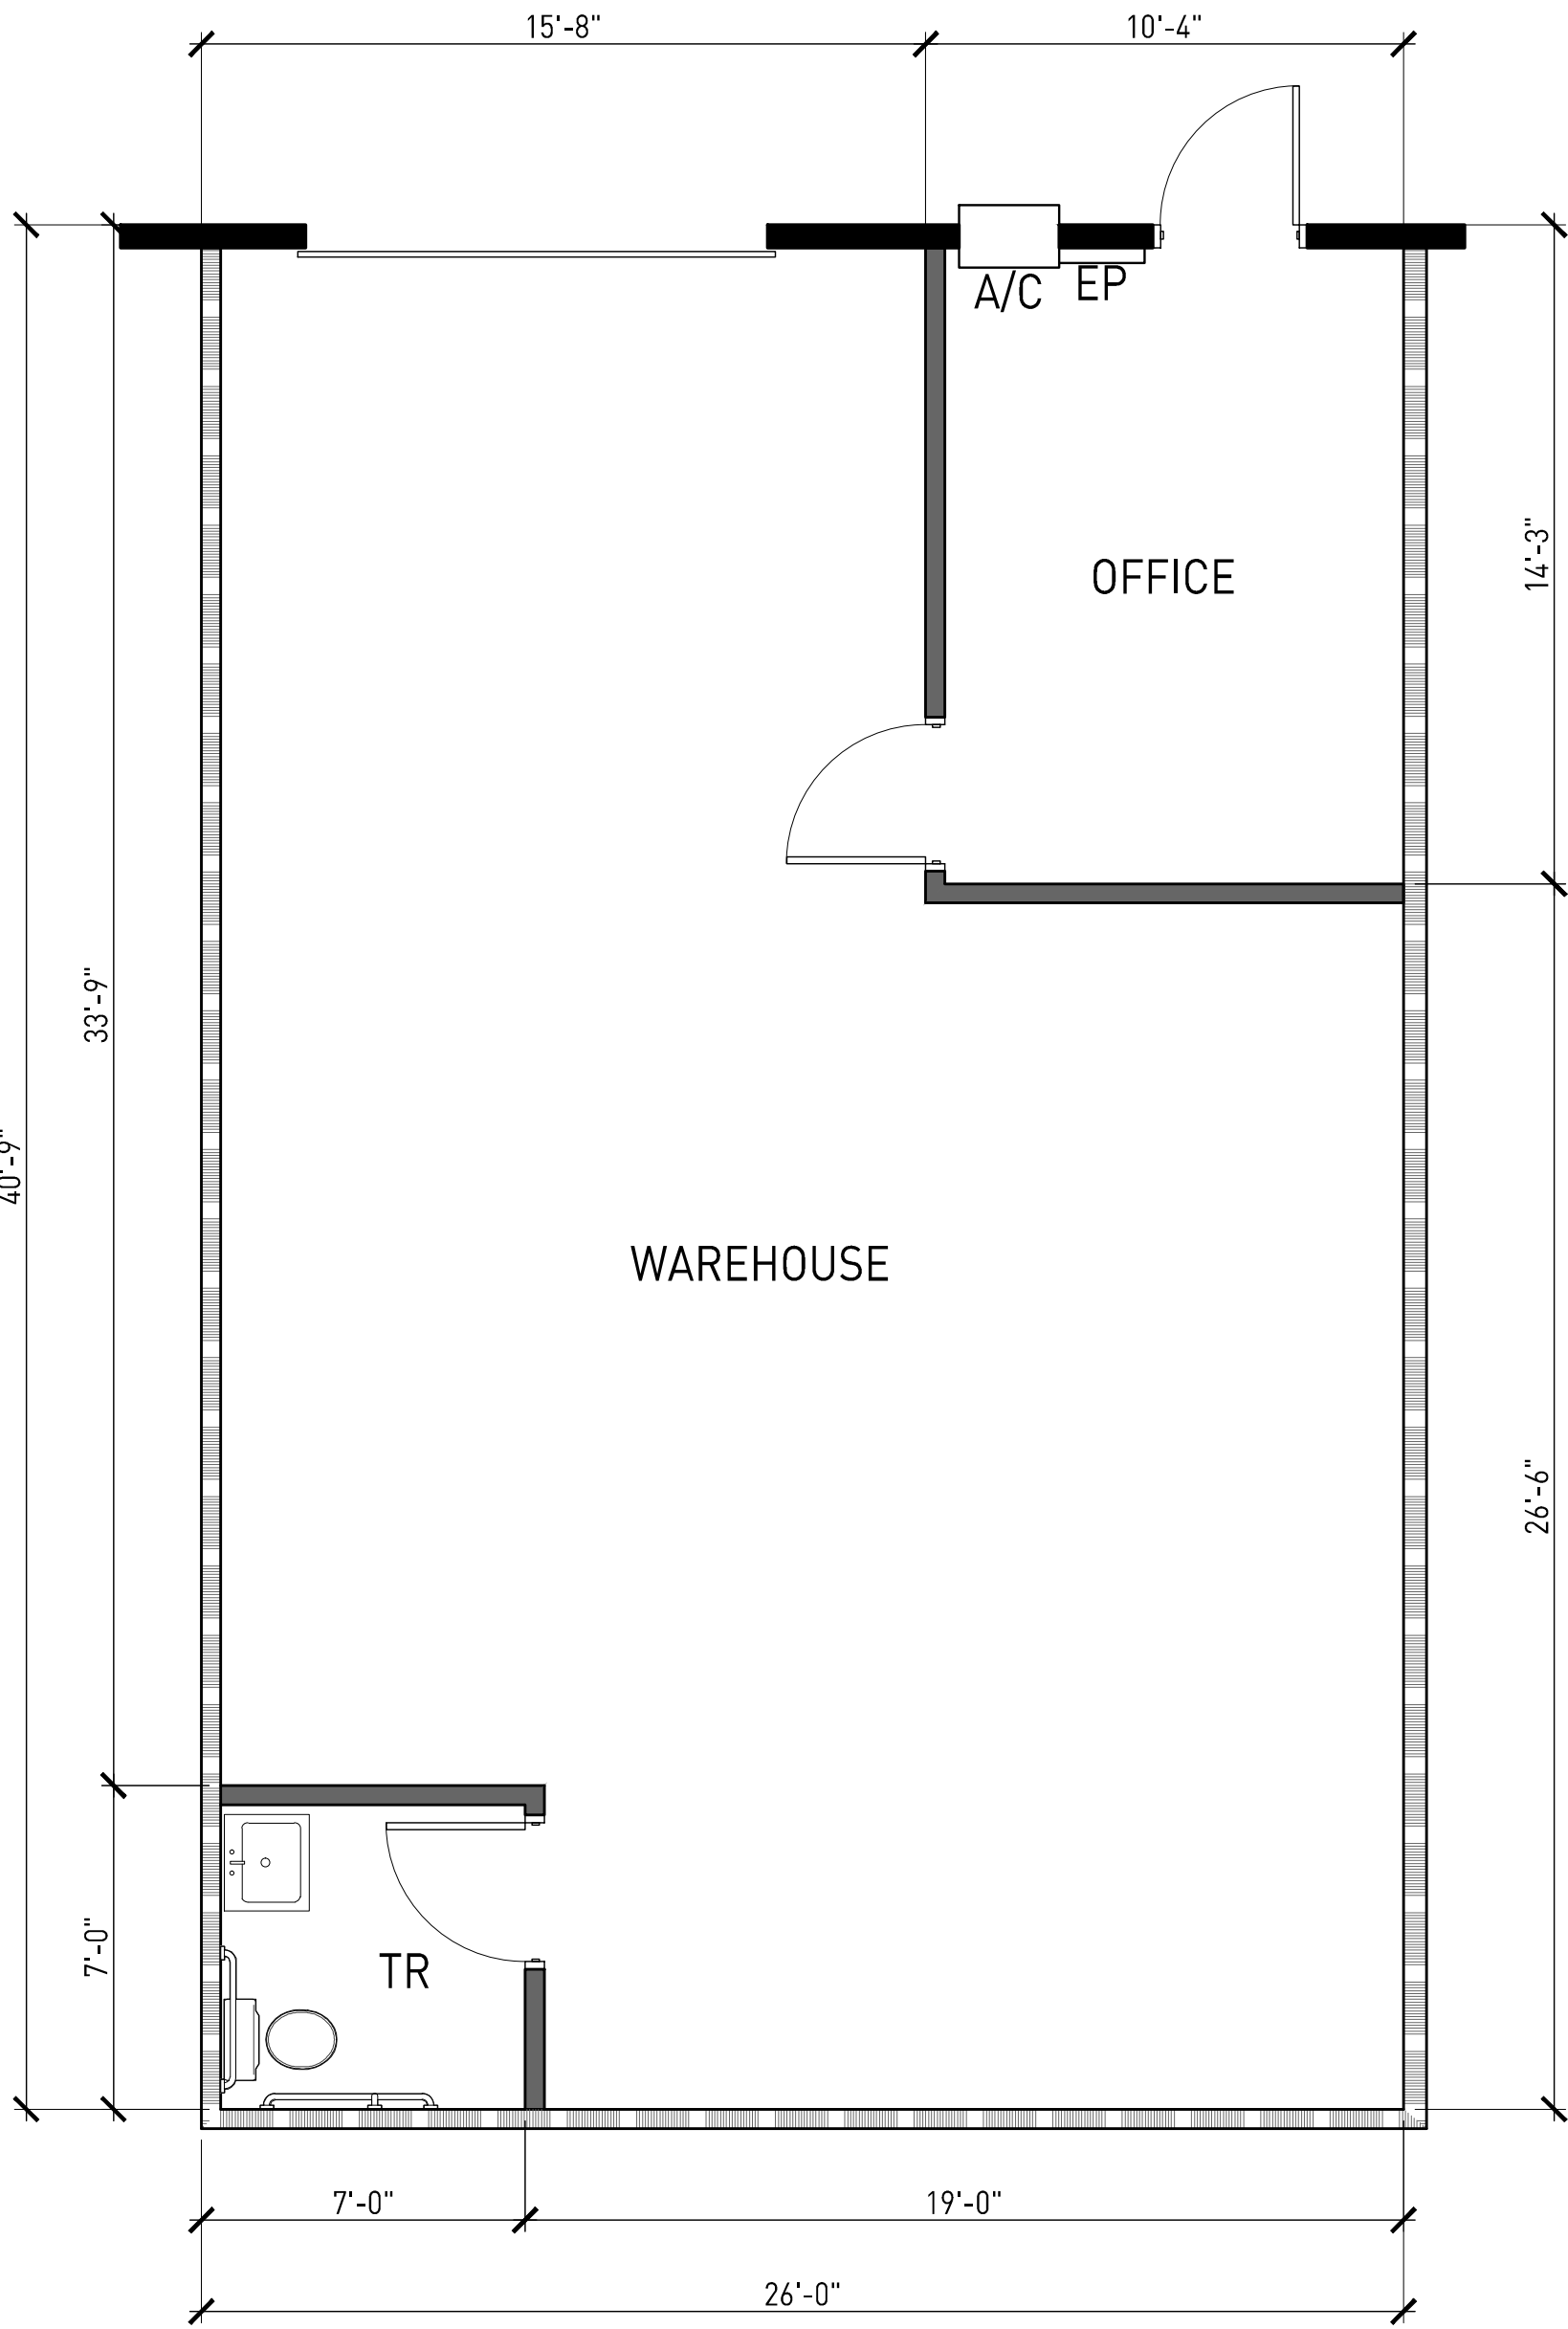

AS BUILT - 1,141 U.S.F.

SCALE: 1/4" = 1'-0"

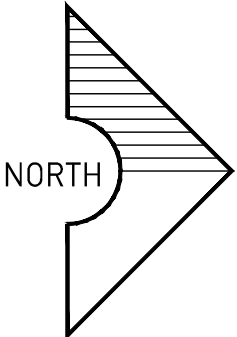

AS-BUILT  
LEVEL ONE

for  
EAST SAHARA COMMERCE CENTER  
SUITE 39  
4425 E. SAHARA AVE., LAS VEGAS, NV 89104

SEAL

| REVISIONS: |                 |    |
|------------|-----------------|----|
| NO.        | DATE / COMMENTS | BY |
|            |                 |    |
|            |                 |    |
DATE: 01.23.14  
PROJECT NO: 4600

DRAWN BY: K.H.  
CHECKED BY: D.H.

SHEET NUMBER

AI-1.0