


EASTSIDE CENTRE

740 East Campbell Road, Richardson, Texas

SUITES 340 & 360
8,135 RSF

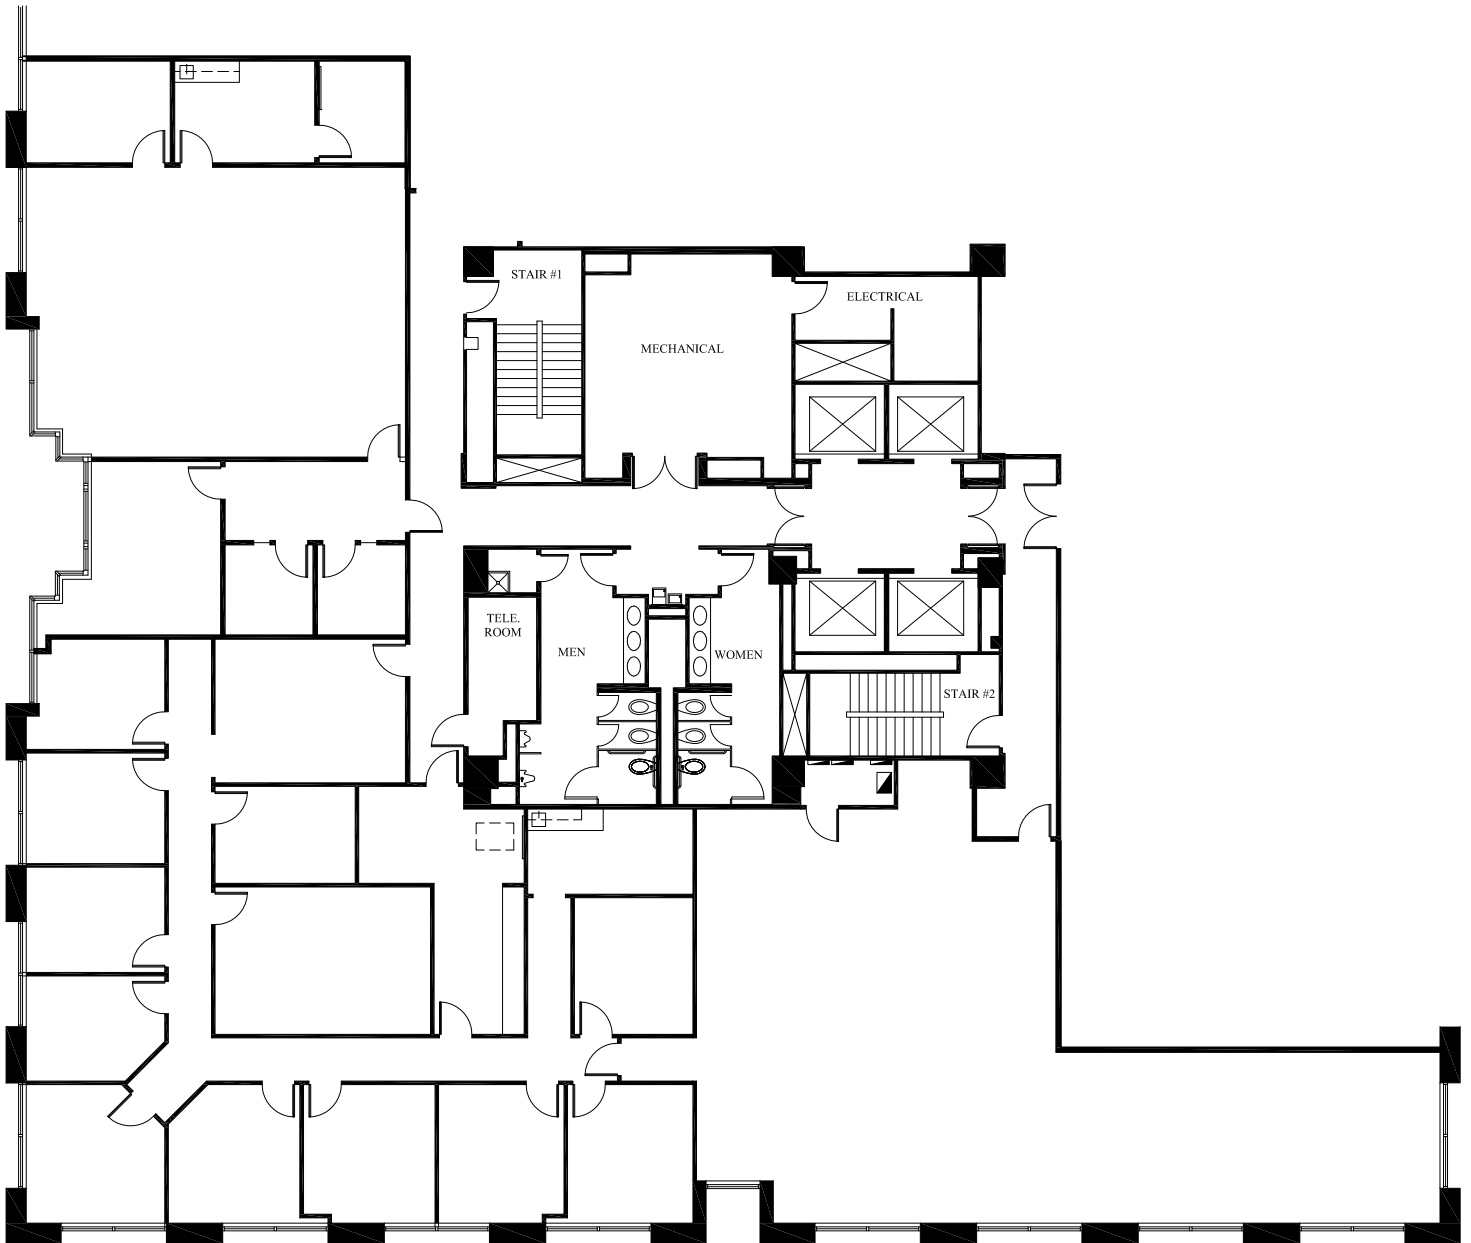

3RD FLOOR

Not to Scale

All dimensions and square footages are approximate.

February 29, 2024

