

5335 **THE OFFICES**
AT CHEVY CHASE PAVILION

Scott Fetterolf
202. 775. 7012
scott.fetterolf@transwestern.com

Collin Brown
202. 775. 7060
collin.brown@transwestern.com

Michael McGraw
202. 617. 2339
michael.mcgraw@transwestern.com


Transwestern

CLARION PARTNERS

SUITE 720

7TH FLOOR: 6,477 RSF

- As-Built Floor Plan
- Private Terrace overlooking Building Atrium

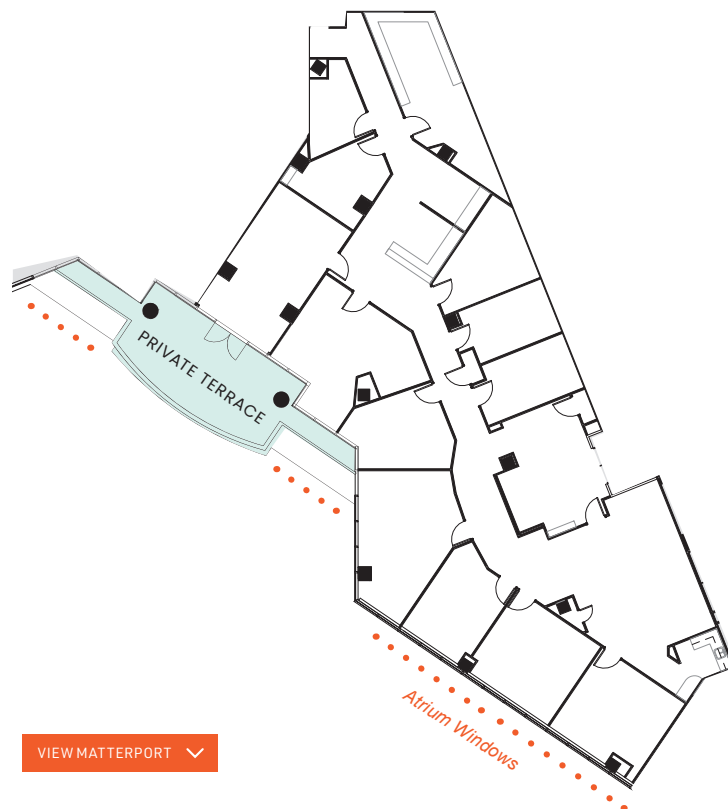

[VIEW MATTERPORT](#) ▼