


AHWATUKEE  
FOOTHILLS  
HEALTH CENTER

Floor 02

Suite 206  
AS-BUILT

2,752 SF  
AVAILABLE

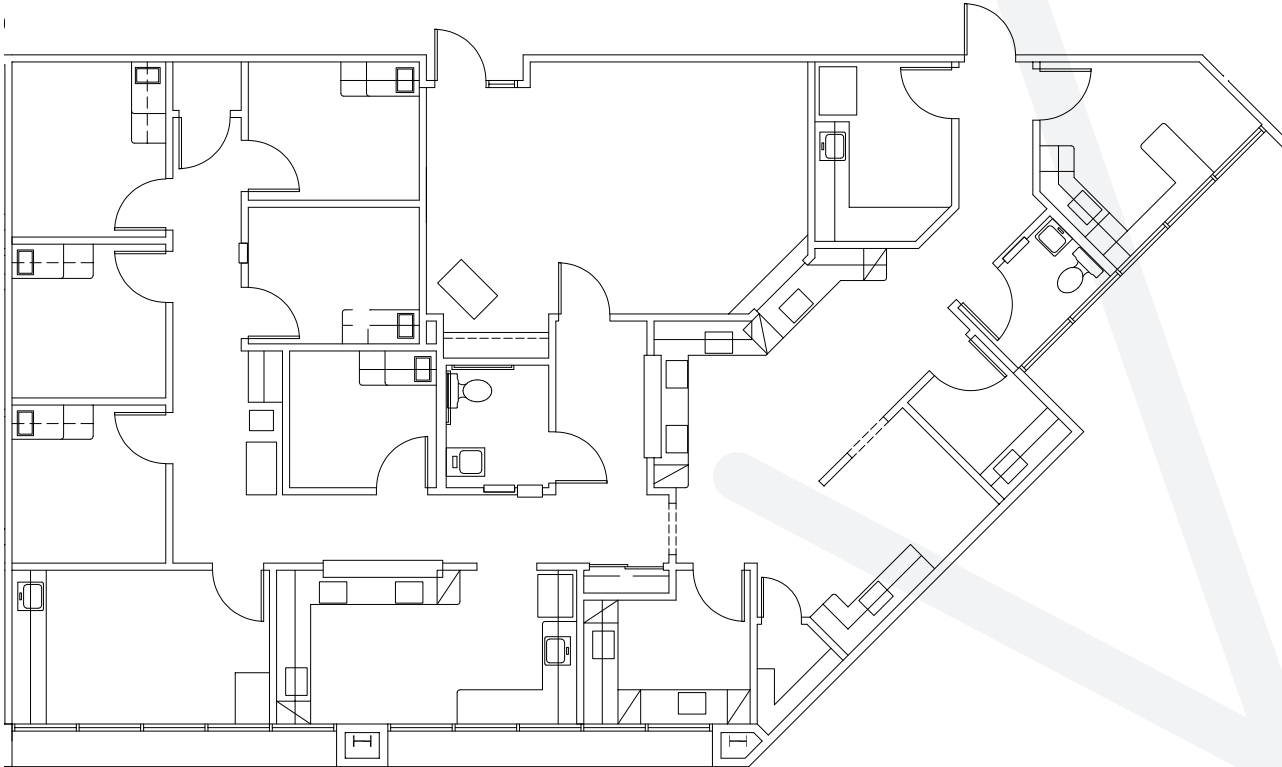

**RACHAEL THOMPSON**  
Senior Vice President  
602.513.5122  
rachael.thompson@kidder.com

**PERRY GABUZZI, CCIM**  
Executive Vice President  
602.513.5116  
perry.gabuzzi@kidder.com