


Usable Square Foot Analysis

OFFICE AREA:	488	49%
WAREHOUSE AREA:	511	51%
TOTAL AREA:	999	

Building Information

Deck Height:	12'0"
Clear Height:	10'0"
Ceiling Height:	7'10"
Sprinklered:	No
Mechanical Area:	N/A

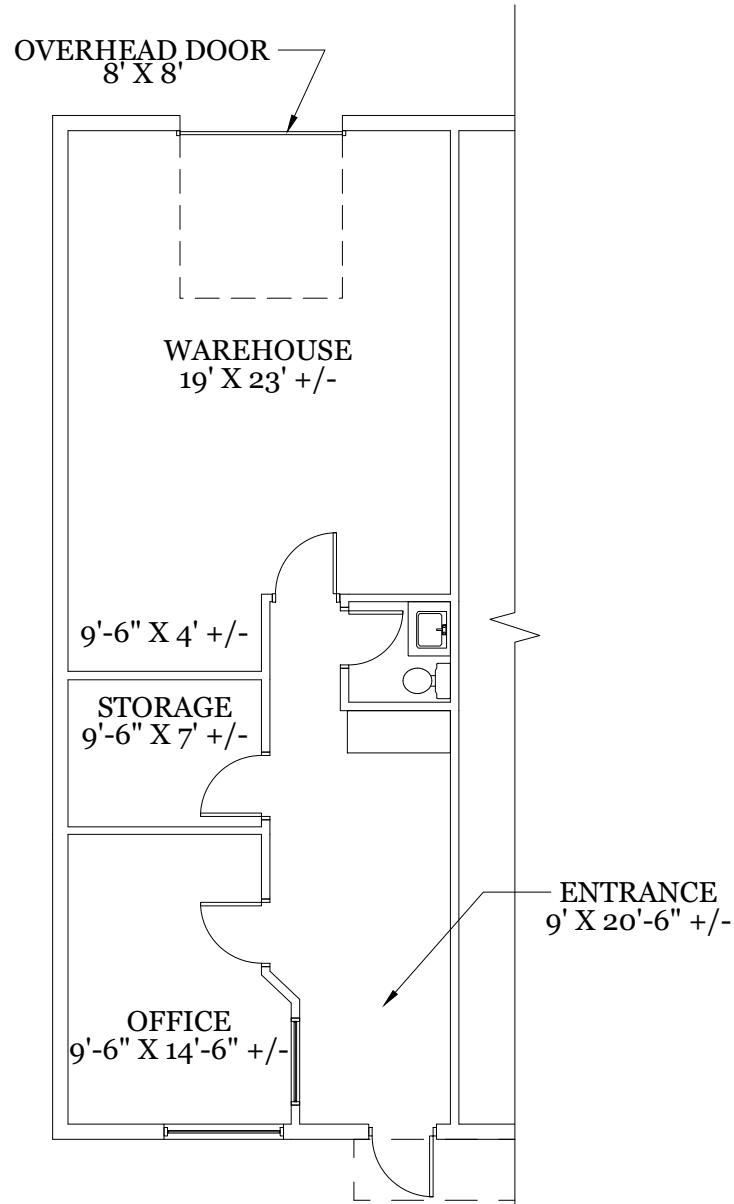

As Built Floor Plan for Marketing

