
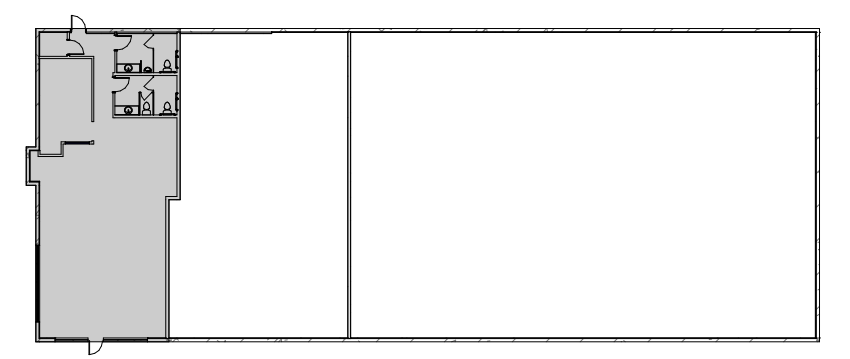


1 CICI'S PIZZA AS-BUILT PLAN  
1/4" = 1'-0"

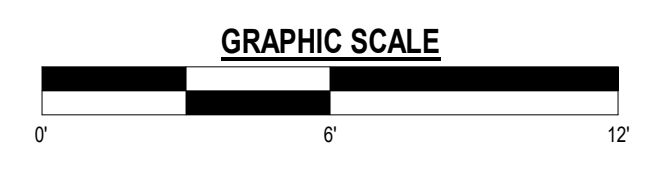

KEY PLAN

I HEREBY CERTIFY THAT THIS PLAN, SPECIFICATION, OR REPORT WAS PREPARED BY ME OR UNDER MY DIRECT SUPERVISION AND THAT I AM A LICENSED ARCHITECT UNDER THE LAWS OF THE STATE OF MINNESOTA.  
DAYA J. HLEBICHUK LIC# 44719  
-000000000-

DATE	REV	REVISION DESCRIPTION

DATE: <SHEET/ISSUE DATE>  
SCALE: AS NOTED  
DRAWN BY: <DRAWN BY>  
CHECKED BY: <CHECKED BY>  
JOB NUMBER: <PROJECT #>

221 28TH STREET ROCHESTER, MN  
AS-BUILT PLAN