

1 OVERALL BUILDING
 1/8" = 1'-0"


NOT TO SCALE

12.16.25



4210 WILL ROGERS PKWY
 OKLAHOMA CITY, OK 73108
 NORTH SUITE

TRINITY
 GROUP
 ARCHITECTS
 3030 N.W. EXPRESSWAY, SUITE 1450
 OKLAHOMA CITY, OKLAHOMA 73112
 405.947.7262

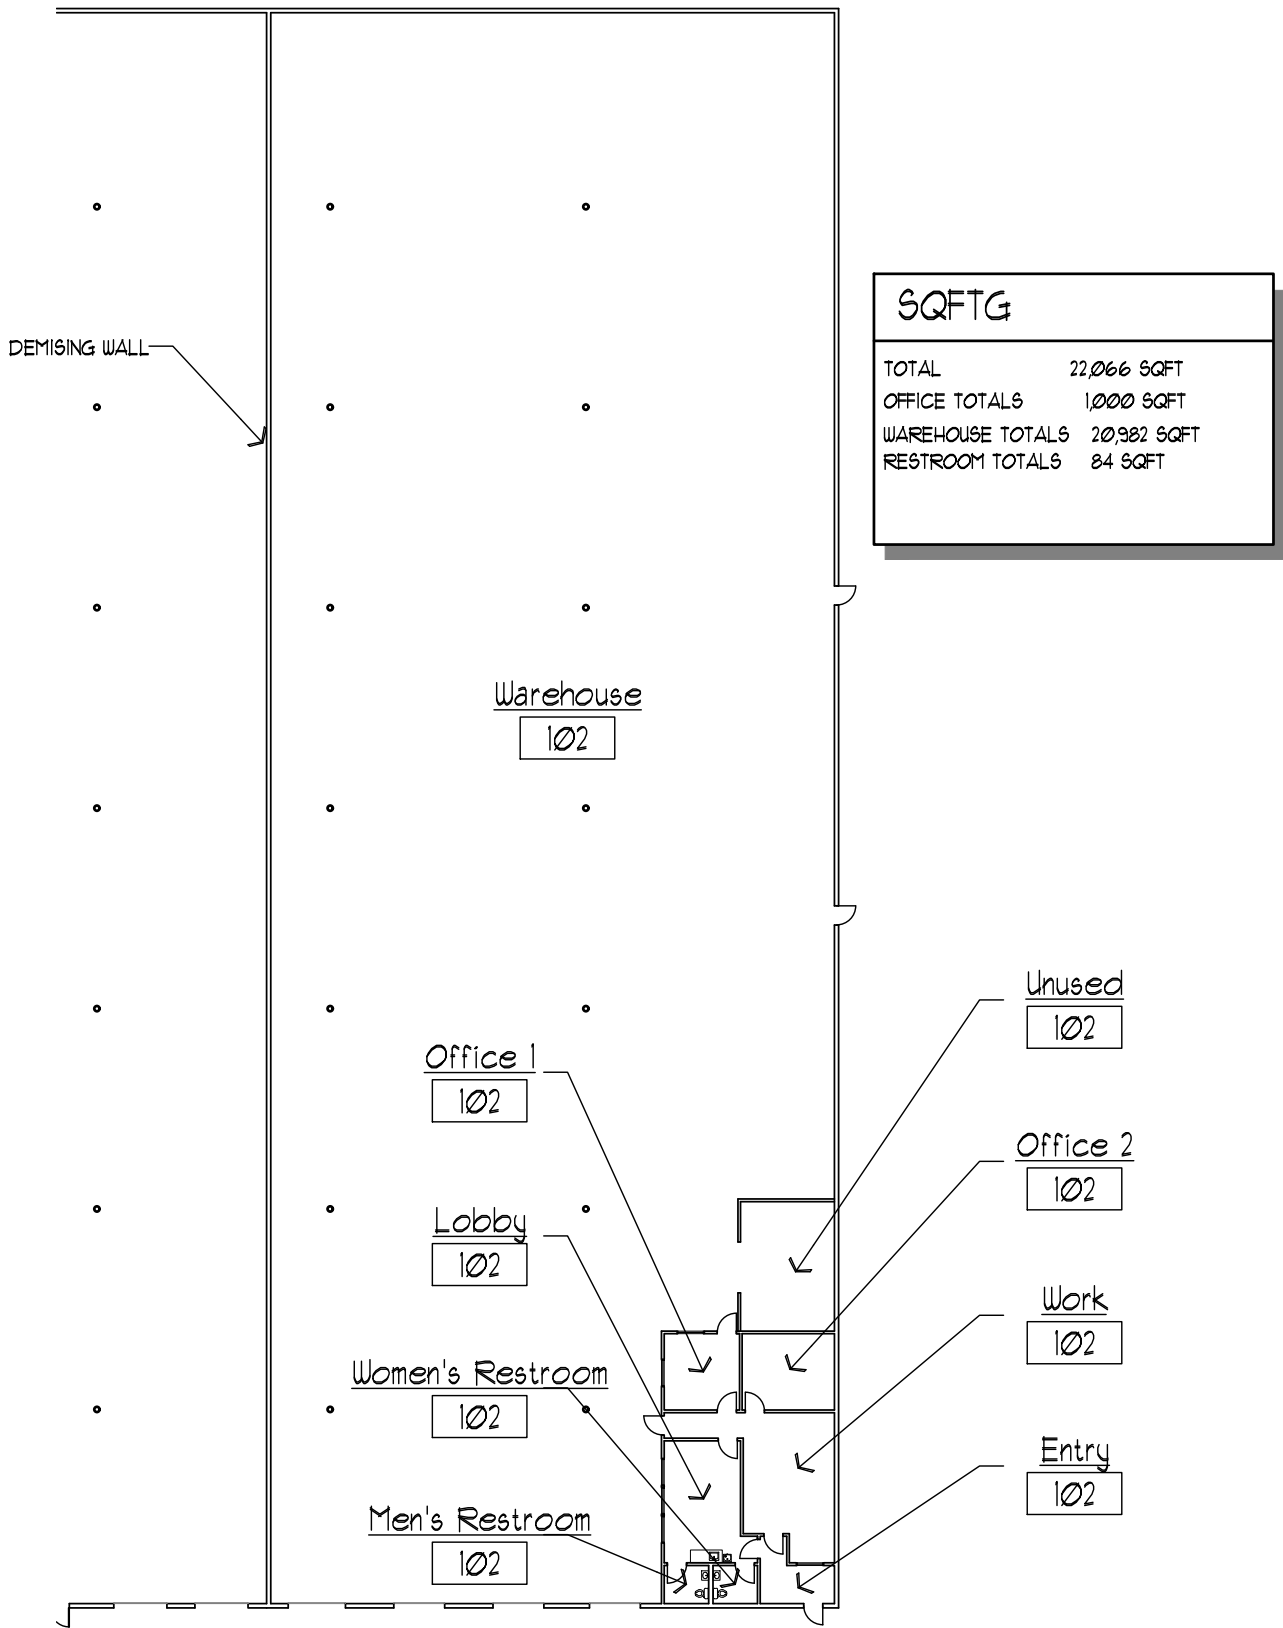


NOT TO SCALE

12.16.25




4210 WILL ROGERS PKWY
OKLAHOMA CITY, OK 73108
NORTH SUITE



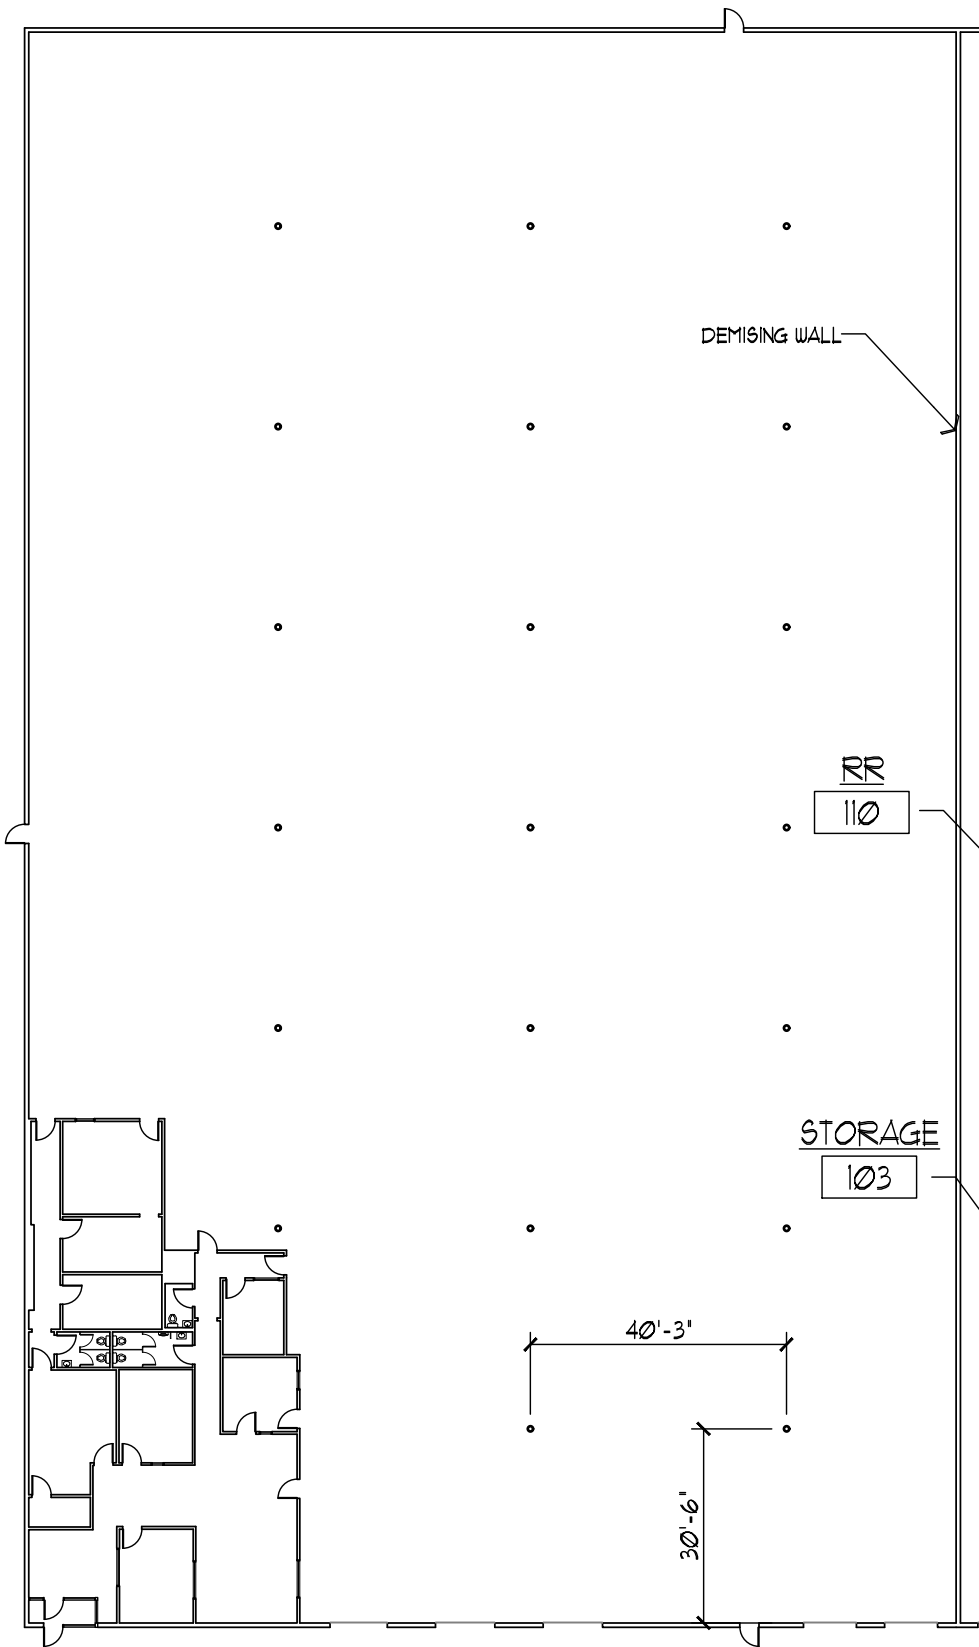

SQFTG	
TOTAL	36,520 SQFT
OFFICE TOTALS	2,901 SQFT
WAREHOUSE TOTALS	33,619 SQFT
RESTROOM TOTALS	145 SQFT

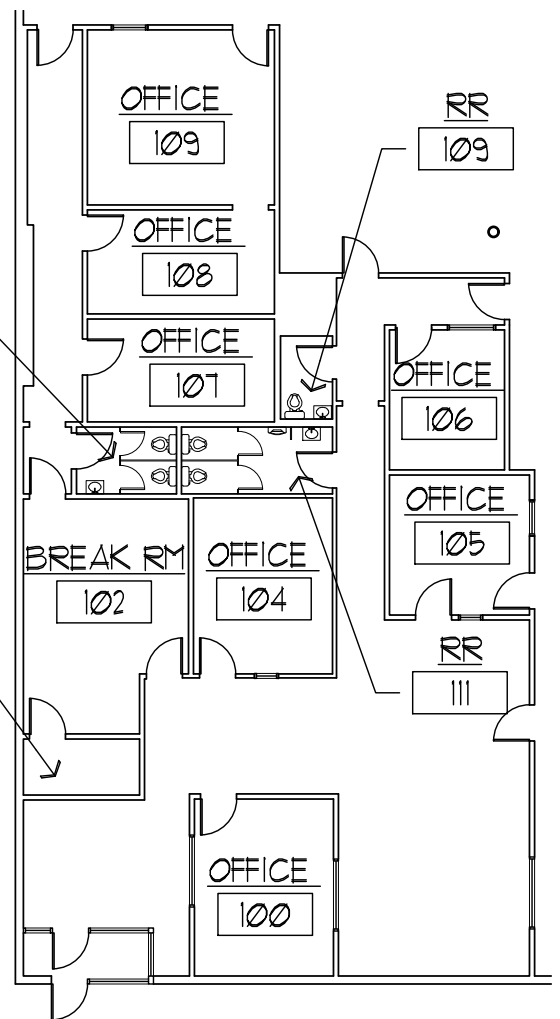

2 ENLARGED @ OFFICES
1/16" = 1'-0"

NOT TO SCALE

12.16.25



4210 WILL ROGERS PKWY
OKLAHOMA CITY, OK 73108
SOUTH SUITE

TRINITY
GROUP
ARCHITECTS
3030 N.W. EXPRESSWAY, SUITE 1450
OKLAHOMA CITY, OKLAHOMA 73112
405.947.7262