


**2** SECOND FLOOR PLAN  
SCALE: 1/4" = 1'-0"

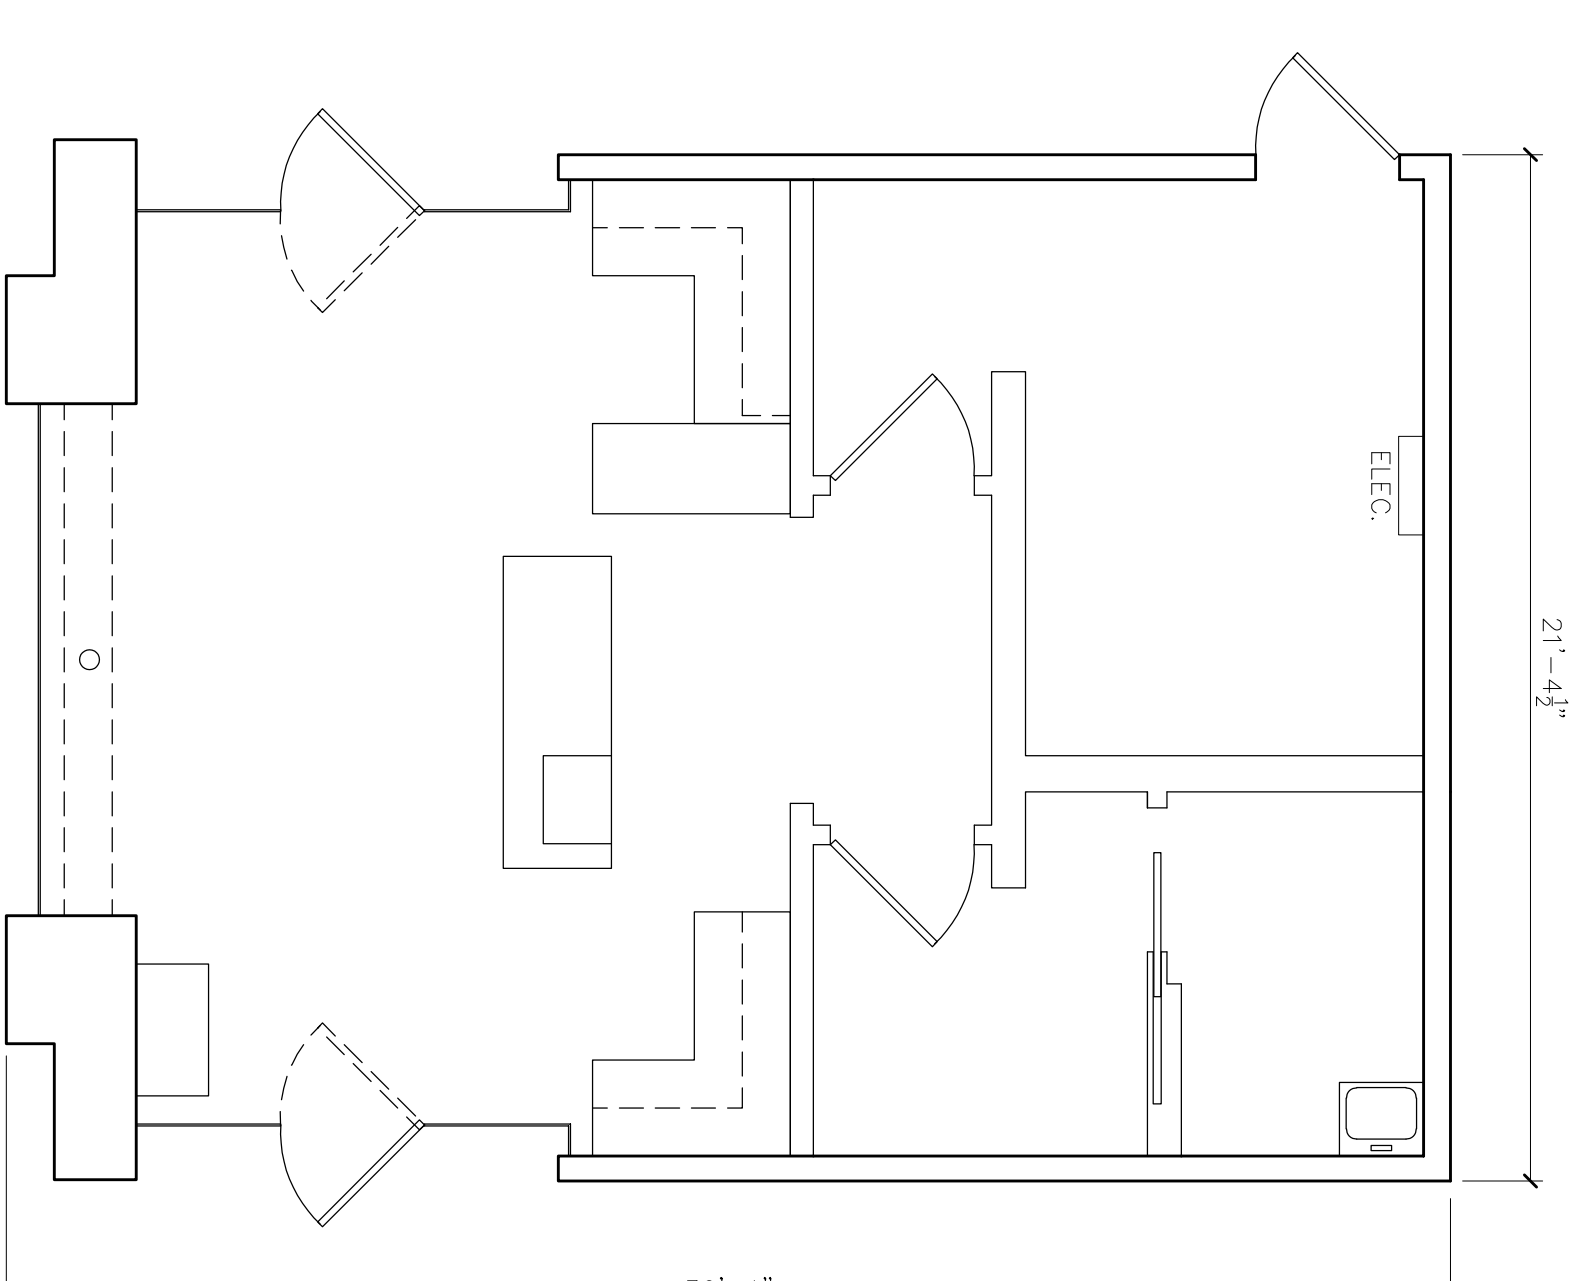

**1** FIRST FLOOR PLAN  
SCALE: 1/4" = 1'-0"

**VILLAGE PLACE**

5600 KIRBY DR  
HOUSTON, TX 77005

Project No. 25095  
Drawn SC  
Checked BS

AS-BUILT  
FLOOR PLANS  
Sheet No. A.0

**OSBORN & VANE ARCHITECTS, P.C.**

2000 Beving Drive, Suite 410  
Houston, TX 77057  
Phone 713.781.5282  
Fax 713.781.5247  
Members American Institute of Architects