


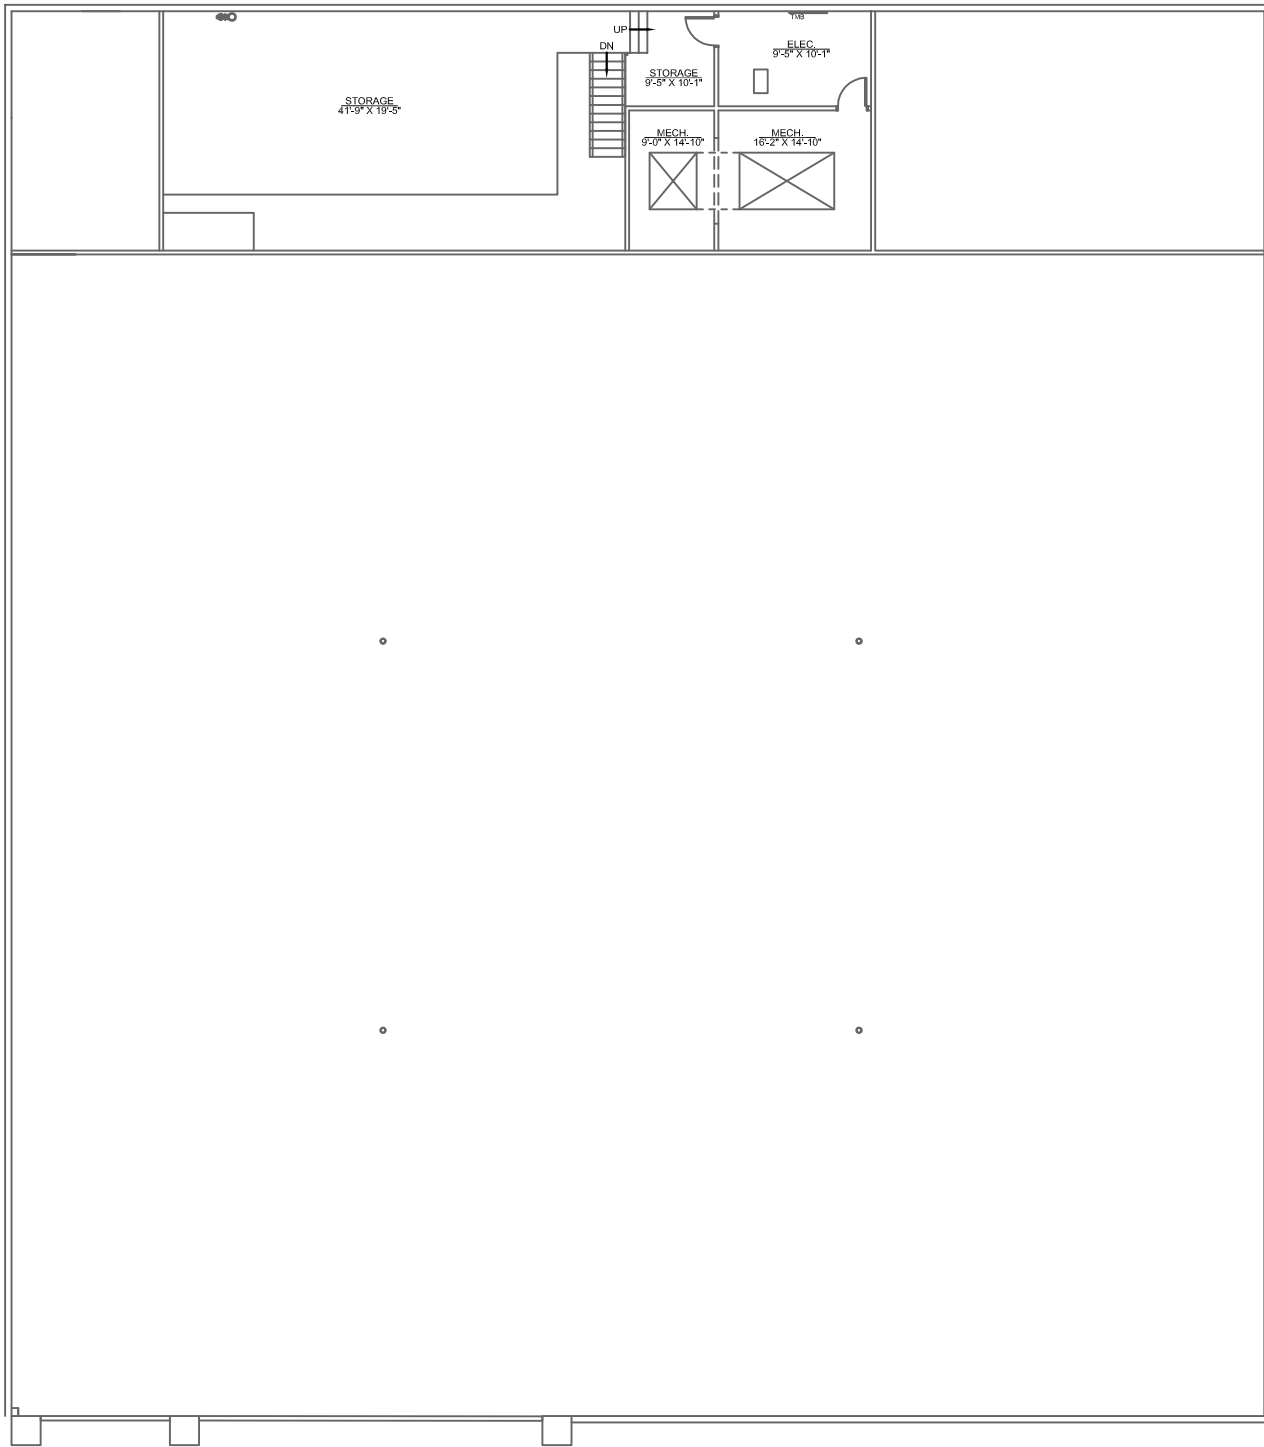


2ND FLOOR PLAN

1,500 SF



NTS

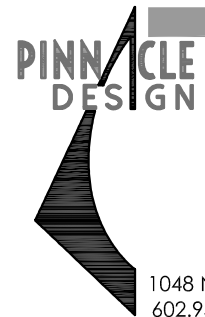

1048 N. 44th St. #200 Phoenix, AZ 85008
602.952.8585 www.pdi-az.com

3 WISHES

3216 E CACTUS ROAD, PHOENIX AZ

SECOND FLOOR PLAN

2512.00

4.1.25

**PRELIMINARY
NOT FOR
CONSTRUCTION
AS-BUILT**

COPYRIGHT PINNACLE DESIGN, INC. 2025