


PORT ROYALE FINANCIAL CENTER

6550 NORTH FEDERAL HIGHWAY
FORT LAUDERDALE, FL 33308

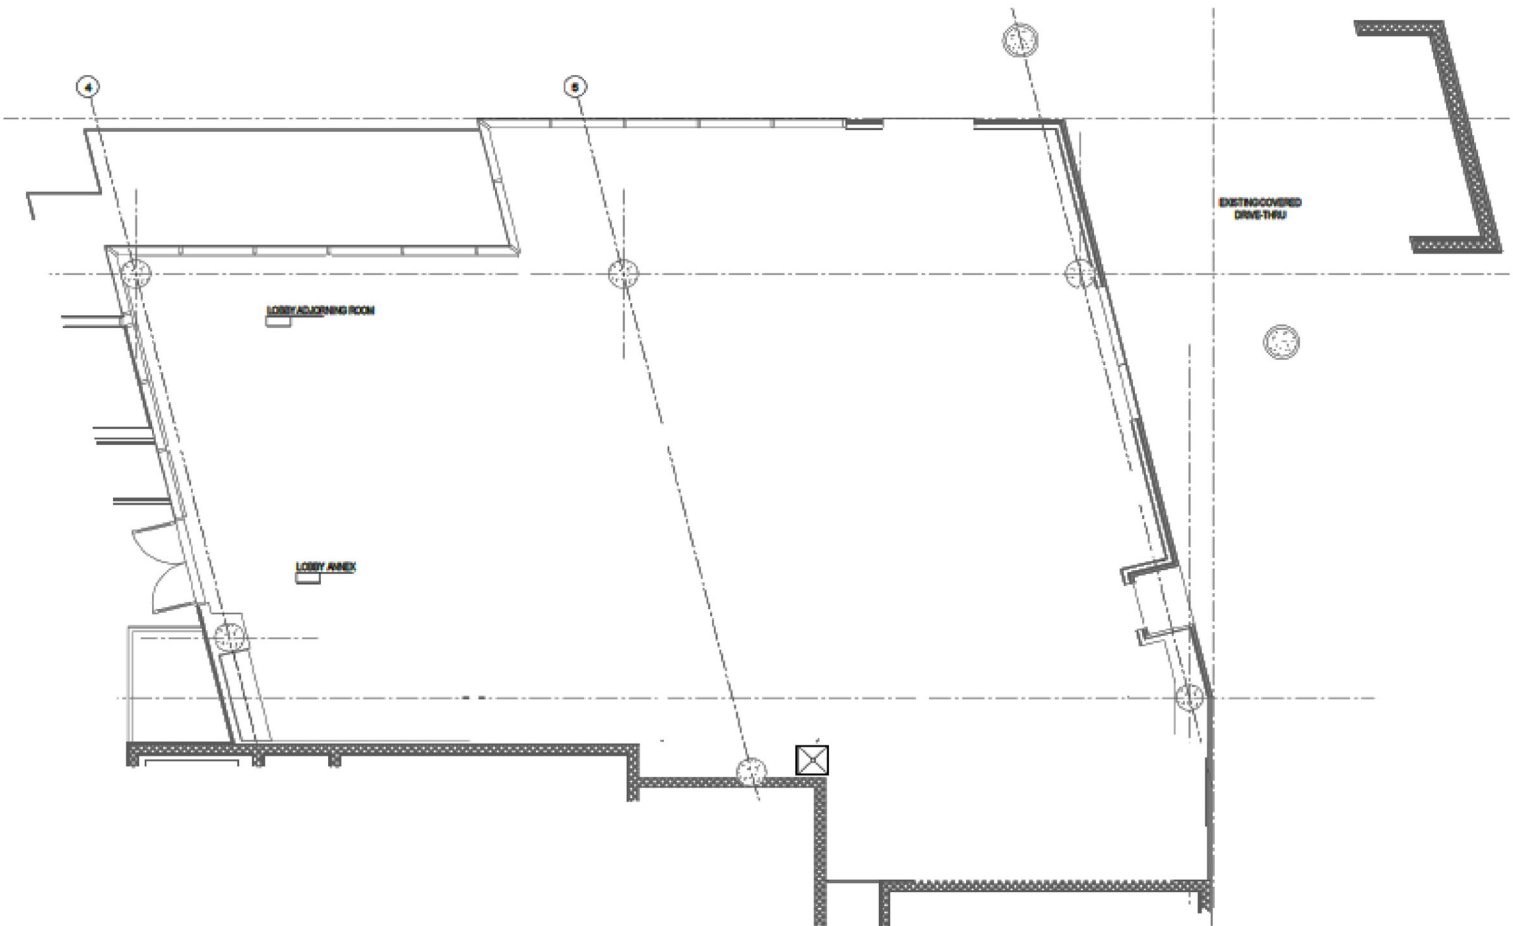

As-Built - Suite 100: 3,684 SF



For more information, please contact:

Beau Ladwig
M +1 954 552 3883
beau.ladwig@cbre.com

Joe Freitas
M +1 561 512 8844
joe.frietas@cbre.com

Nick Mulligan
M +1 561 393 1680
nicholas.mulligan@cbre.com

