

BOSWELL WEST MEDICAL OFFICE BUILDING

10503 W THUNDERBIRD BLVD | SUN CITY, AZ 85351


Floor 02

Suite 220

AS-BUILT

5,318 SF

AVAILABLE

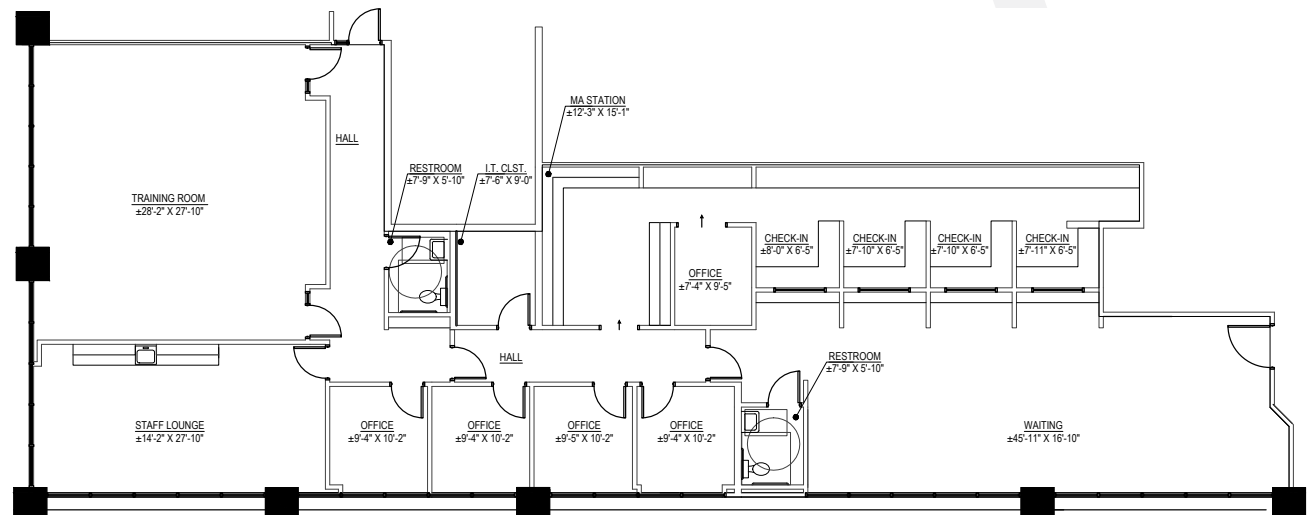

RACHAEL THOMPSON
Senior Vice President
602.513.5122
rachael.thompson@kidder.com

PERRY GABUZZI, CCIM
Senior Vice President
602.513.5116
perry.gabuzzi@kidder.com



View Portfolio

km Kidder
Mathews