



## 3955 Vantech Drive-Bldg C

Memphis, Tennessee 38115

### Property Features

- Suite 5: 10,677 SF Available For Lease
- Air Conditioned Warehouse
- Mix of Office and Warehouse
- Multiple Docks and Drive-In Doors
- First-floor Private Entry
- Security Patrol
- Gated Entry on Nights and Weekends with Security Card
- Conveniently located near I-240, I-385, Hwy 78 and Memphis International Airport





For more information:

**Brian Califf, CCIM**

901 526 3100 • [bcaliff@saigcompany.com](mailto:bcaliff@saigcompany.com)

For Lease

# Flex

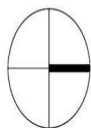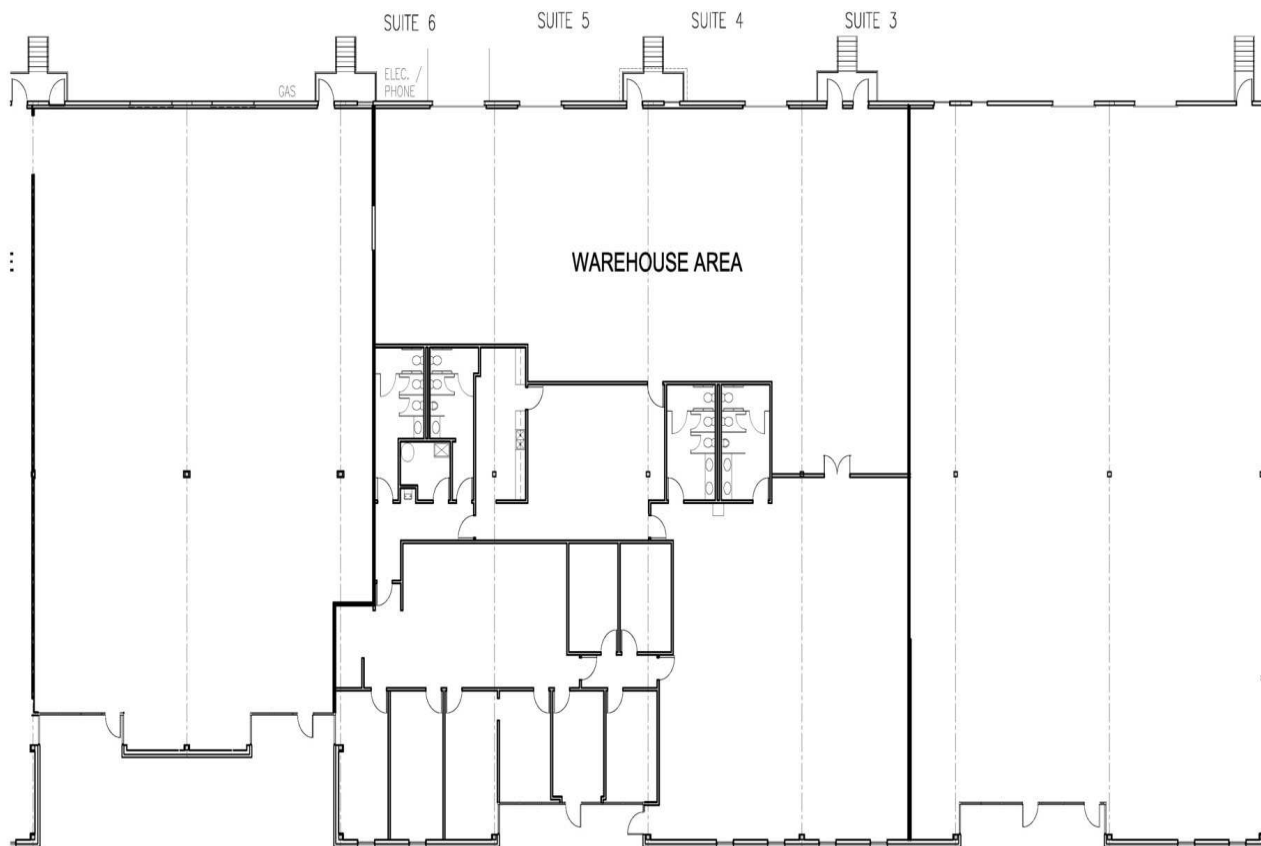

### BUILDING 'C' PARTIAL AS BUILT FLOOR PLAN

SCALE: 1/16" = 1'-0"



0 5' 10' 25' 50'

SUITES 3 thru 6: 10,677 SF