

OFFICE BUILDING FOR SALE OR LEASE

760 INDEPENDENCE BOULEVARD

VIRGINIA BEACH, VA 23455



Brokerage with vision. Real estate with results.

Presented By:

John Katsias

President

757.490.3585

jk@katsias.com

Haven Spirelis

Vice President

757.748.8448

Haven@katsias.com

760 INDEPENDENCE BOULEVARD

VIRGINIA BEACH, VA 23455

EXECUTIVE SUMMARY



OFFERING SUMMARY

Sale Price: \$1,800,000


Lease Rate: Negotiable

Available SF: Approx. 2,866 SF

Building Size: 5,937 SF (0.353 Ac)

PROPERTY HIGHLIGHTS

- Currently a Podiatrist office occupying approximately. 3,510 SF
- Located adjacent to Sentara Independence
- Strategically located between Town center & Haygood areas
- Highly visible from Independence Blvd
- Former physical therapy space available
- Prime digital monument signage
- Ample Parking w/ access off Independence & N. Witchduck

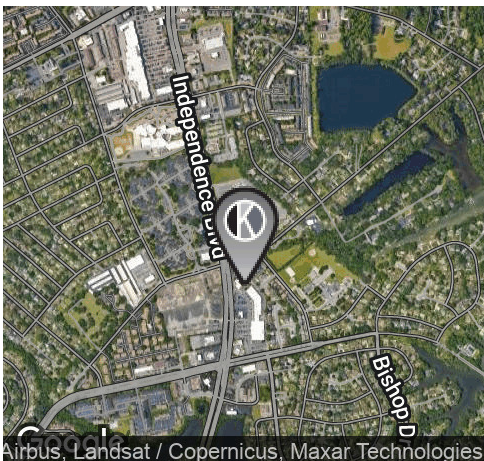

DEMOGRAPHICS	1 Mile	3 Miles	5 Miles
Total Households:	4,612	44,380	97,005
Total Population:	11,596	109,479	240,074
Average HH Income:	\$105,039	\$103,376	\$103,648



Presented By:

John Katsias | President
757.490.3585
jk@katsias.com


Haven Spirelis | Vice President
757.748.8448
Haven@katsias.com

3720 Virginia Beach Blvd suite 200, Virginia Beach, VA 23452 | 757.490.3585 | www.katsias.com

760 INDEPENDENCE BOULEVARD

VIRGINIA BEACH, VA 23455

SITE PLANS

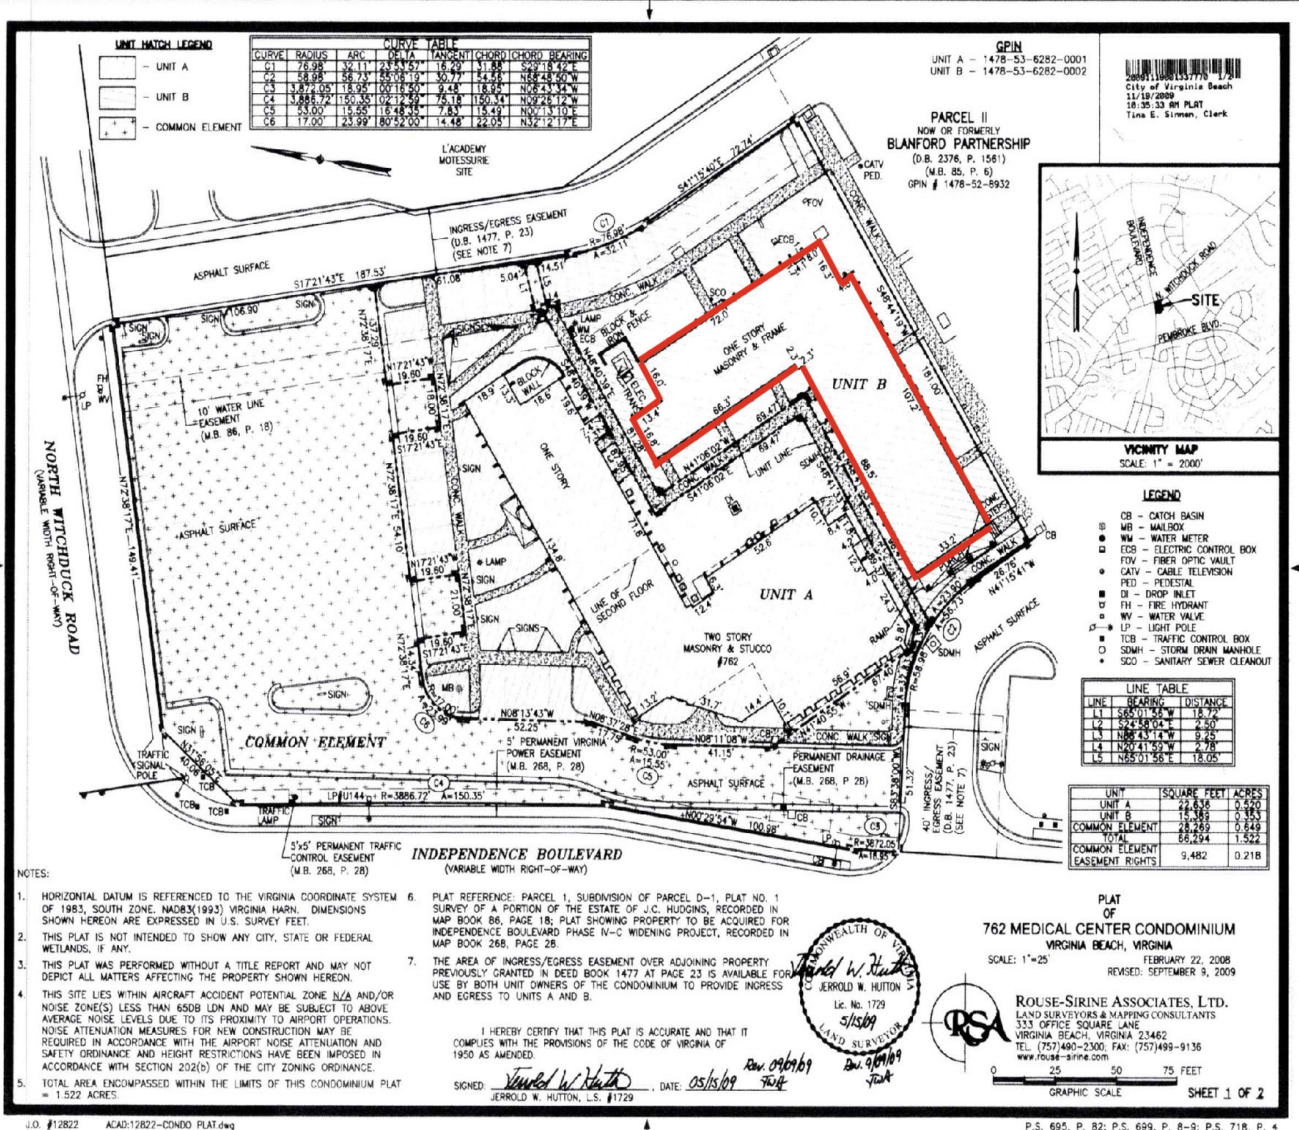

The KATSIAS COMPANY
Brokerage with vision. Real estate with results.

Presented By:
John Katsias | President 757.490.3585 jk@katsias.com
Haven Spirelis | Vice President 757.748.8448 Haven@katsias.com

3720 Virginia Beach Blvd suite 200, Virginia Beach, VA 23452 | 757.490.3585 | www.katsias.com


We have in preparing this information used our best endeavors to ensure that the information contained herein in true and accurate, but accept no responsibility and disclaim all liability in respect of any errors, inaccuracies or misstatements contained herein. Prospective purchasers and/or lessors should make their own inquiries to verify the information contained herein.

OFFICE BUILDING FOR SALE OR LEASE

760 INDEPENDENCE BOULEVARD

VIRGINIA BEACH, VA 23455

FLOOR PLAN

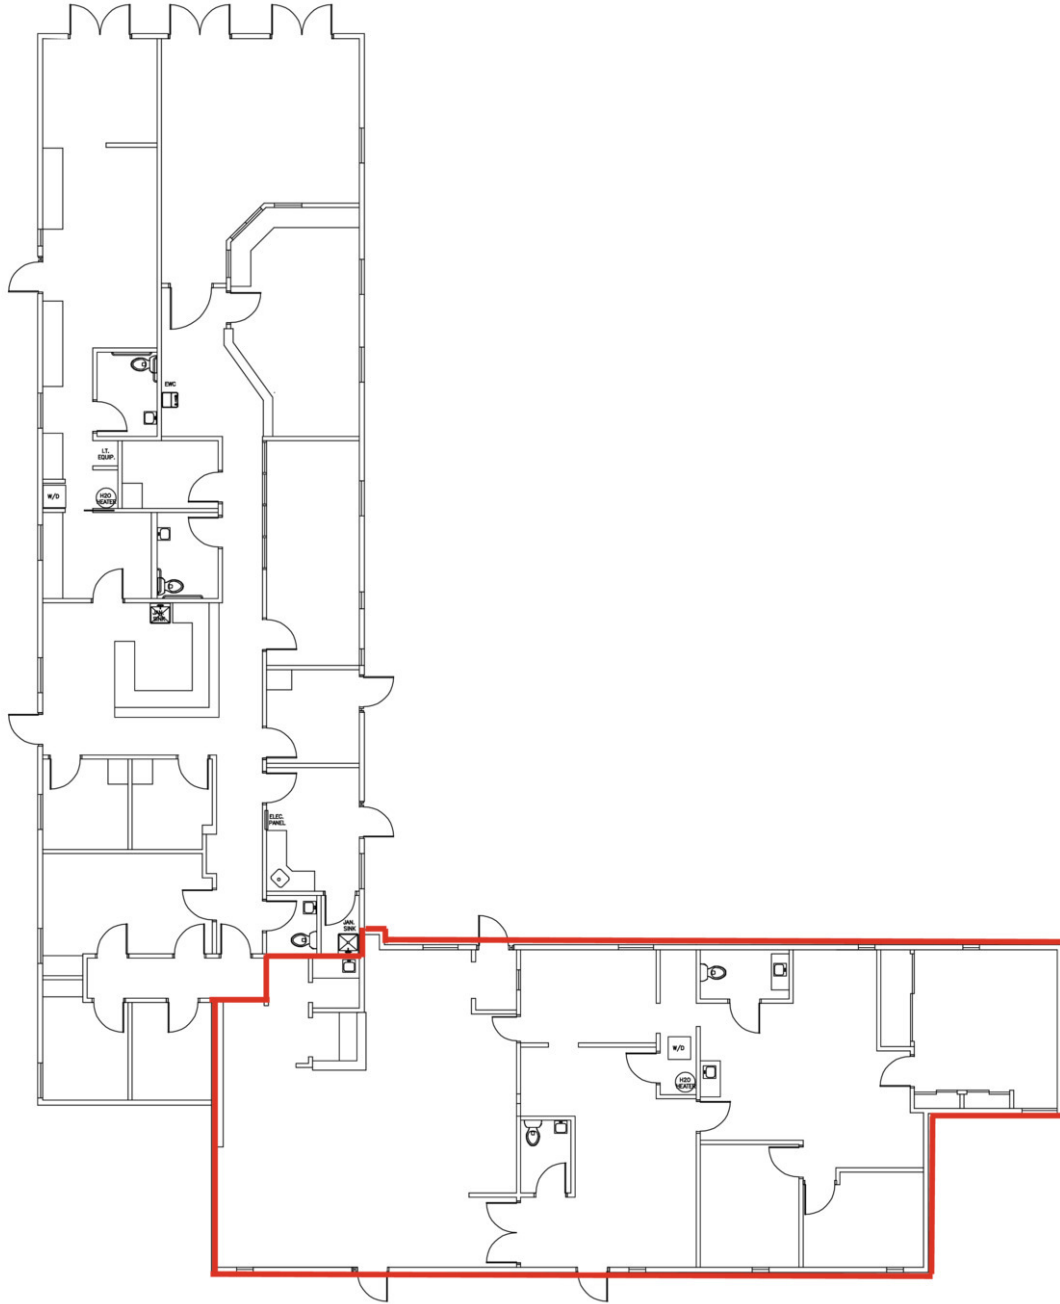

AS-BUILT DRAWING

760 INDEPENDENCE BOULEVARD
VIRGINIA BEACH, VIRGINIA 23451

5,937 SF



Brokerage with vision. Real estate with results.

Presented By:

John Katsias | President

757.490.3585

jk@katsias.com

Haven Spirelis | Vice President

757.748.8448

Haven@katsias.com

3720 Virginia Beach Blvd suite 200, Virginia Beach, VA 23452 | 757.490.3585 | www.katsias.com


We have in preparing this information used our best endeavors to ensure that the information contained herein in true and accurate, but accept no responsibility and disclaim all liability in respect of any errors, inaccuracies or misstatements contained herein. Prospective purchasers and/or lessors should make their own inquiries to verify the information contained herein.

OFFICE BUILDING FOR SALE OR LEASE

760 INDEPENDENCE BOULEVARD

VIRGINIA BEACH, VA 23455

RETAILER MAP

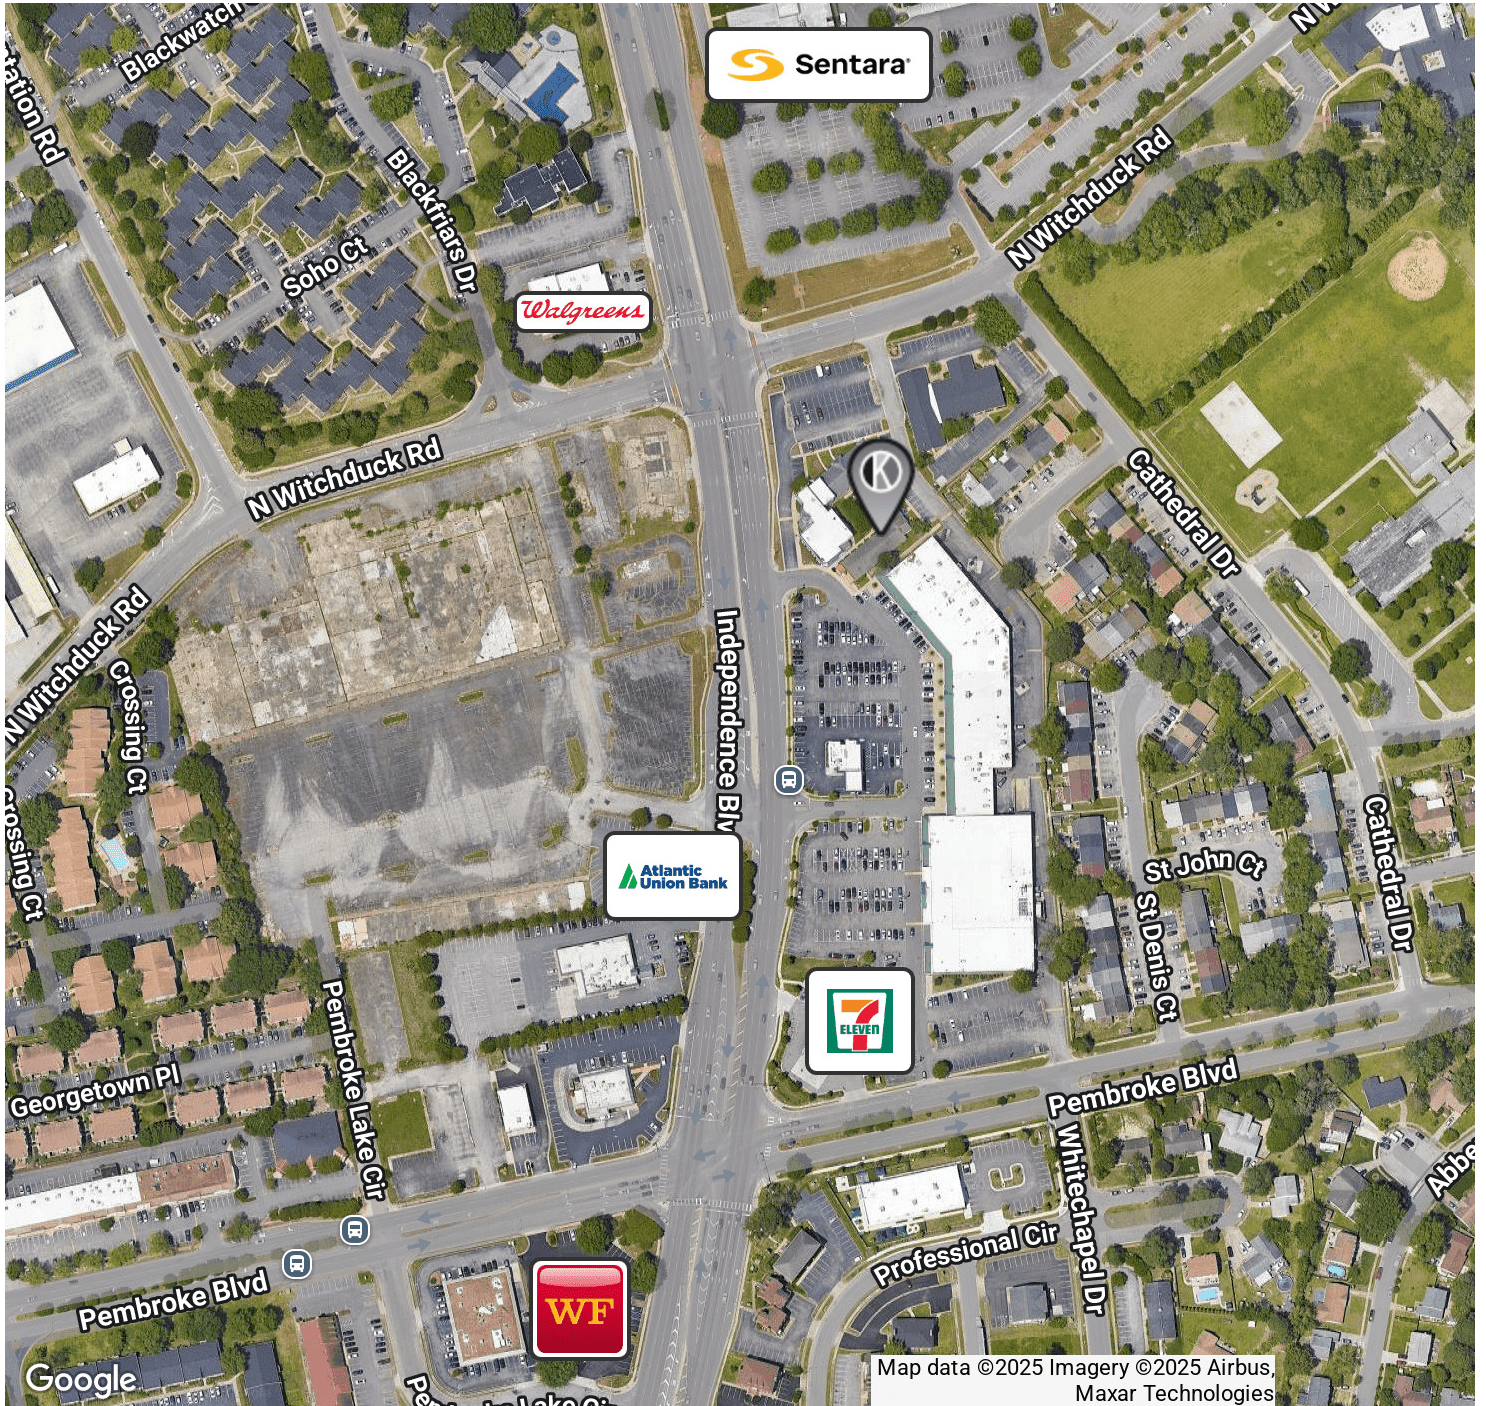

 **The KATSIAS**
COMPANY
Brokerage with vision. Real estate with results.

Presented By:

John Katsias | President
757.490.3585
jk@katsias.com

Haven Spirelis | Vice President
757.748.8448
Haven@katsias.com

3720 Virginia Beach Blvd suite 200, Virginia Beach, VA 23452 | 757.490.3585 | www.katsias.com


We have in preparing this information used our best endeavors to ensure that the information contained herein in true and accurate, but accept no responsibility and disclaim all liability in respect of any errors, inaccuracies or misstatements contained herein. Prospective purchasers and/or lessors should make their own inquiries to verify the information contained herein.

OFFICE BUILDING FOR SALE OR LEASE

760 INDEPENDENCE BOULEVARD

VIRGINIA BEACH, VA 23455

RETAILER MAP

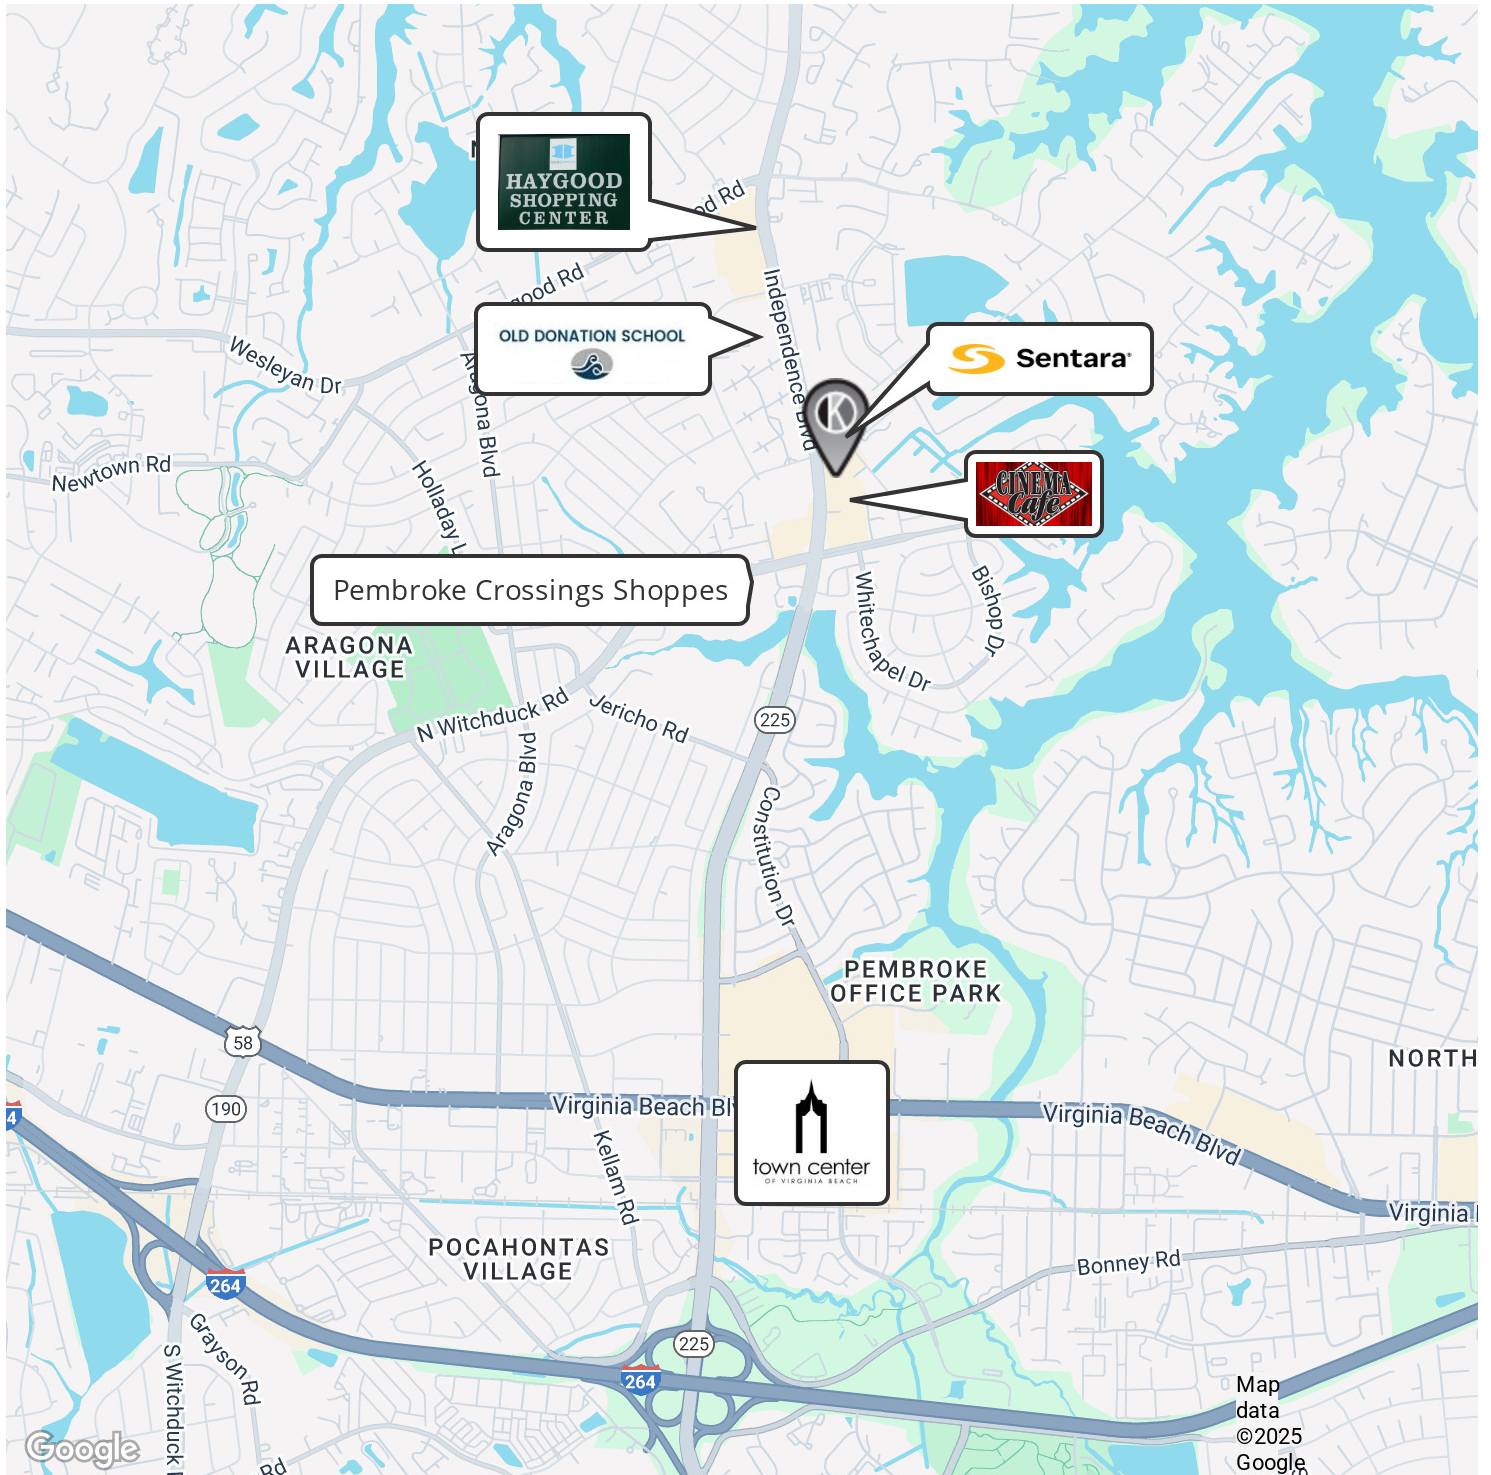

Brokerage with vision. Real estate with results.

Presented By:

John Katsias | President
757.490.3585
jk@katsias.com

Haven Spirelis | Vice President
757.748.8448
Haven@katsias.com

3720 Virginia Beach Blvd suite 200, Virginia Beach, VA 23452 | 757.490.3585 | www.katsias.com

We have in preparing this information used our best endeavors to ensure that the information contained herein in true and accurate, but accept no responsibility and disclaim all liability in respect of any errors, inaccuracies or misstatements contained herein. Prospective purchasers and/or lessors should make their own inquiries to verify the information contained herein.

OFFICE BUILDING FOR SALE OR LEASE

760 INDEPENDENCE BOULEVARD

VIRGINIA BEACH, VA 23455

ADDITIONAL PHOTOS



Brokerage with vision. Real estate with results.

Presented By:

John Katsias | President

757.490.3585

jk@katsias.com

Haven Spirelis | Vice President

757.748.8448

Haven@katsias.com

3720 Virginia Beach Blvd Suite 200, Virginia Beach, VA 23452 | 757.490.3585 | www.katsias.com

We have in preparing this information used our best endeavors to ensure that the information contained herein in true and accurate, but accept no responsibility and disclaim all liability in respect of any errors, inaccuracies or misstatements contained herein. Prospective purchasers and/or lessors should make their own inquiries to verify the information contained herein.