


**BOSWELL
WEST MEDICAL
OFFICE
BUILDING**

10503 W THUNDERBIRD BLVD | SUN CITY, AZ 85351

Floor 02

Suite 262A
AS-BUILT

2,631 SF
AVAILABLE

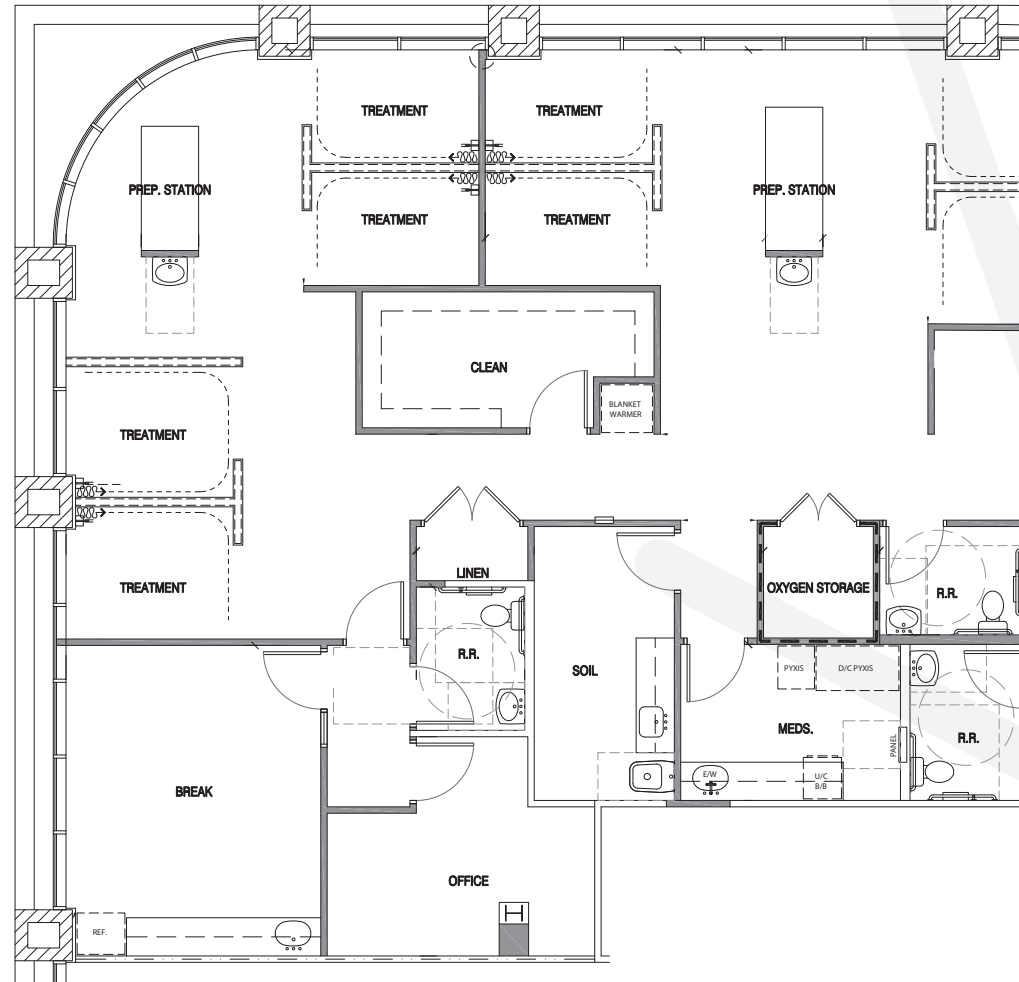

RACHAEL THOMPSON
Senior Vice President
602.513.5122
rachael.thompson@kidder.com

PERRY GABUZZI, CCIM
Senior Vice President
602.513.5116
perry.gabuzzi@kidder.com