

LAKEVIEW
MEDICAL
ARTS
CENTER

Floor 01


Suite 74

AS-BUILT

1,119 SF

AVAILABLE

13000 N 103RD AVE | SUN CITY, AZ 85351

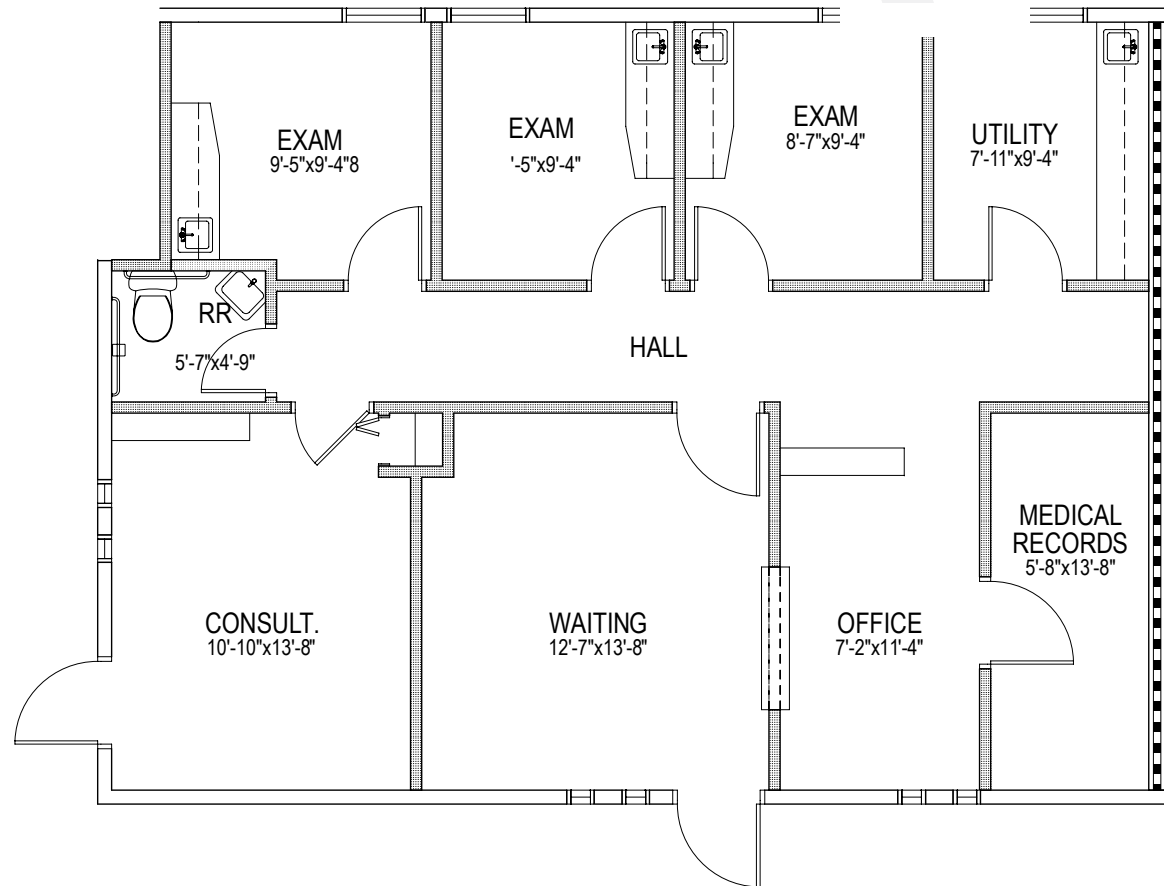

RACHAEL THOMPSON
Senior Vice President
602.513.5122
rachael.thompson@kidder.com

PERRY GABUZZI, CCIM
Senior Vice President
602.513.5116
perry.gabuzzi@kidder.com



View Portfolio

km Kidder
Mathews