


2 SECOND FLOOR PLAN
1.2 3/16" = 1'-0"

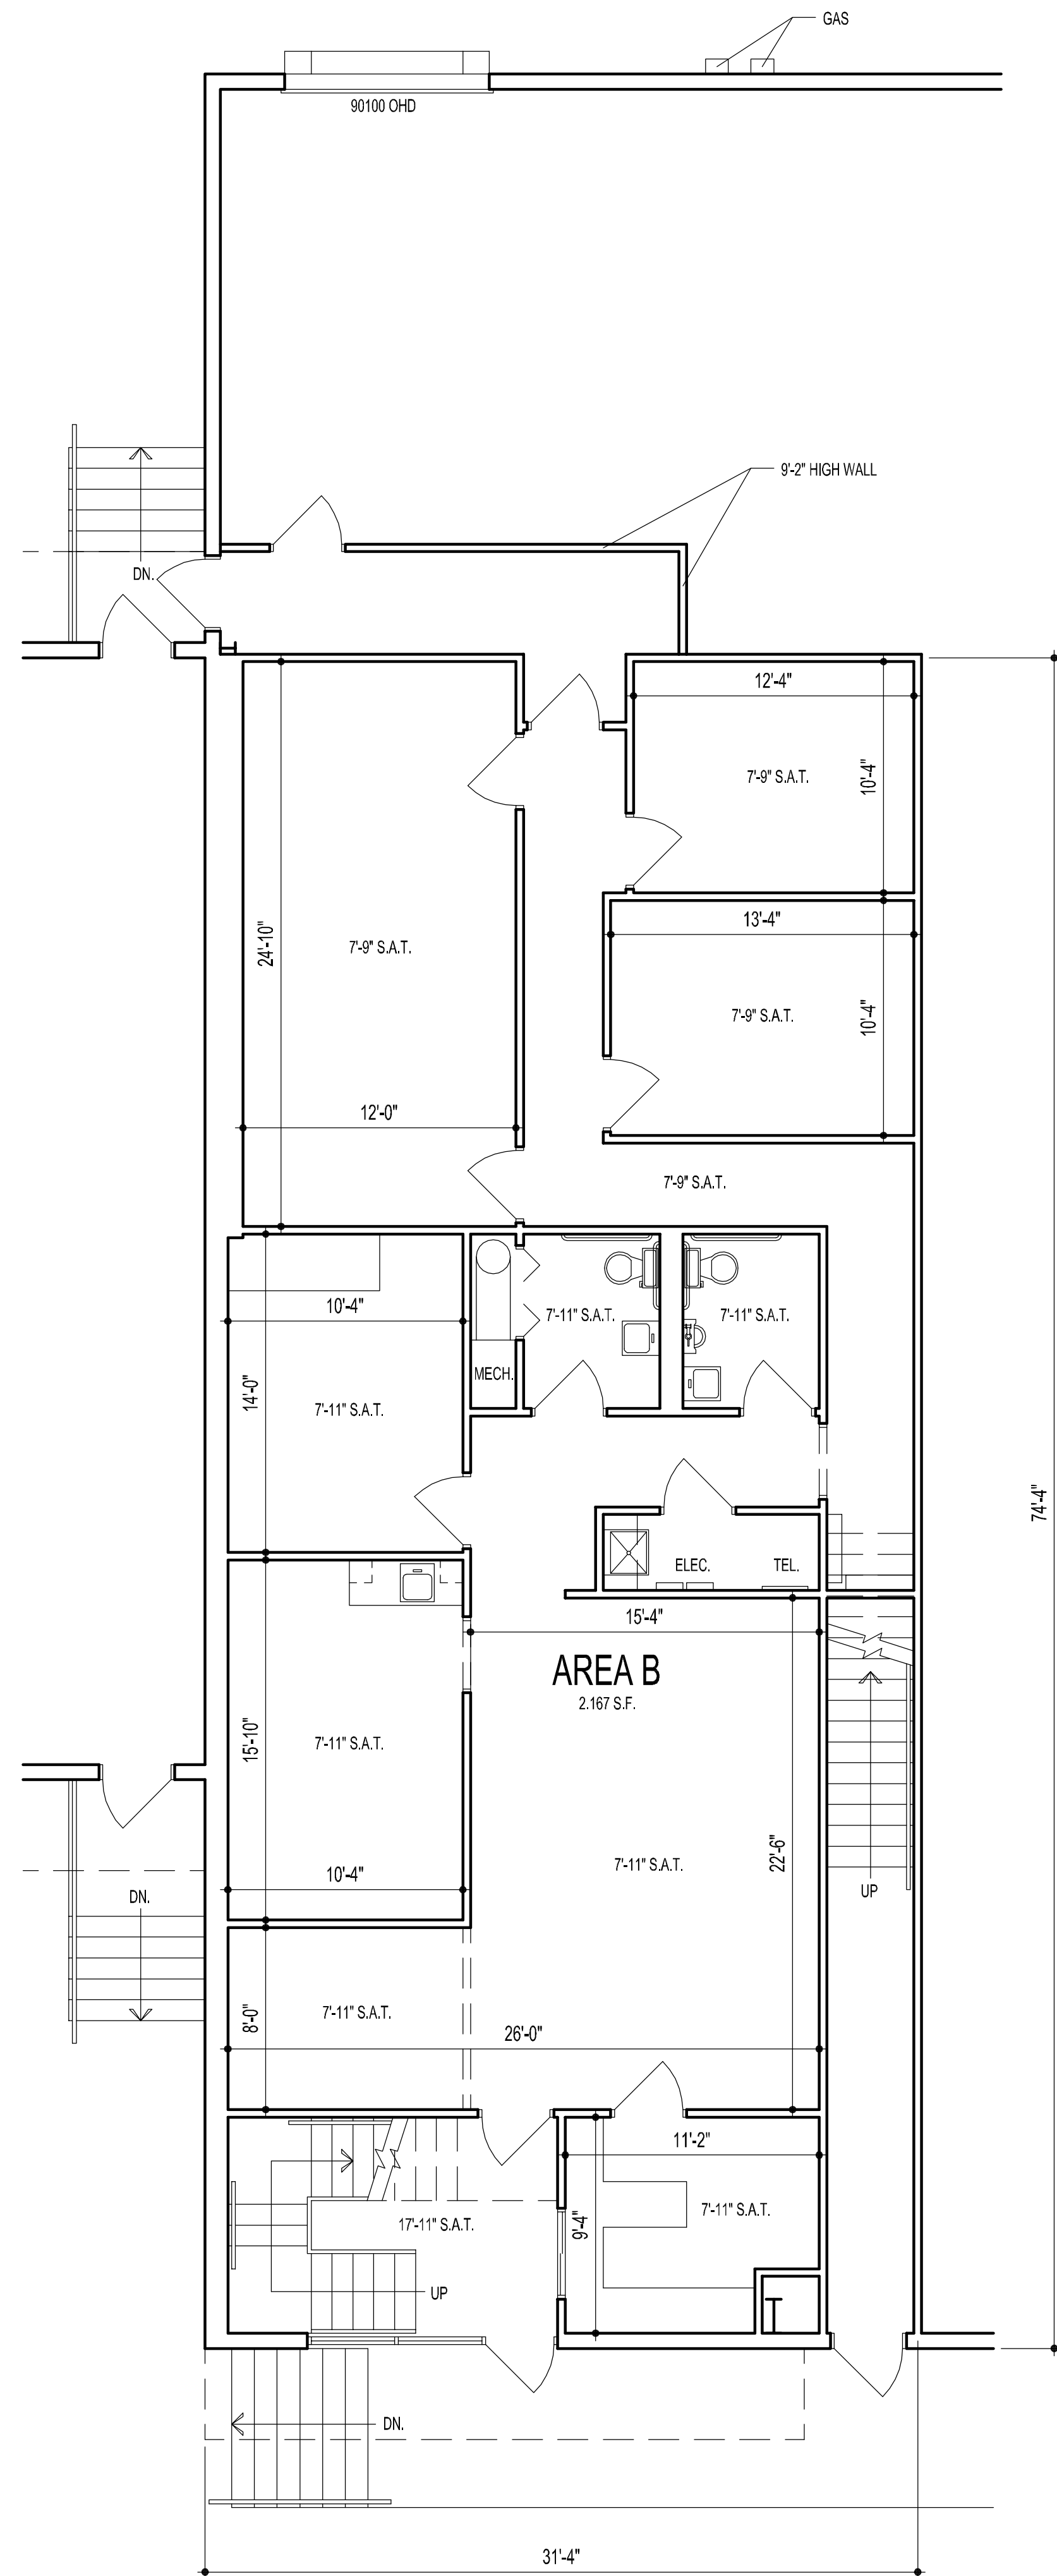

1 FIRST FLOOR PLAN
1.2 3/16" = 1'-0"

- LEGEND:**
- EXISTING WALL TO REMAIN
 - EXISTING WALL TO BE REMOVED
 - NEW WALL
 - TERMINATE WALL @ UNDERSIDE OF DECK ABOVE
 - EXISTING DOOR TO REMAIN
 - EXISTING DOOR TO BE REMOVED
 - NEW DOOR
 - EGRESS PATH EXIT DOOR
 - FIRE EXTINGUISHER

ARCHITECTURE
Planning + Consulting

Alsip
ASSOCIATES PC

119 KING STREET
HAGERSTOWN, MD 21740

301-991-3554
alsip@alsipassociates.com

PROFESSIONAL CERTIFICATION:
I CERTIFY THAT THESE DOCUMENTS WERE PREPARED OR APPROVED BY ME, & THAT I AM A FULLY LICENSED ARCHITECT UNDER THE LAWS OF THE STATE OF MARYLAND, LICENSE #12116 EXPIRATION DATE 4-29-27.

SEAL

A+A Project #250360
As-Built for:
EXISTING BUILDING
Business Parkway
Hagerstown, Maryland 21740

DATE	NO.	REVISION

DATE: 7-10-25
DRAWN BY: SD
DRAWING TITLE:
**PARTIAL FLOOR PLANS
AREA B & D**

A1.2
COPYRIGHT 2025