


# Sorrento Mesa Business Center

9823 Pacific Heights Blvd., Suite H

San Diego, CA 92121

05.30.2012

2,505 sq. ft.

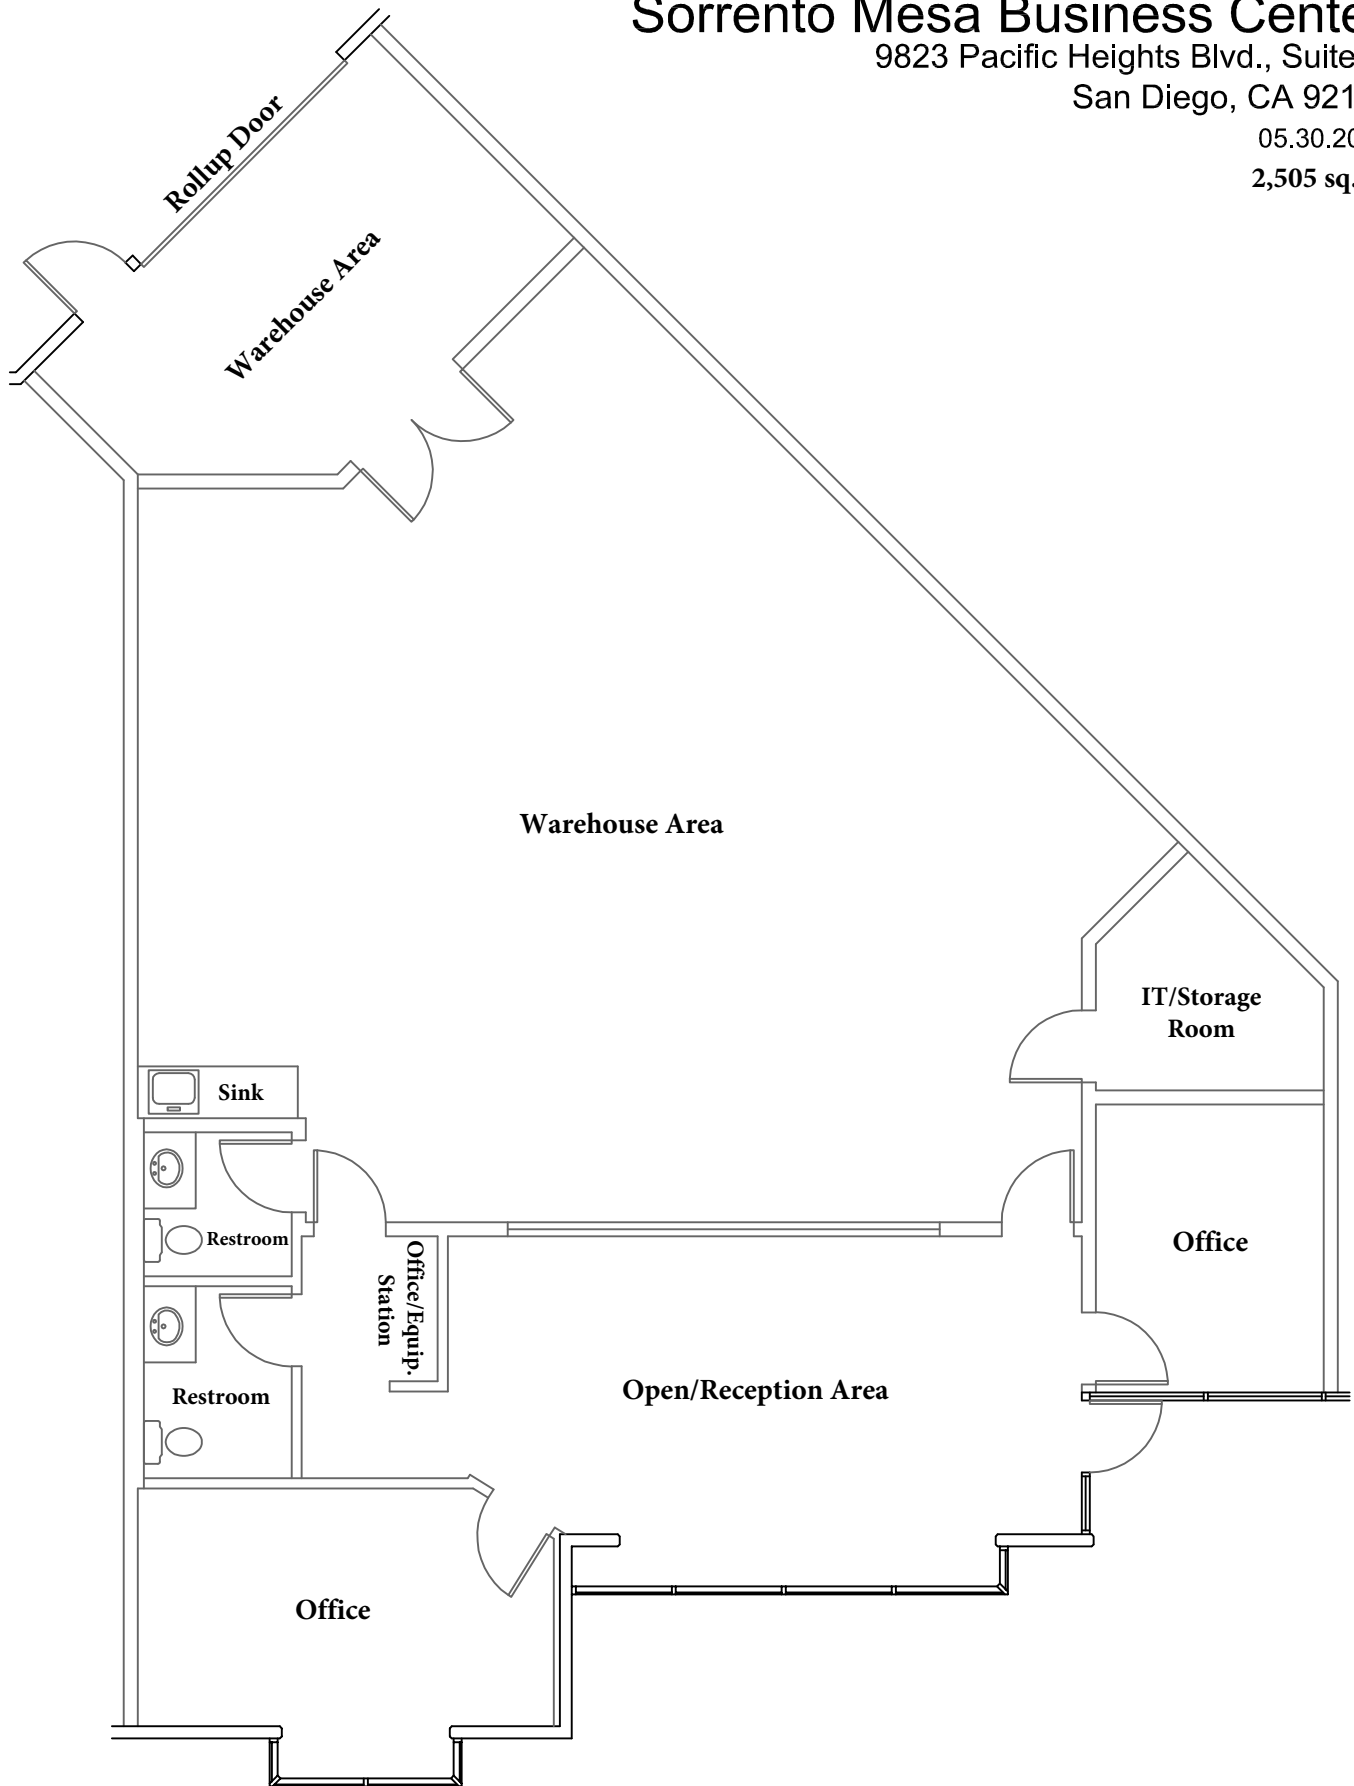

**AS BUILT PLAN**

SCALED TO FIT