


PLANS ARE FOR RECORD DRAWINGS PURPOSES ONLY. FIELD VERIFICATION REQUIRED. OWNER AND TRINITY GROUP ARCHITECTS IS NOT RESPONSIBLE FOR INACCURACIES IN DRAWING.

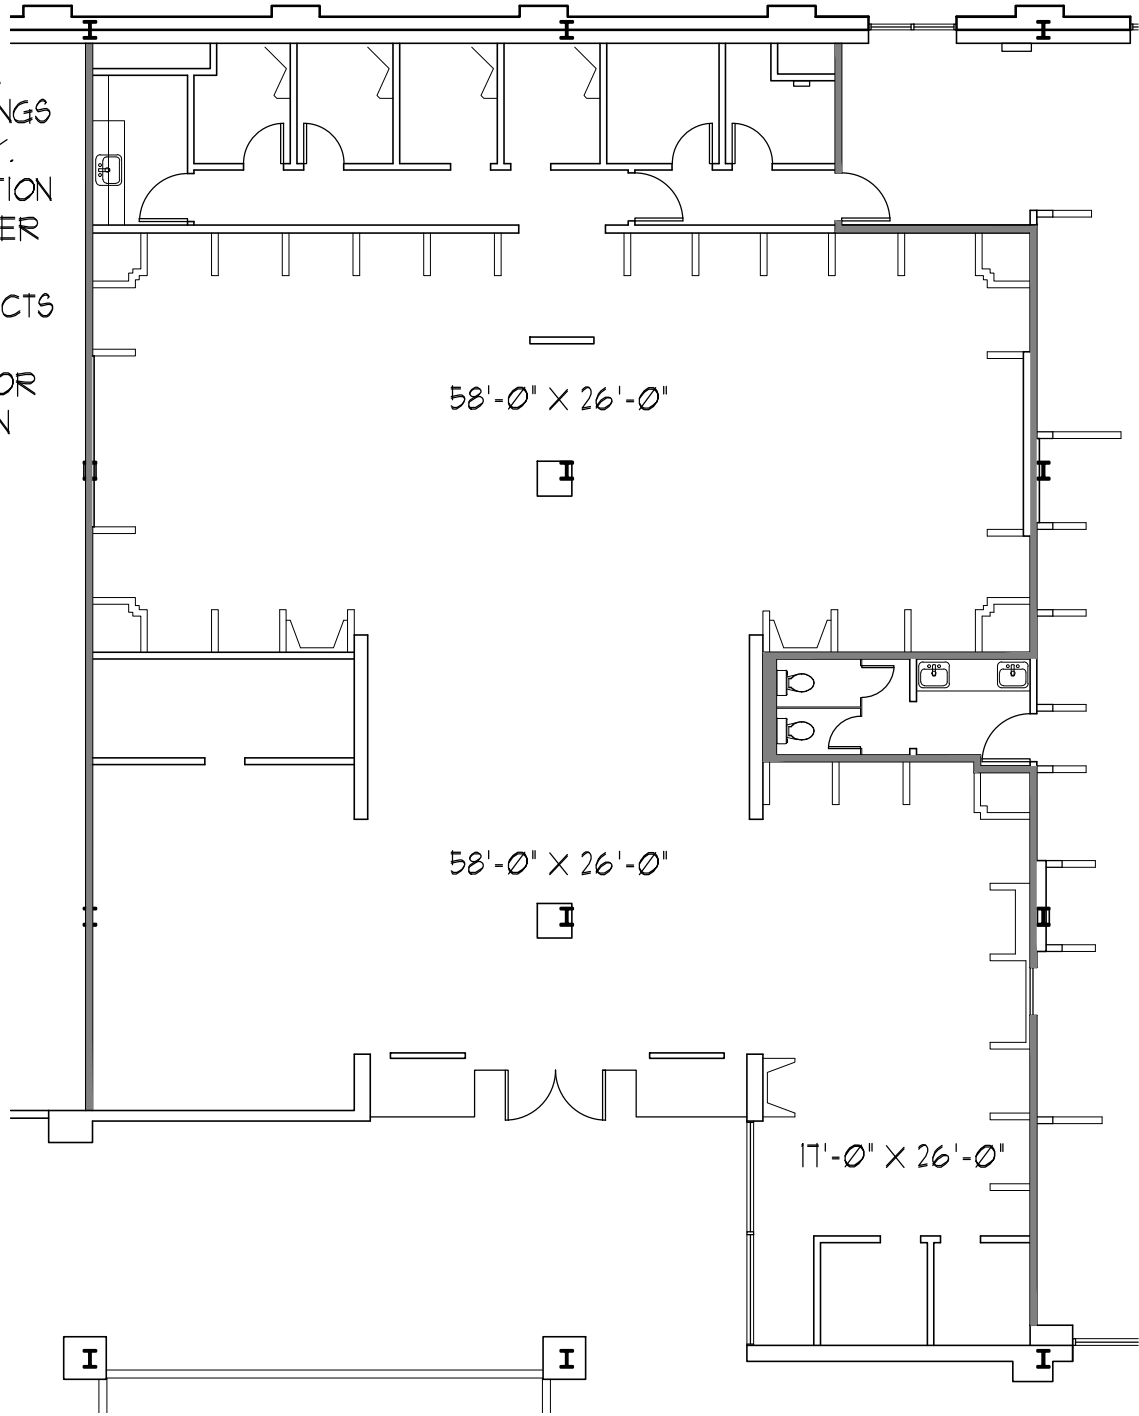

NORTH MARCH 9, 2012

RETAIL 2 SUITE R207 - 3,913 SF

SCALE: NTS



50 Penn Place



TRINITY GROUP ARCHITECTS
3030 N.W. EXPRESSWAY, SUITE 1450
OKLAHOMA CITY, OKLAHOMA 73112
405.947.7262