

ROYAL OAK PROFESSIONAL PLAZA


Floor 01

Suite 101

AS-BUILT

4,543 SF

AVAILABLE

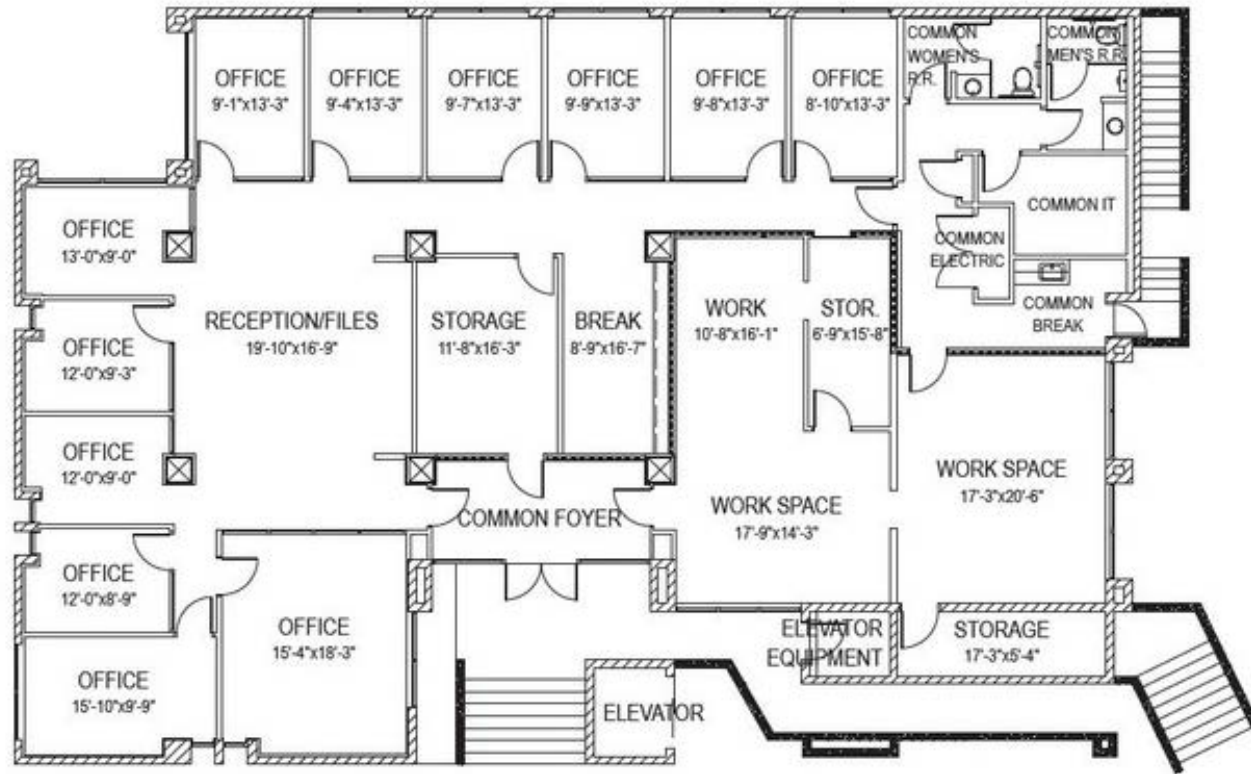

RACHAEL THOMPSON
Senior Vice President
602.513.5122
rachael.thompson@kidder.com

PERRY GABUZZI, CCIM
Senior Vice President
602.513.5116
perry.gabuzzi@kidder.com