





FLOOR 01

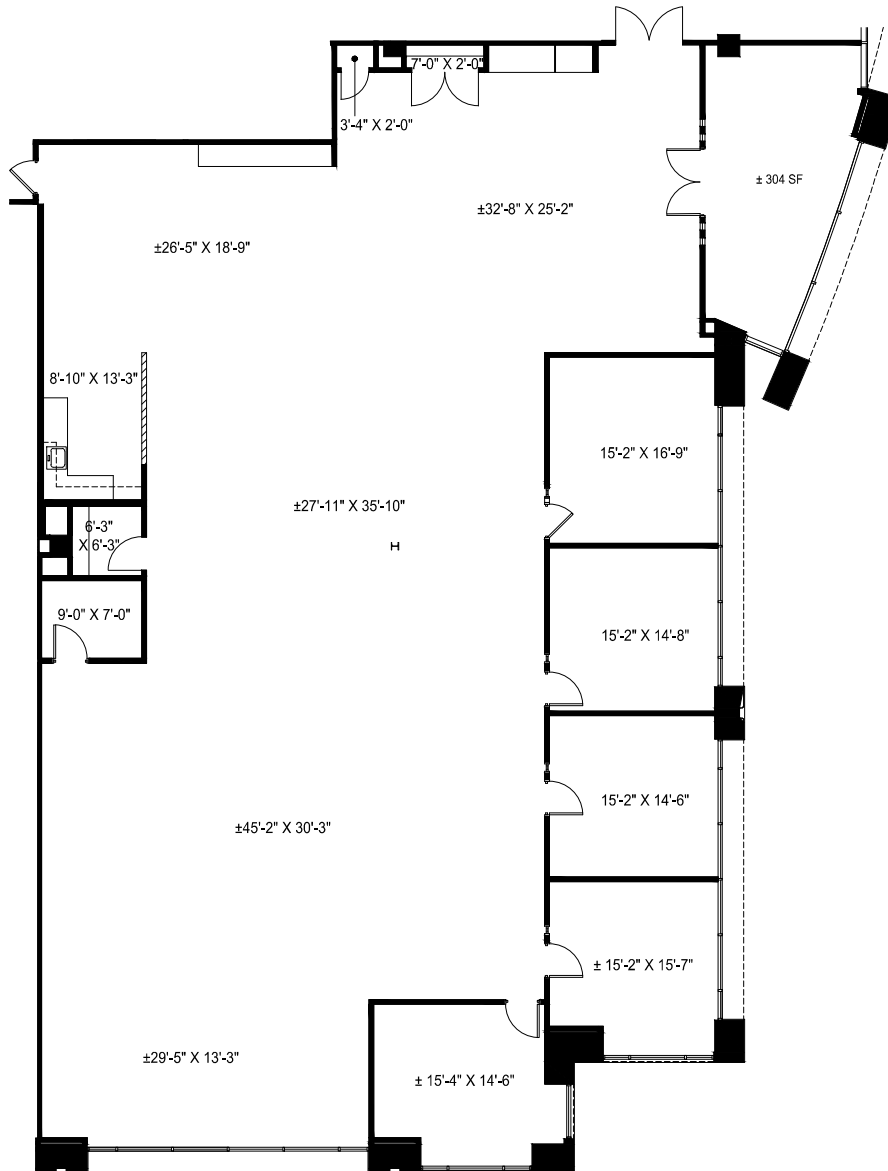

NORTH

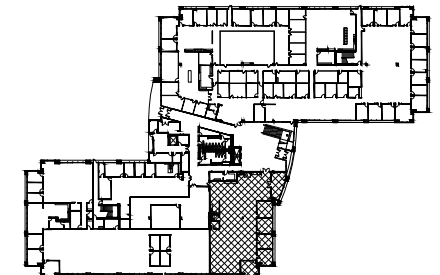

ALL DIMENSIONS ARE APPROXIMATE AND SUBJECT TO NOMINAL VARIANCE.

NEWMARK

WILLOW BEND OFFICE CENTER
PLANO, TEXAS

AS-BUILT PLAN
SUITE 140

rsf:	6,621
scale:	N.T.S.
date:	06.30.2026

gostudio

1201 main street
suite 1370
dallas, texas 75202
214.420.4646