

# Property Key





# 3904 Corporex Drive As Built Marketing Package

3904 Corporex Drive, Tampa, FL 33619

Building: 3  
Suite: 500  
Sheet: A-4


Scale: Not to Scale  
Sheet Size: 8.5" x 11"  
Not For Construction

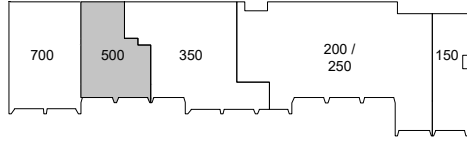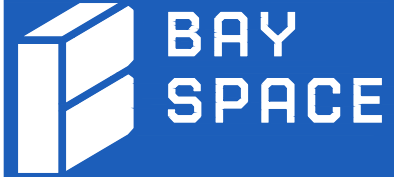

Total Area - 4,653 SF

## Building Information

DECK HEIGHT:	N/A
CEILING HEIGHT:	8'-11"
CLEAR HEIGHT:	8'-11"
SPRINKLERED:	No

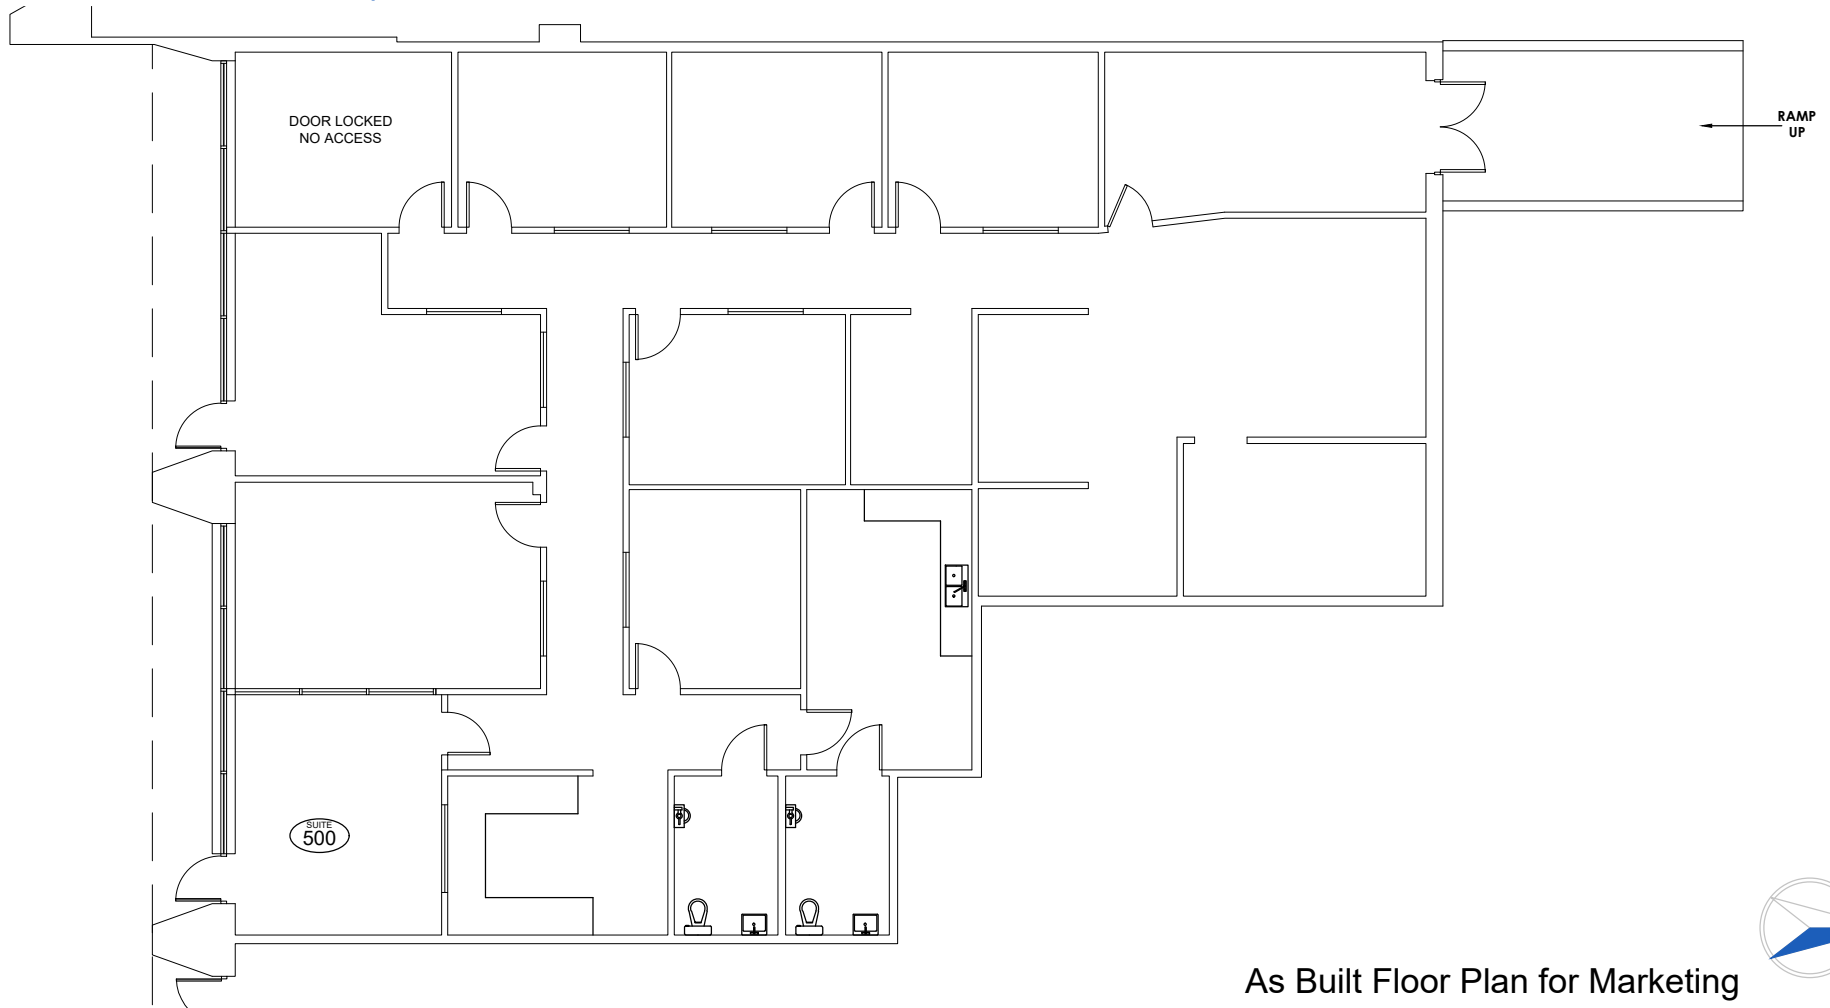

As Built Floor Plan for Marketing

