

609 H

street north east

FLOOR


RSF

4

16,630

H STREET

6TH STREET

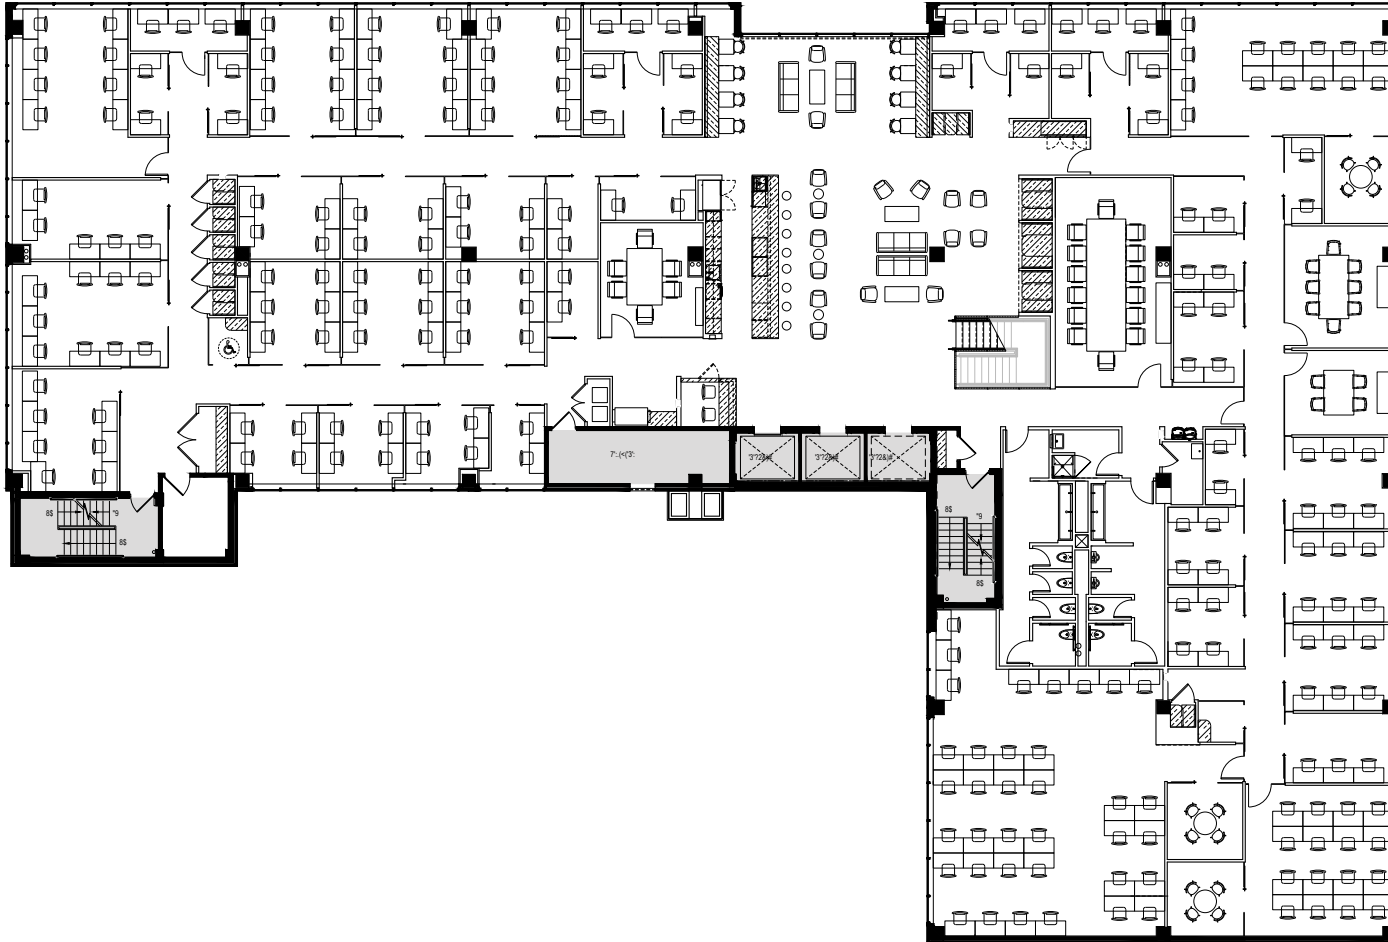

MATT PACINELLI
matt.pacinelli@streamrealty.com
202.595.1498

VANESSA CARRION
vanessa.carrion@streamrealty.com
202.595.1749

STREAM