



SCALE: N.T.S.

AS-BUILT PLAN--ENTIRE BUILDING TWO
13,400 RSF

RIVERWATCH
2917 RIVERWEST DRIVE
AUGUSTA, GA 30907

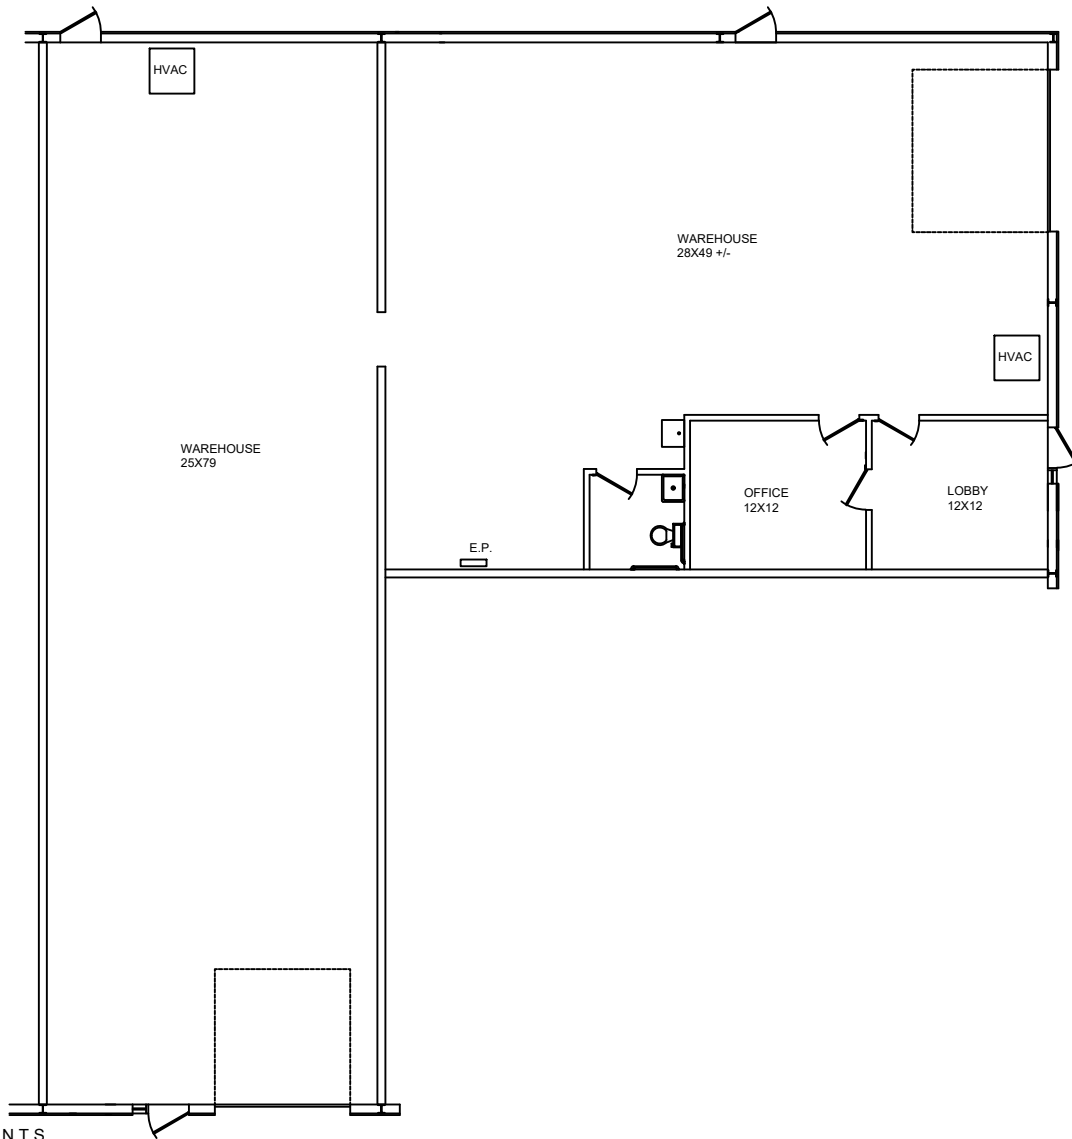


SCALE: N.T.S.

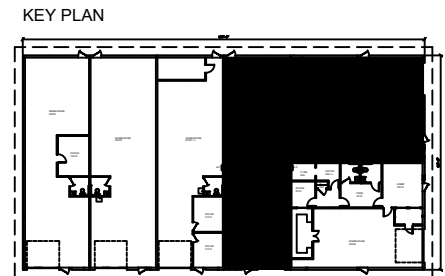


AS-BUILT PLAN--SUITES 201/203
4,440 RSF

RIVERWATCH
2917 RIVERWEST DRIVE
AUGUSTA, GA 30907

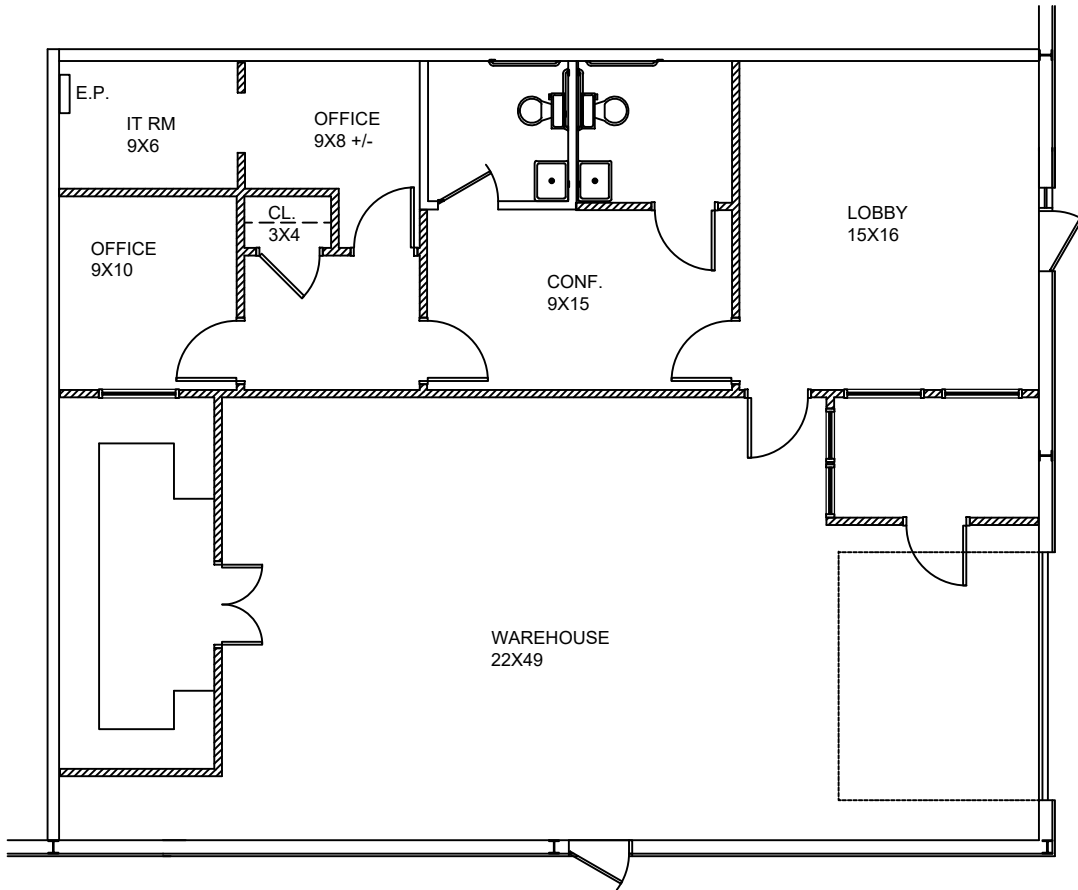


SCALE: N.T.S.

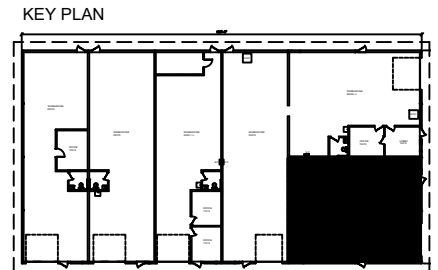


AS-BUILT PLAN--SUITE 202--2,268 RSF

RIVERWATCH
2917 RIVERWEST DRIVE
AUGUSTA, GA 30907

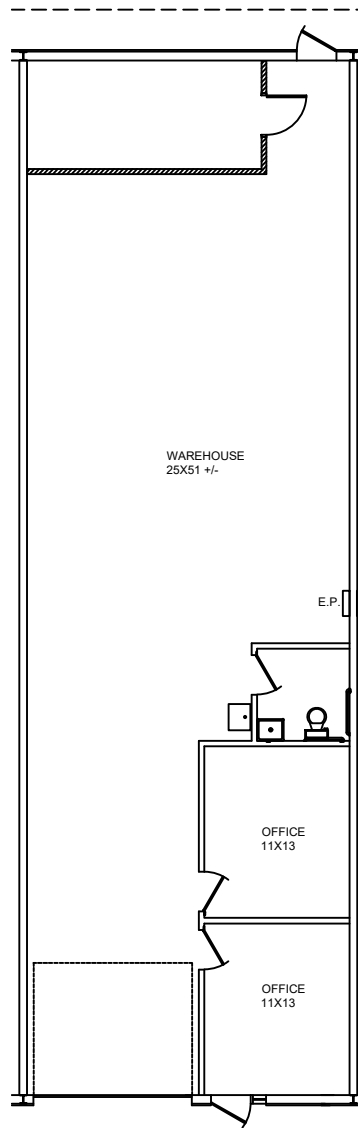


SCALE: N.T.S.

KEY PLAN

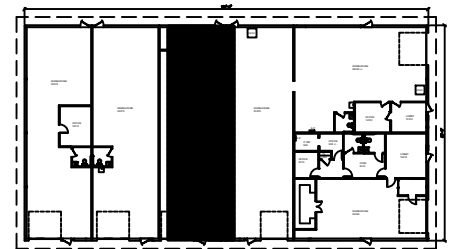


AS-BUILT PLAN--SUITE 204--2,155 RSF

RIVERWATCH
 2917 RIVERWEST DRIVE
 AUGUSTA, GA 30907

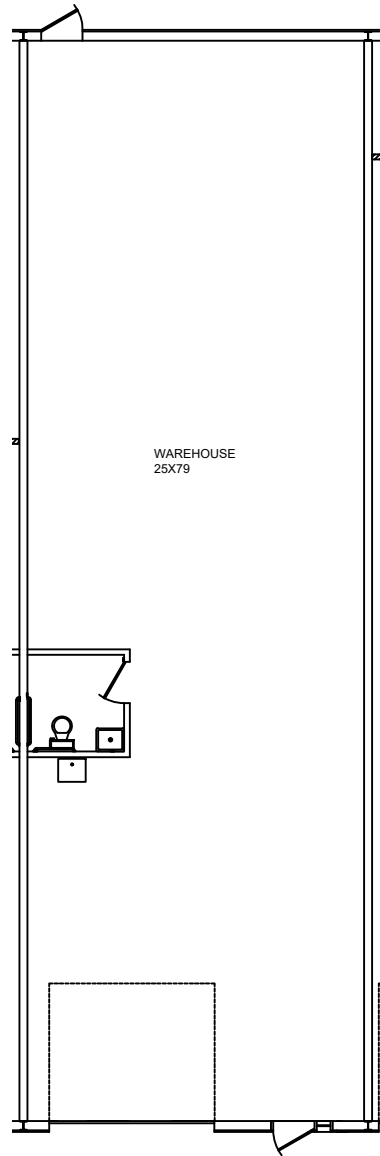


SCALE: N.T.S.

KEY PLAN

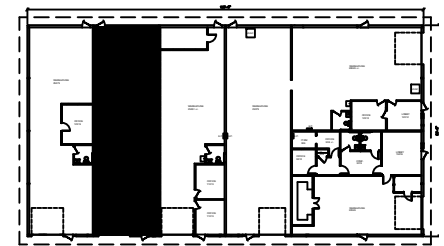


AS-BUILT PLAN--SUITE 205--2,155 RSF

RIVERWATCH
2917 RIVERWEST DRIVE
AUGUSTA, GA 30907

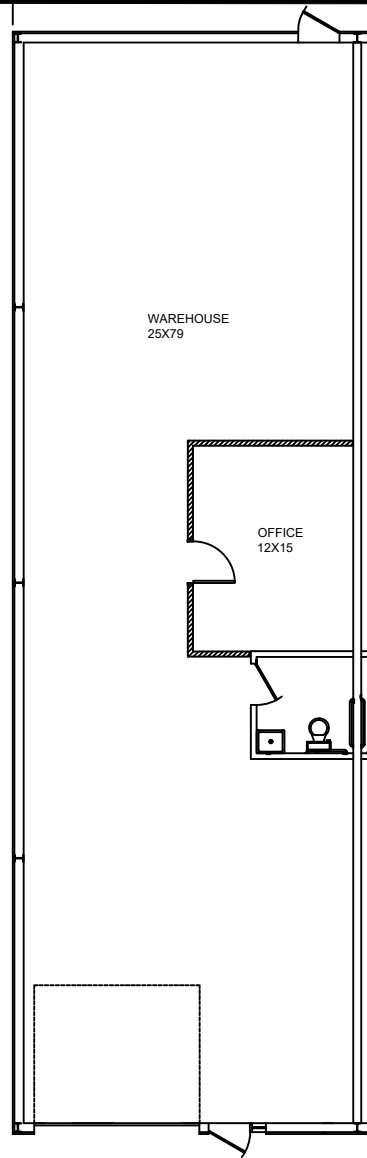

SCALE: N.T.S.

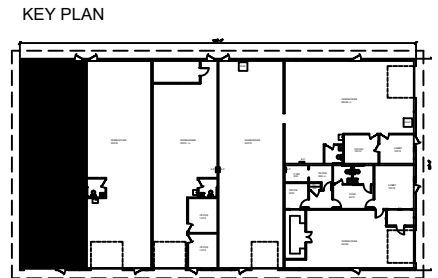

AS-BUILT PLAN--SUITE 206--2,382 RSF

RIVERWATCH
2917 RIVERWEST DRIVE
AUGUSTA, GA 30907