


# 2800 MIDLAND MEDICAL BUILDING

2800 CHICAGO AVE SO

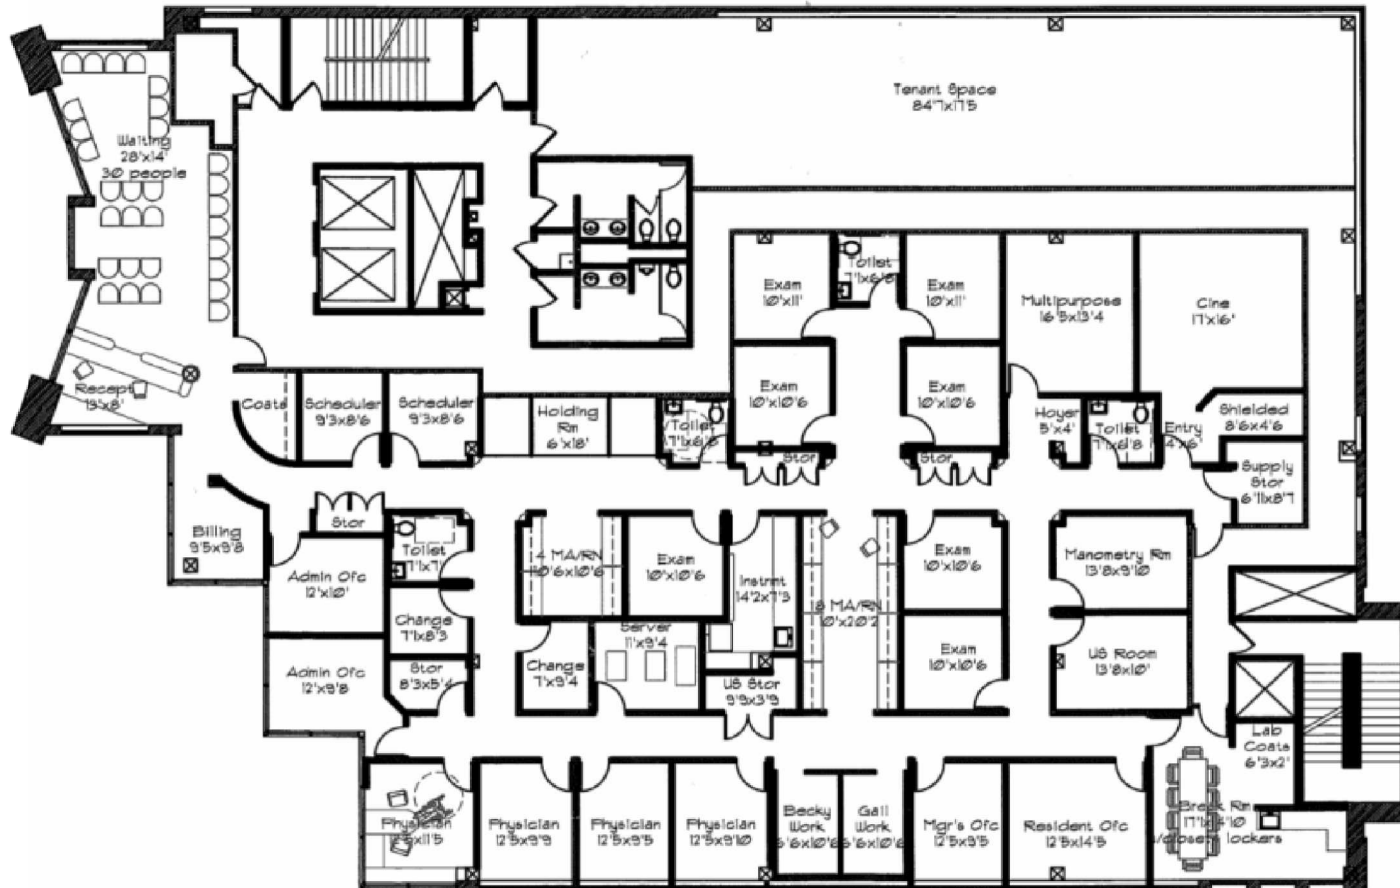

Suite: 300

10,828 Rentable Square Feet

Mike Fleetham  
952-767-2842 (direct)  
612-386-0993 (mobile)  
mfleetham@medcraft.com

Jolene Ludvigsen  
952-838-7126 (direct)  
612-889-7586 (mobile)  
jludvigsen@medcraft.com

Leased by:



Managed by:

