
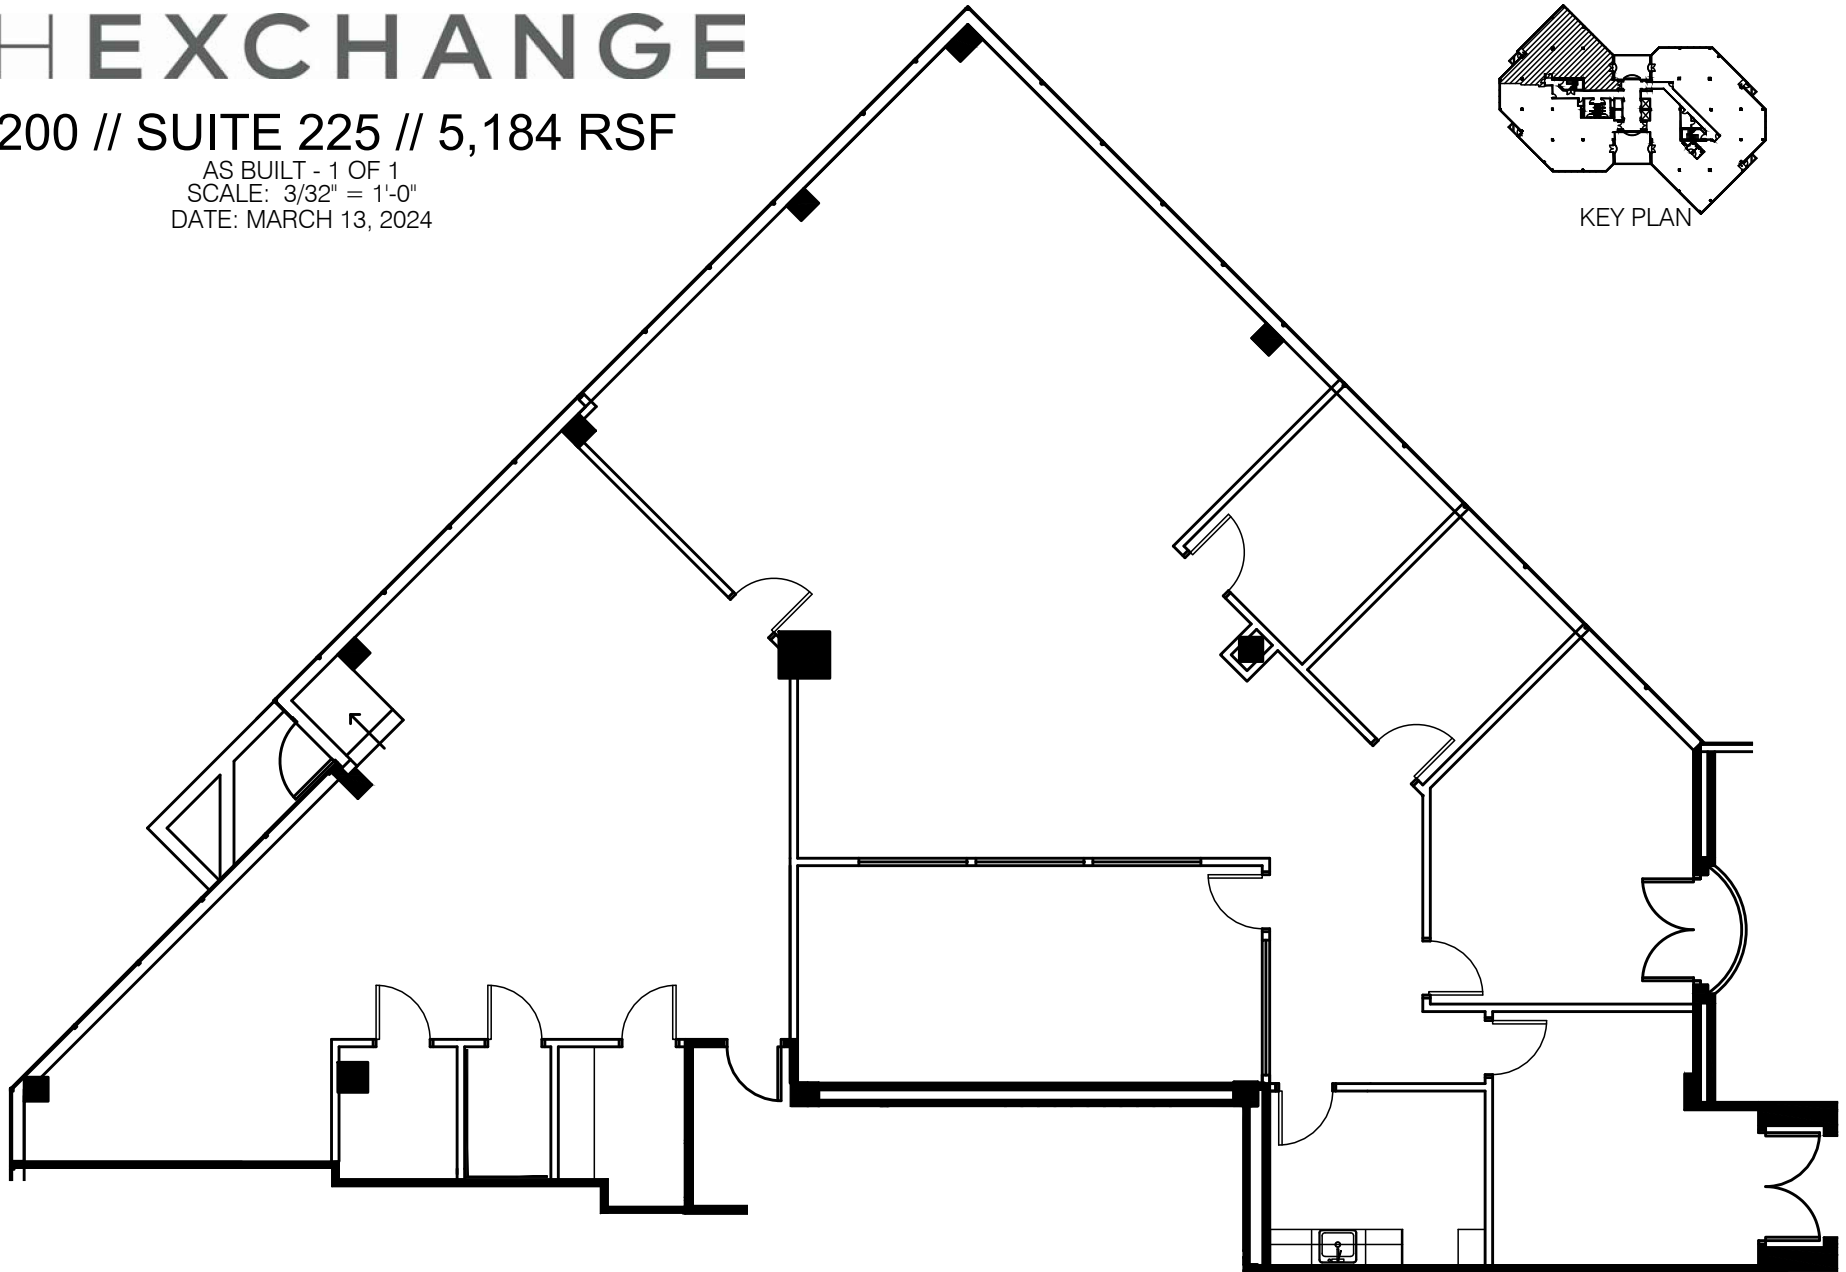


THE EXCHANGE

5200 // SUITE 225 // 5,184 RSF

AS BUILT - 1 OF 1
SCALE: 3/32" = 1'-0"
DATE: MARCH 13, 2024

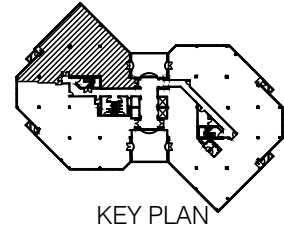

CBRE

