


SUITE 204

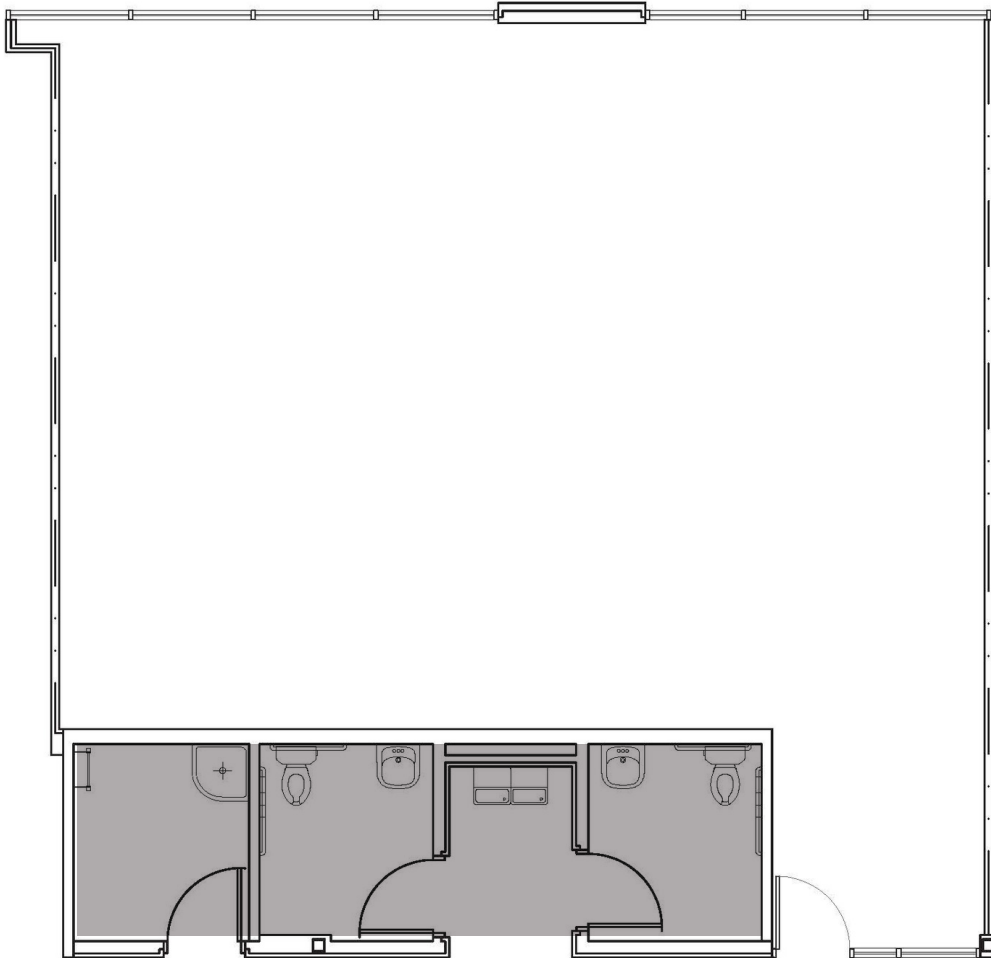

1,533 SF

AVAILABLE

Leasing by

PERRY GABUZZI, CCIM
602.513.5116
perry.gabuzzi@kidder.com

RACHAEL THOMPSON
602.513.5122
rachael.thompson@kidder.com