


SUITE 900

SUITE 950

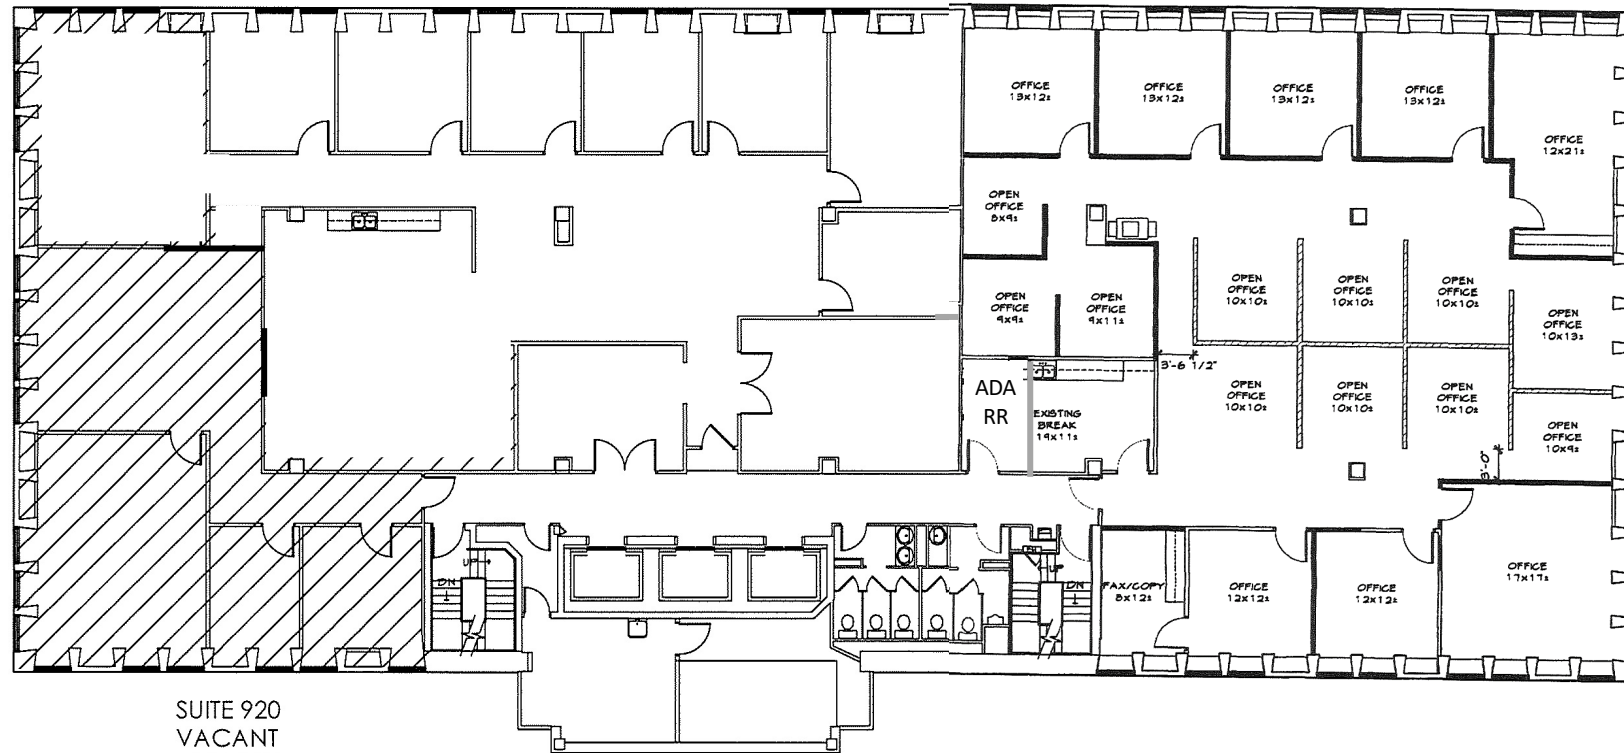

SUITE 920
 VACANT
 1483 RSF

A FLOOR PLAN 
 SCALE: N.T.S.

9TH FLOOR

SOUTHLAND
 TOWER
 9TH FLOOR

PRICE EDWARDS
 AND COMPANY

03.05.2021

•
 •
AS BUILT