
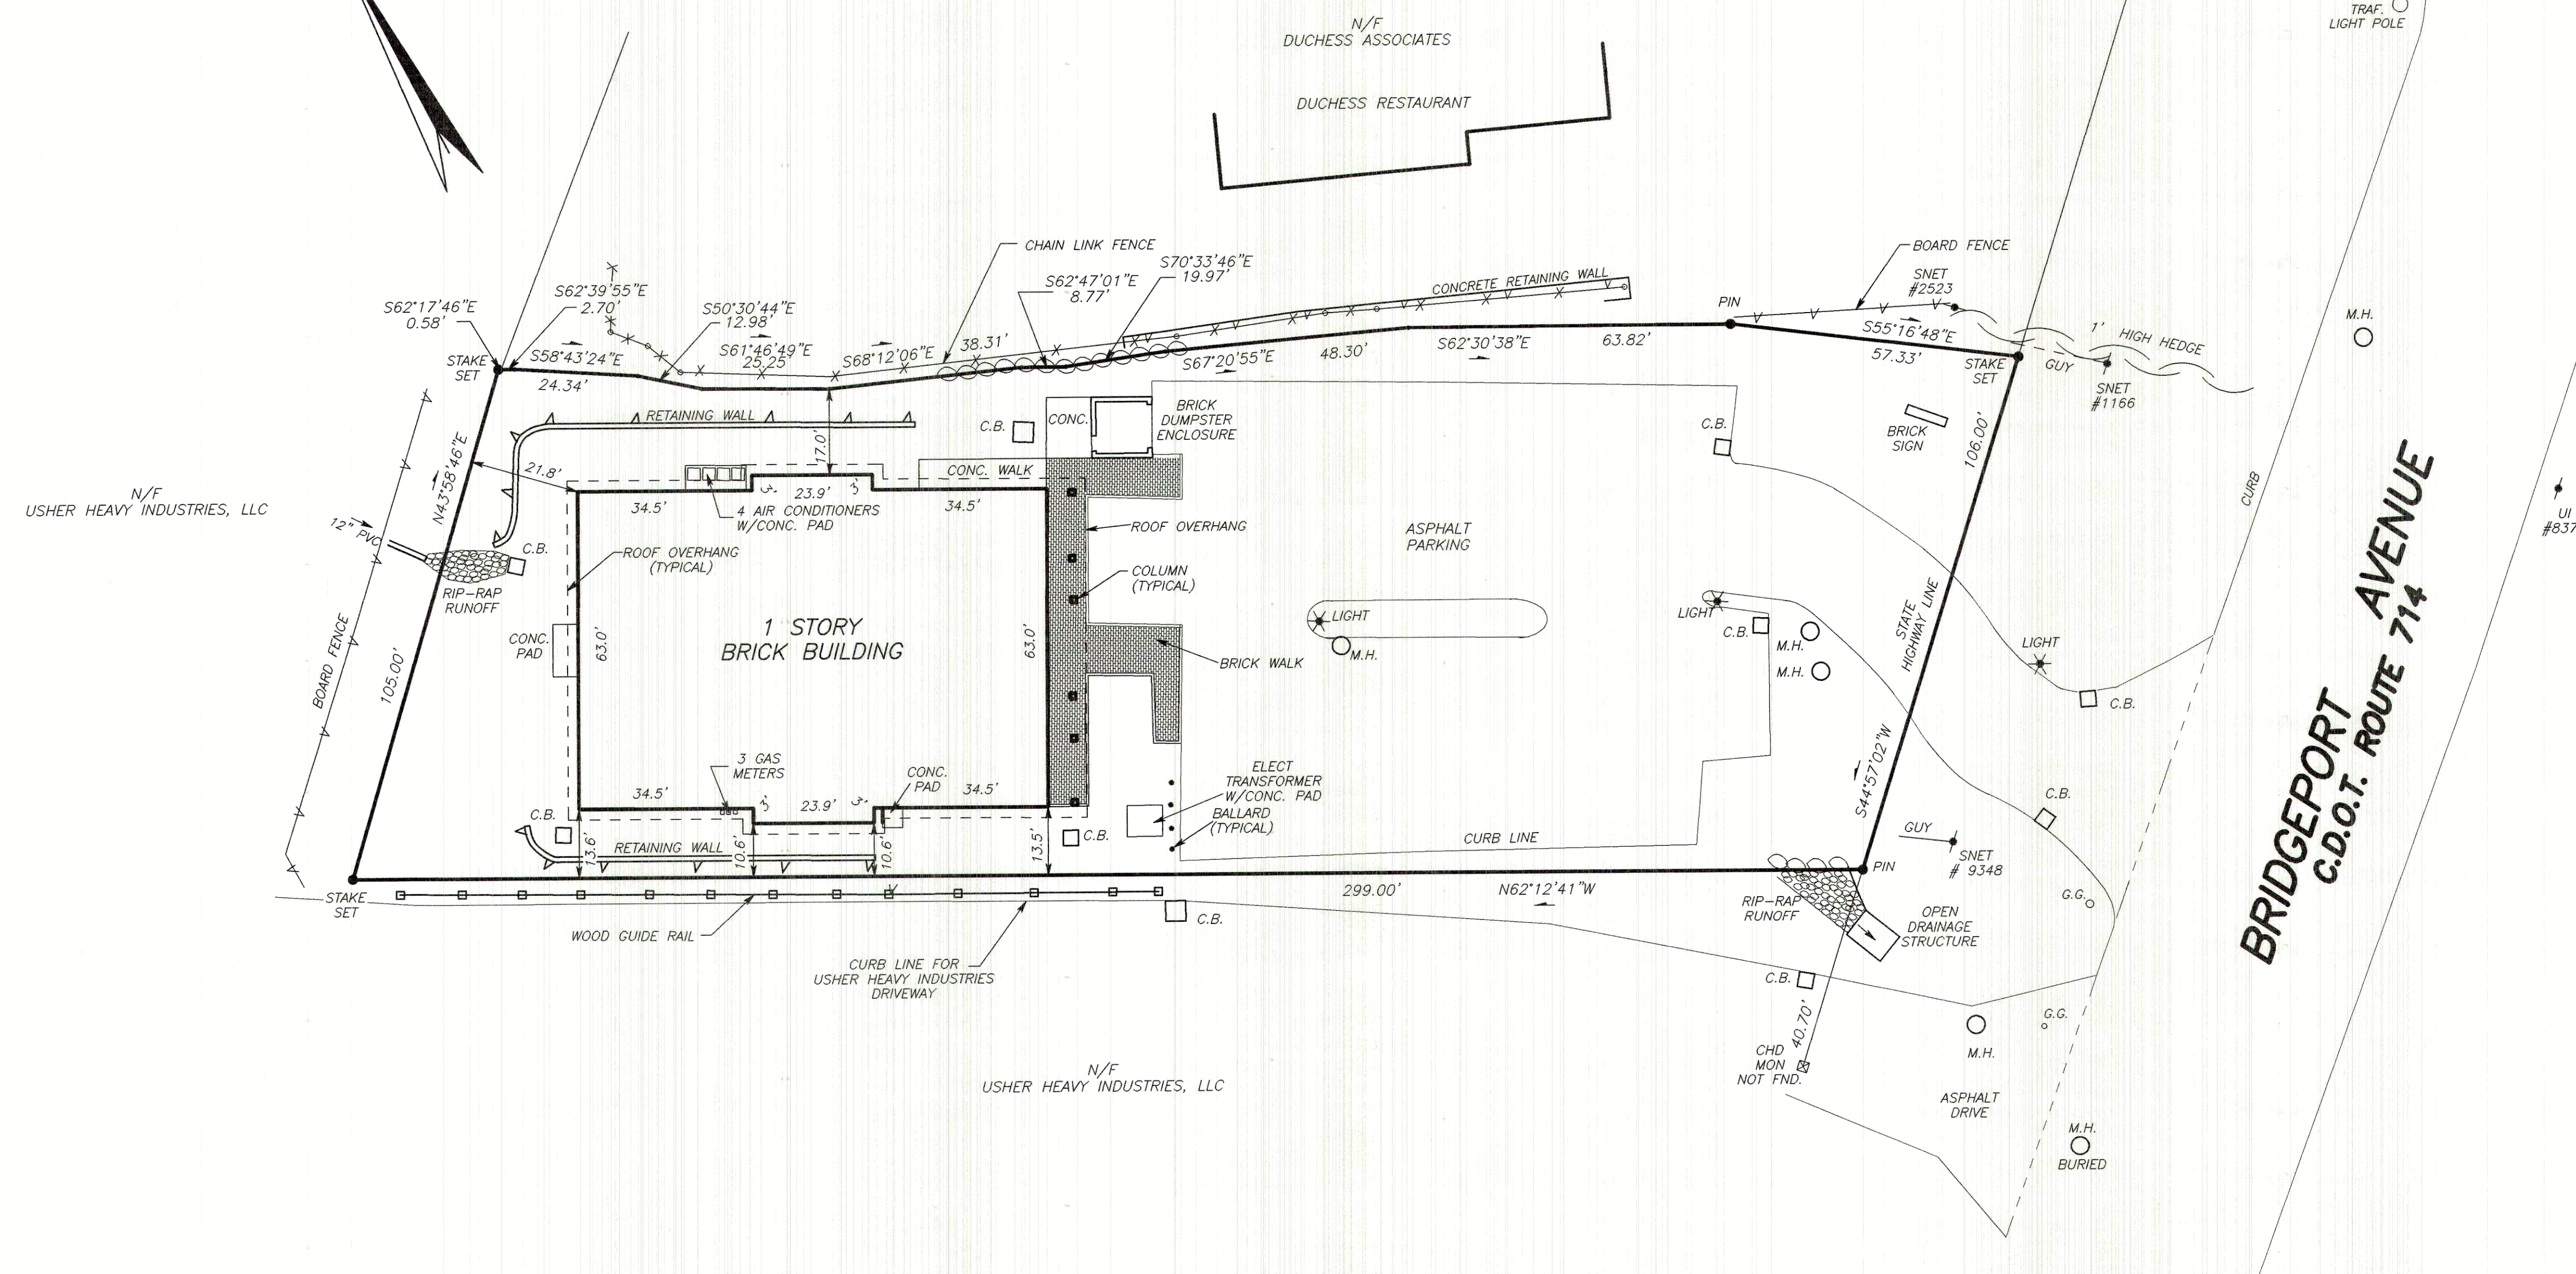


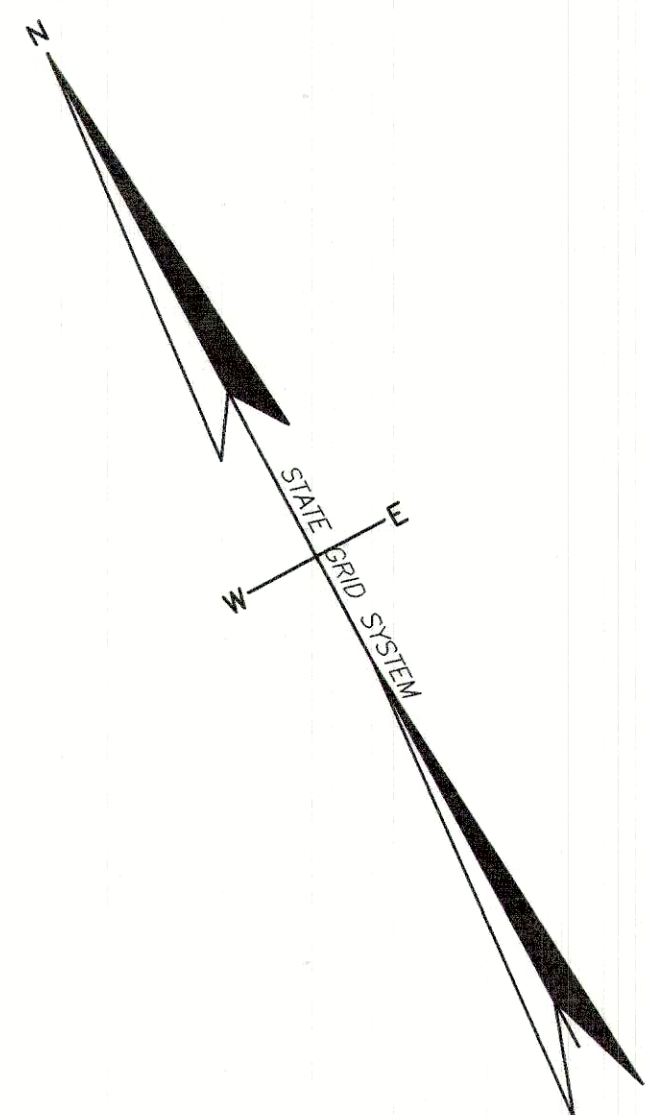

MAP REFERENCE:

1. Property Survey 887 Bridgeport Avenue, Shelton, Connecticut scale: 1"= 20' dated Jan. 11, 2000 by Tracy H. Lewis, T.C. Map No. 3643

NOTES:

1. This survey and map has been prepared in accordance with Sections 20-300b-1 thru 20-300b-20 of the Regulations of Connecticut State Agencies - "Minimum Standards for Surveys and Maps in the State of Connecticut" as adopted by the Connecticut Association of Land Surveyors, Inc. It is a Resurvey conforming to Horizontal Accuracy Class A-2.

2. Bearings are referenced to the State of Connecticut Coordinate Grid System.

To my knowledge and belief,
this map is substantially correct as noted hereon.

This map is not valid unless it has a live
signature and embossed seal of Tracy H. Lewis.

TRACY H. LEWIS L.L.S.

CT. LIC. NO. 15160

LOT AREA: 30,937 S.F. = 0.7102 AC.

AS-BUILT PROPERTY SURVEY


OF PROPERTY LOCATED AT

887 BRIDGEPORT AVENUE
(C.D.O.T. ROUTE 714)
SHELTON, CONNECTICUT

PREPARED FOR

KRAFTS DEVELOPMENT, LLC

SCALE: 1"= 20' DATE: 9-21-2000

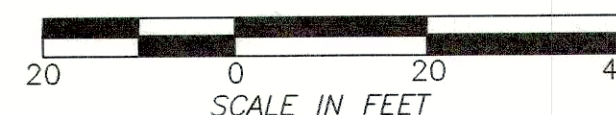

LEWIS ASSOCIATES

LAND SURVEYING AND CIVIL ENGINEERING
260 MAIN STREET, MONROE, CONNECTICUT
PHONE: 203-261-8648