



3 SECOND FLOOR PLAN
 910 GROSS SQ. FT.
 1/4" = 1'-0"

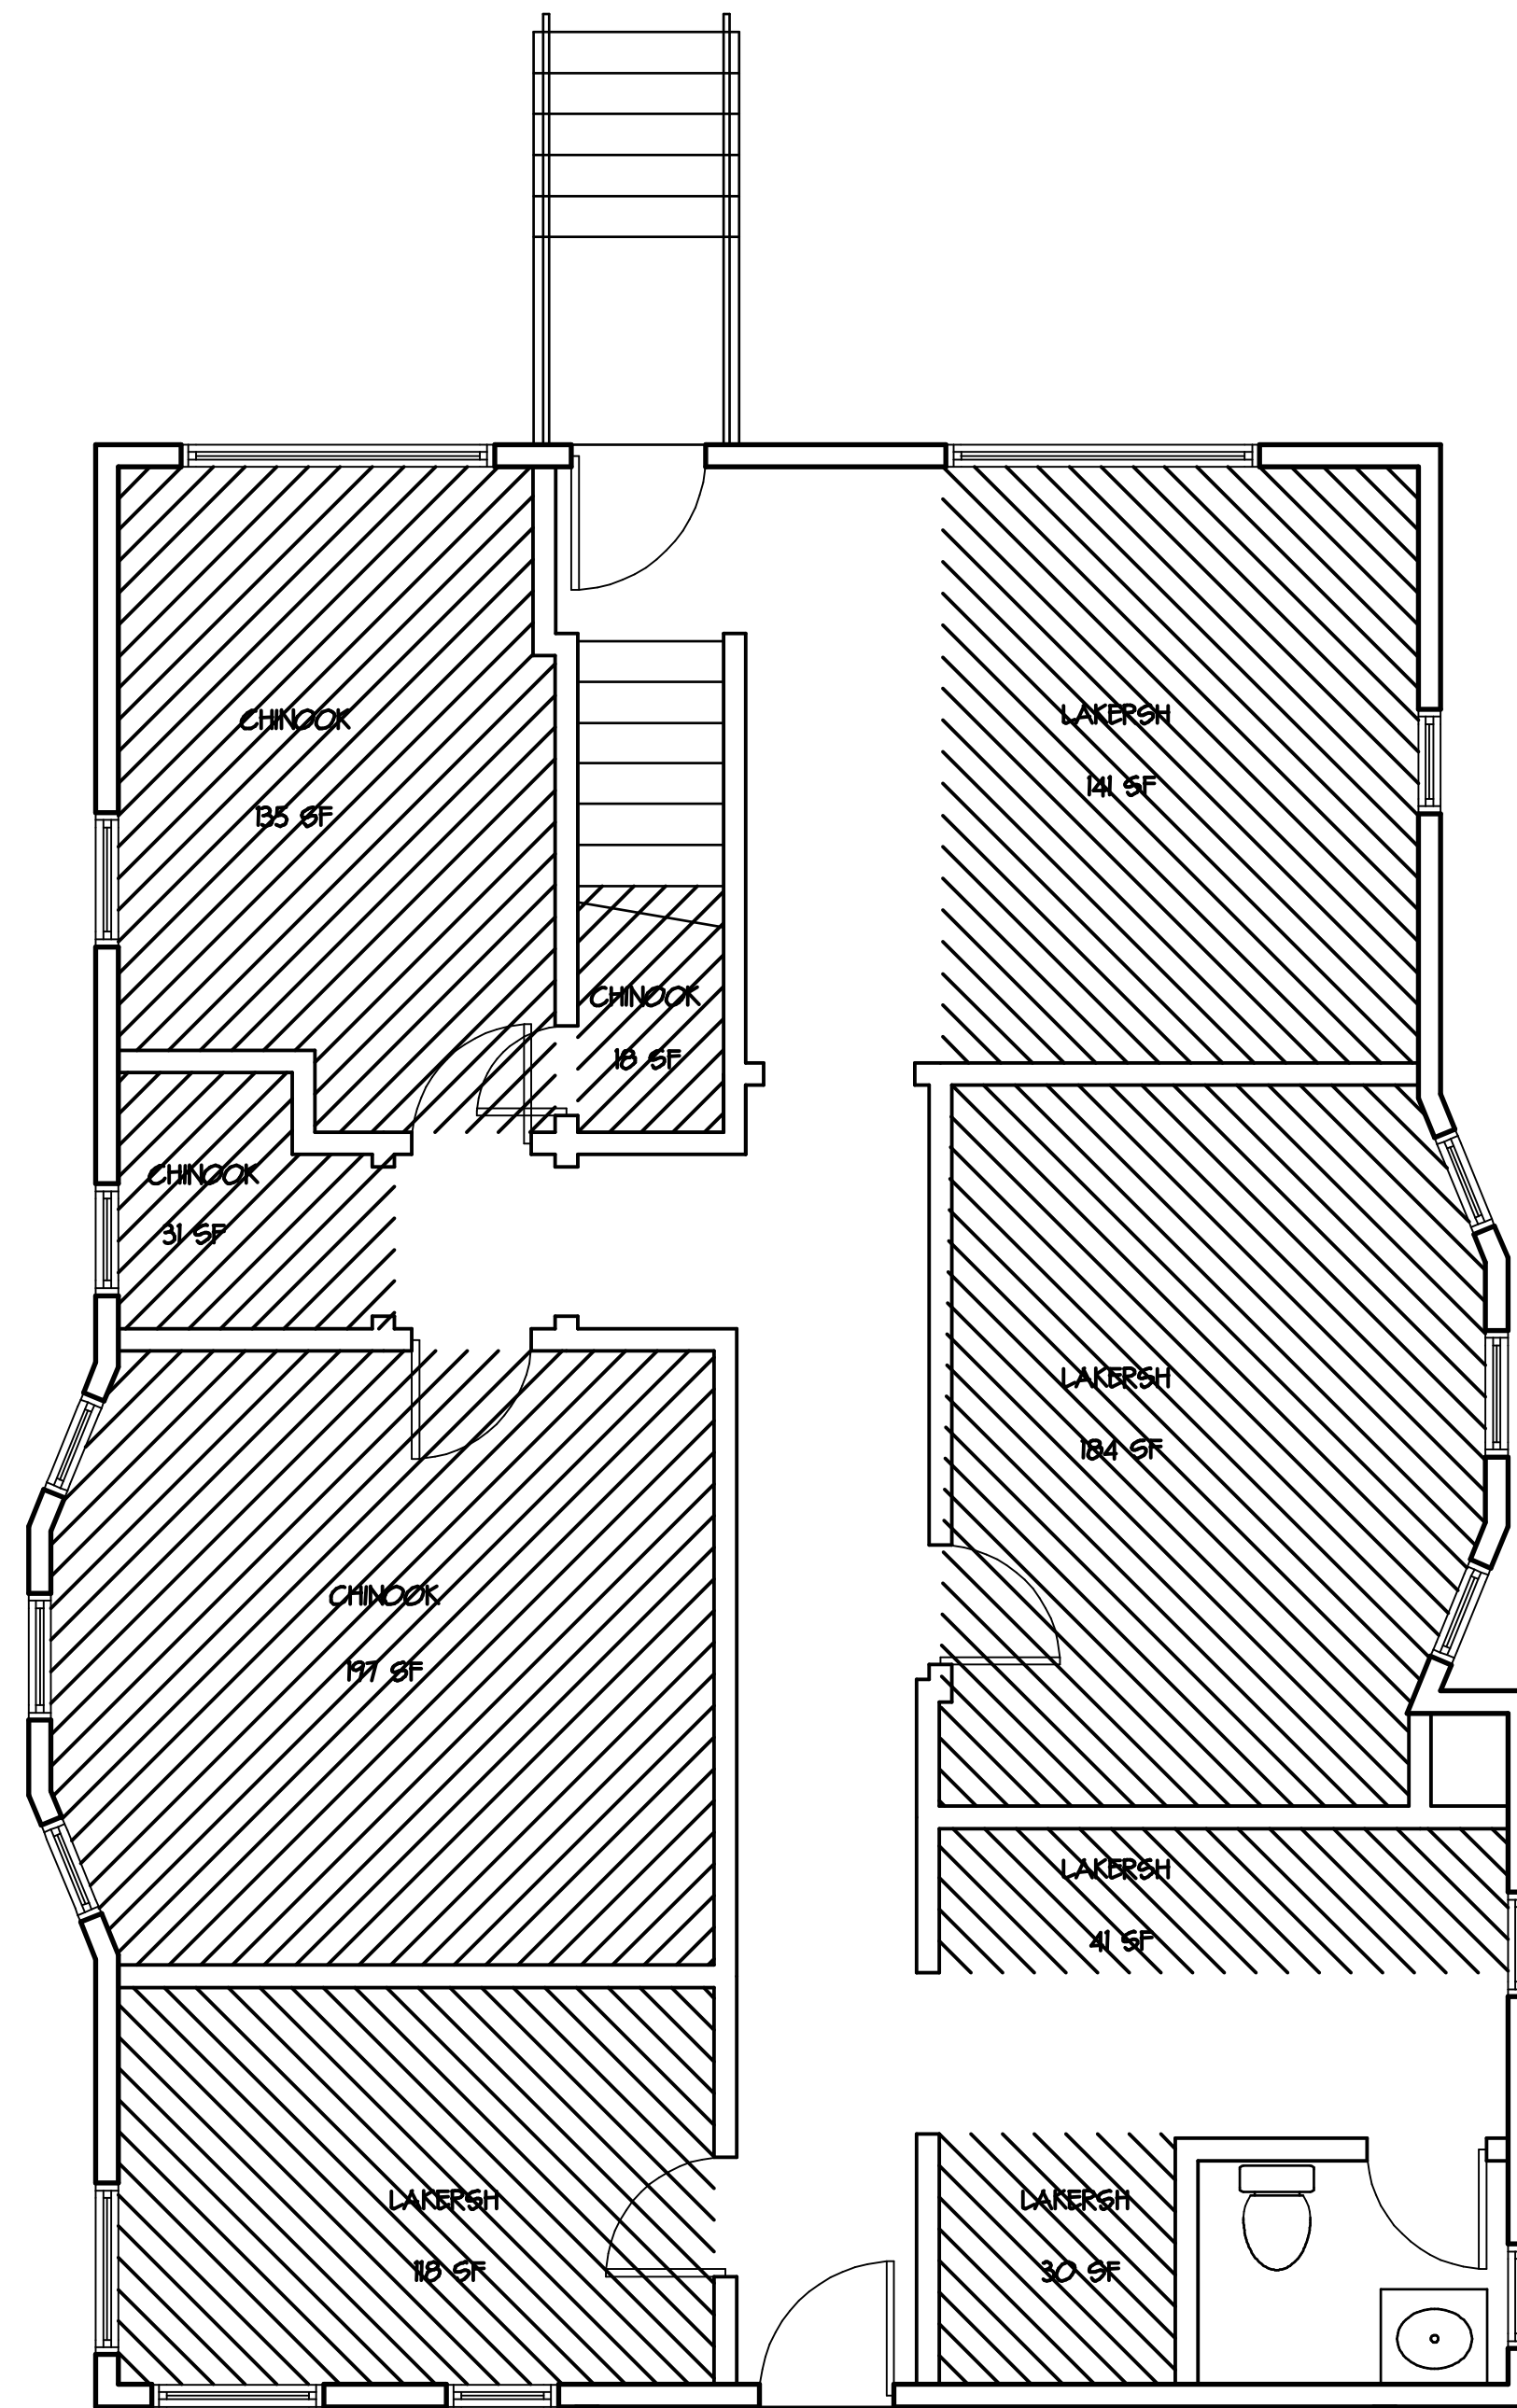


2 FIRST FLOOR PLAN
 FIRST FLOOR = 1376 GROSS SQ. FT.

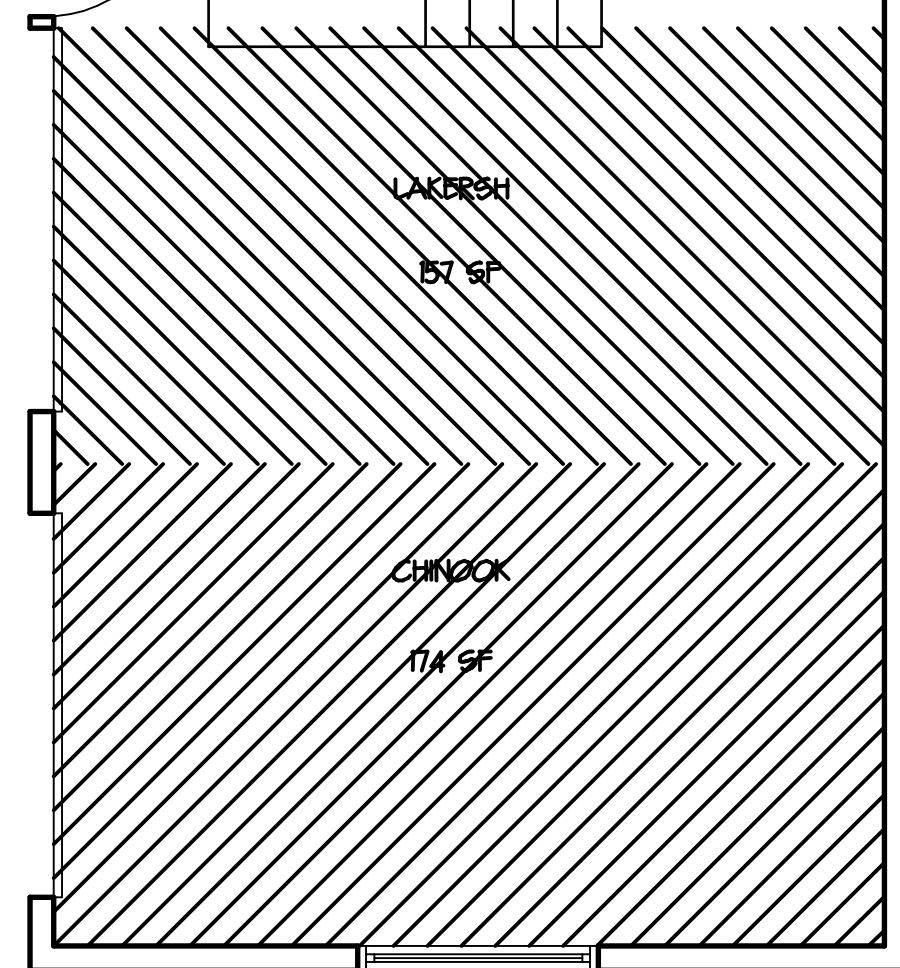


GARAGE = 423 GROSS SQ. FT.

2 FIRST FLOOR PLAN
 1/4" = 1'-0"

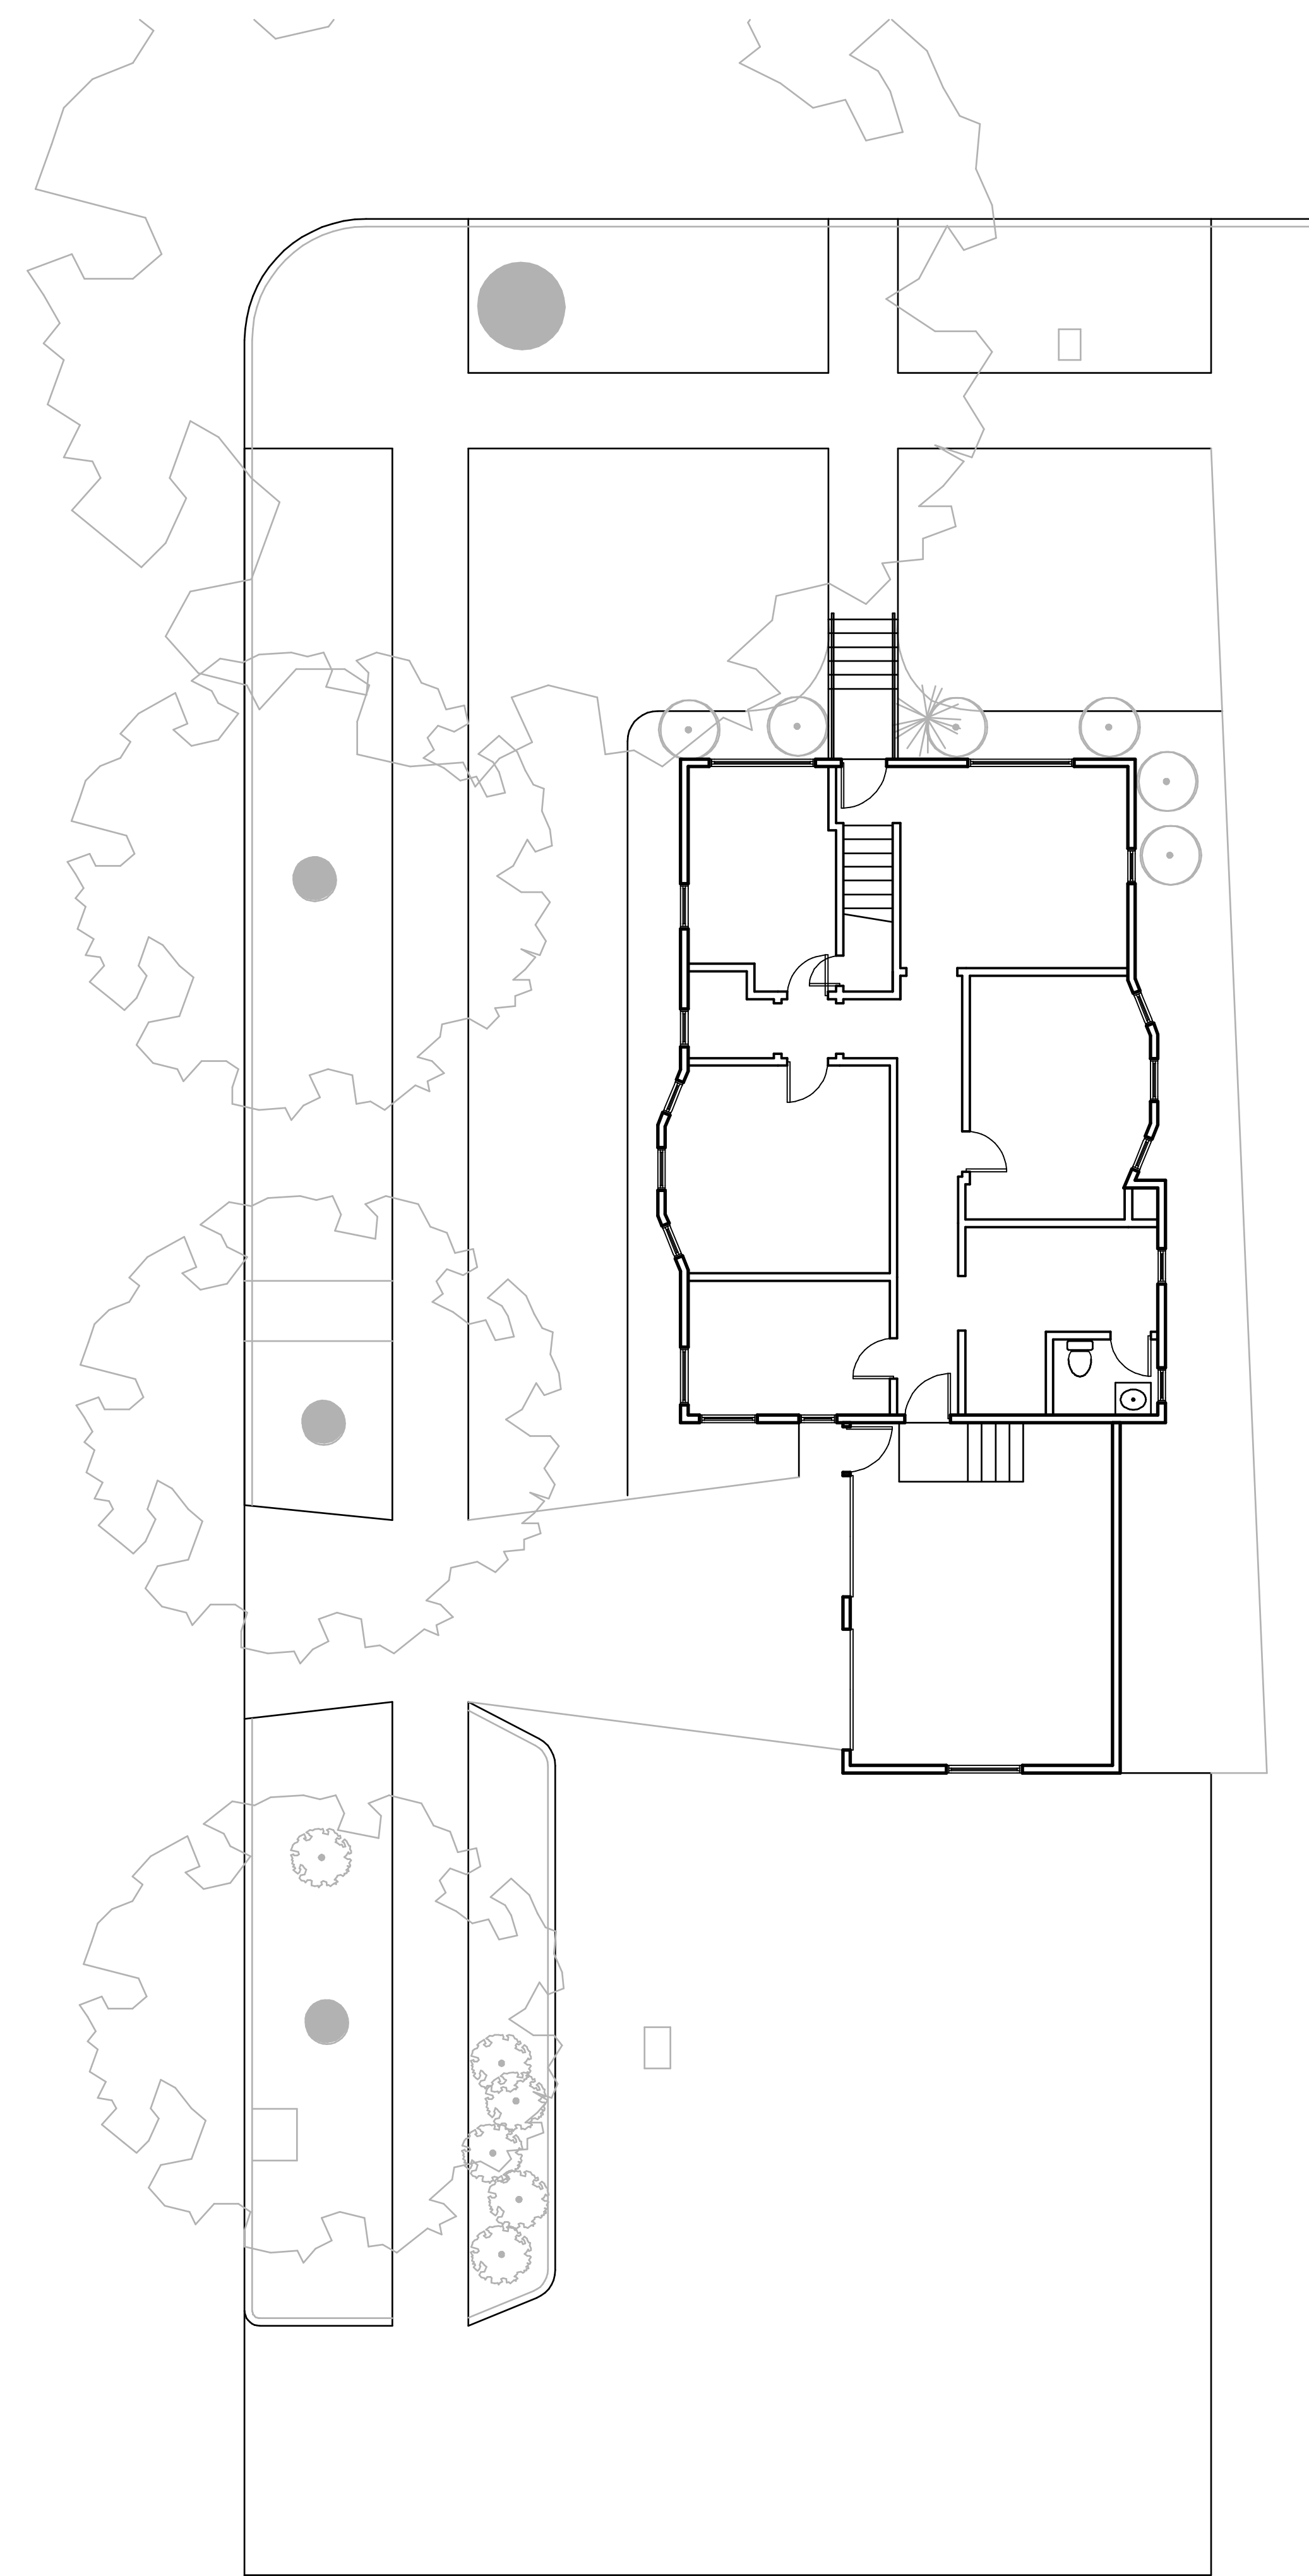

1 SITE PLAN
 1/8" = 1'-0"

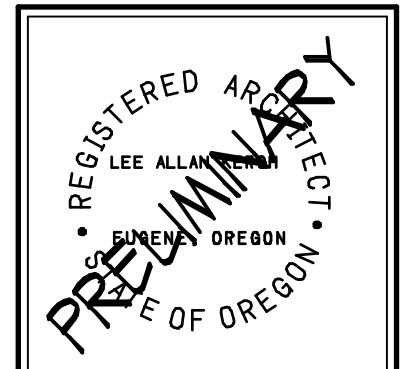

L. A. KERSH ARCHITECTURE, INC.
 292 W. 12TH AVE. SUITE A
 EUGENE, OREGON 97401
 (541) 334-6408
 www.lakersh.com
 © 2024

OWNER:
 LINCOLN VICTORIAN LLC
 292 W. 12TH AVE.
 EUGENE, OR 97401
 5413346408

AS BUILT DRAWINGS FOR THE:
 LINCOLN VICTORIAN LLC
 292 W. 12TH AVE.
 EUGENE, OR 97401

PROJECT NO.	DRAWN	CHECKED	DATE	REV. DATE
	LK	LK	7/3/10	

AI
 SHEET