


EAST TOWER

Entire 7th Floor | Suite 700E: 21,670 RSF
As-Built Plan | Available Now

1333

- FLOOR TO CEILING GLASS CURTAIN WALL
- WINDOWED
- VIRTUALLY COLUMN FREE

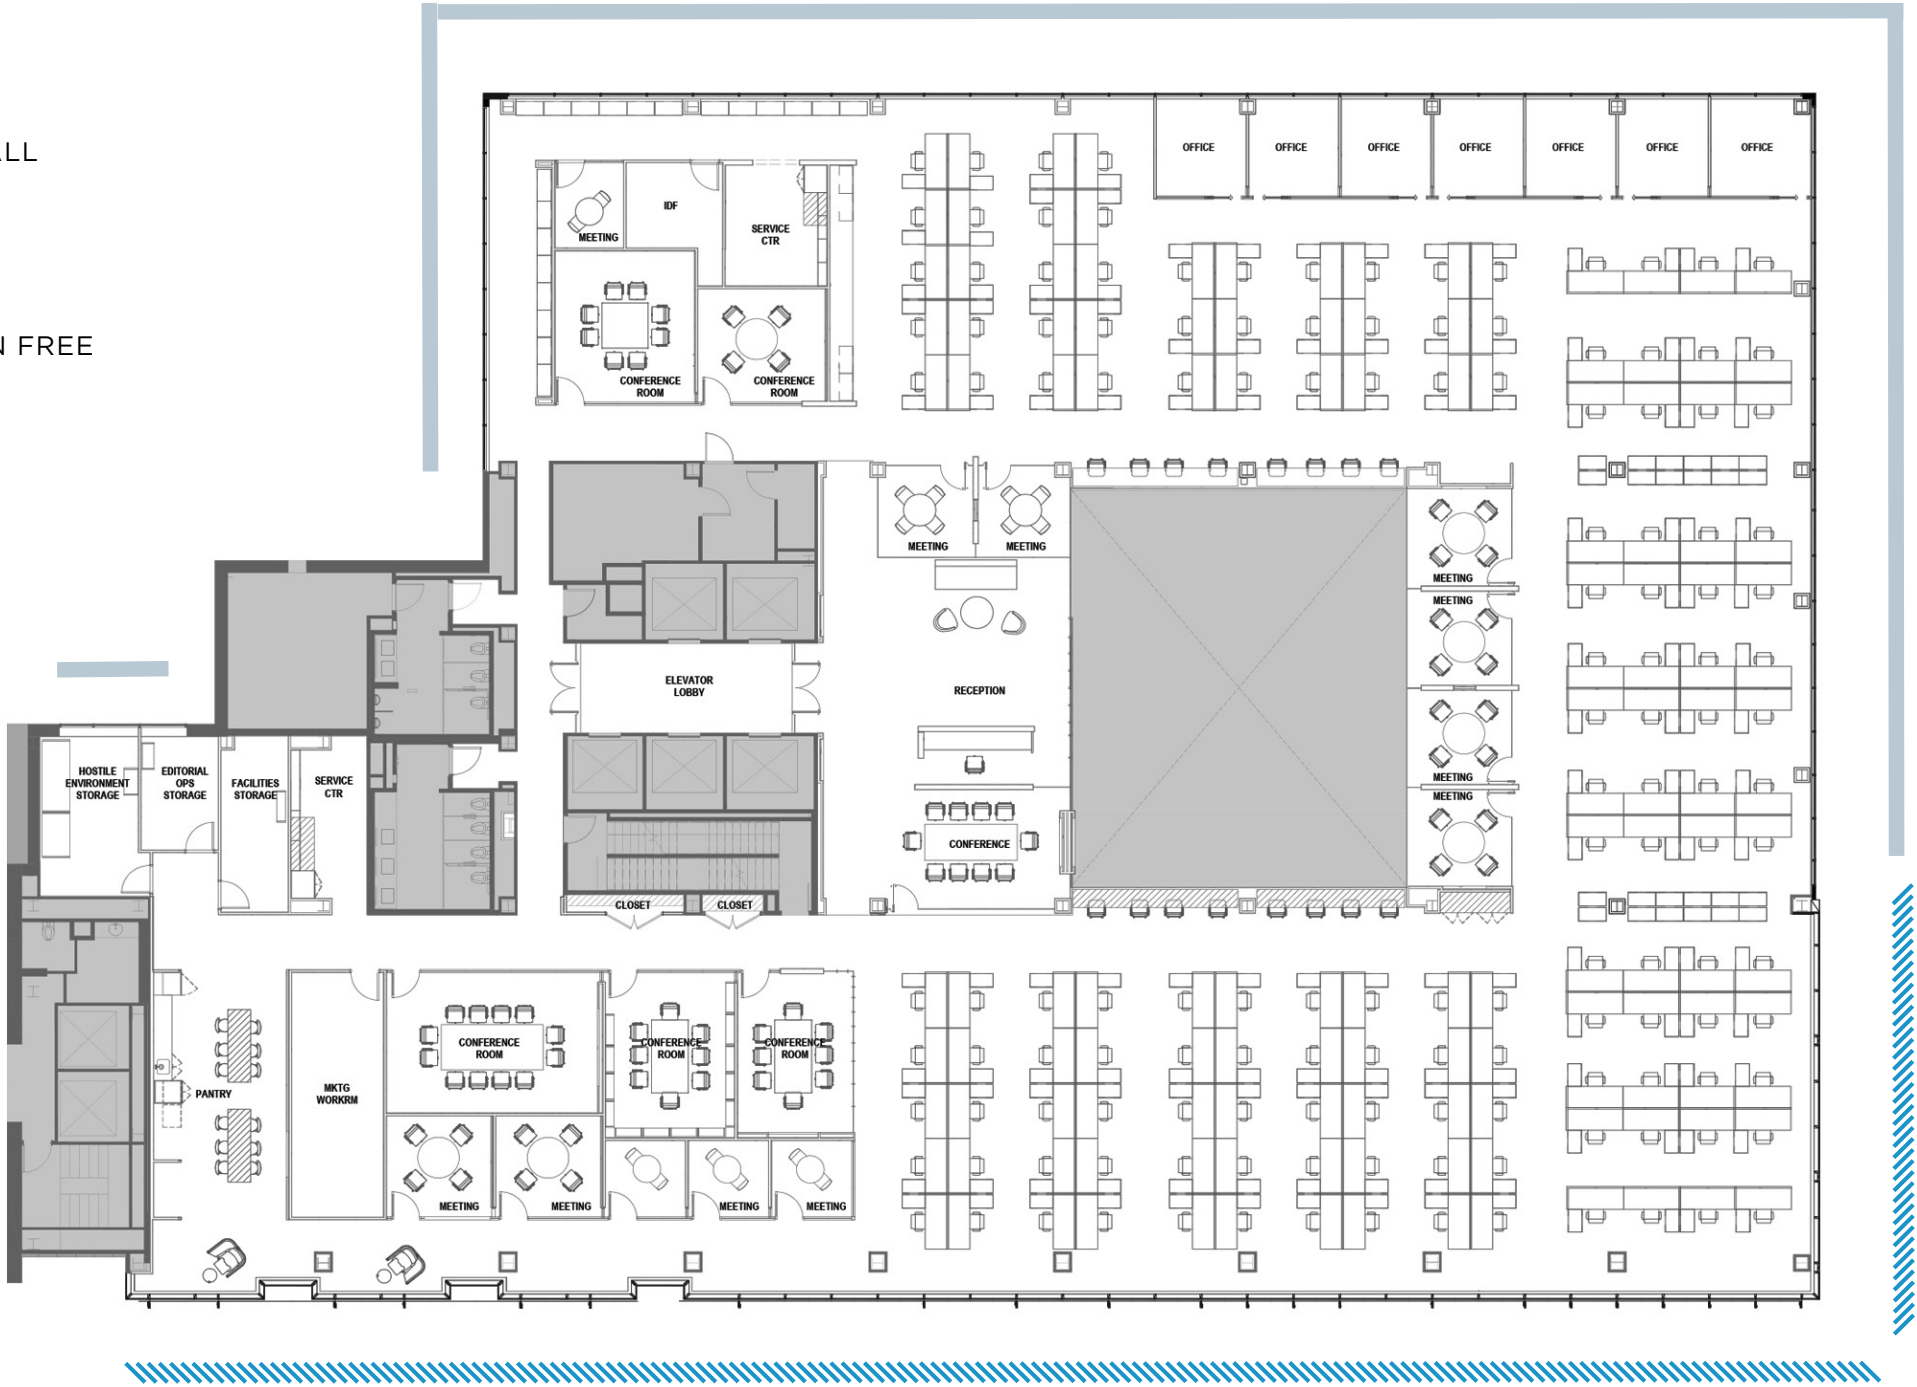

H STREET