


2 SECOND FLOOR PLAN
 SCALE: 1/4"=1'-0"
 ↓
 NORTH

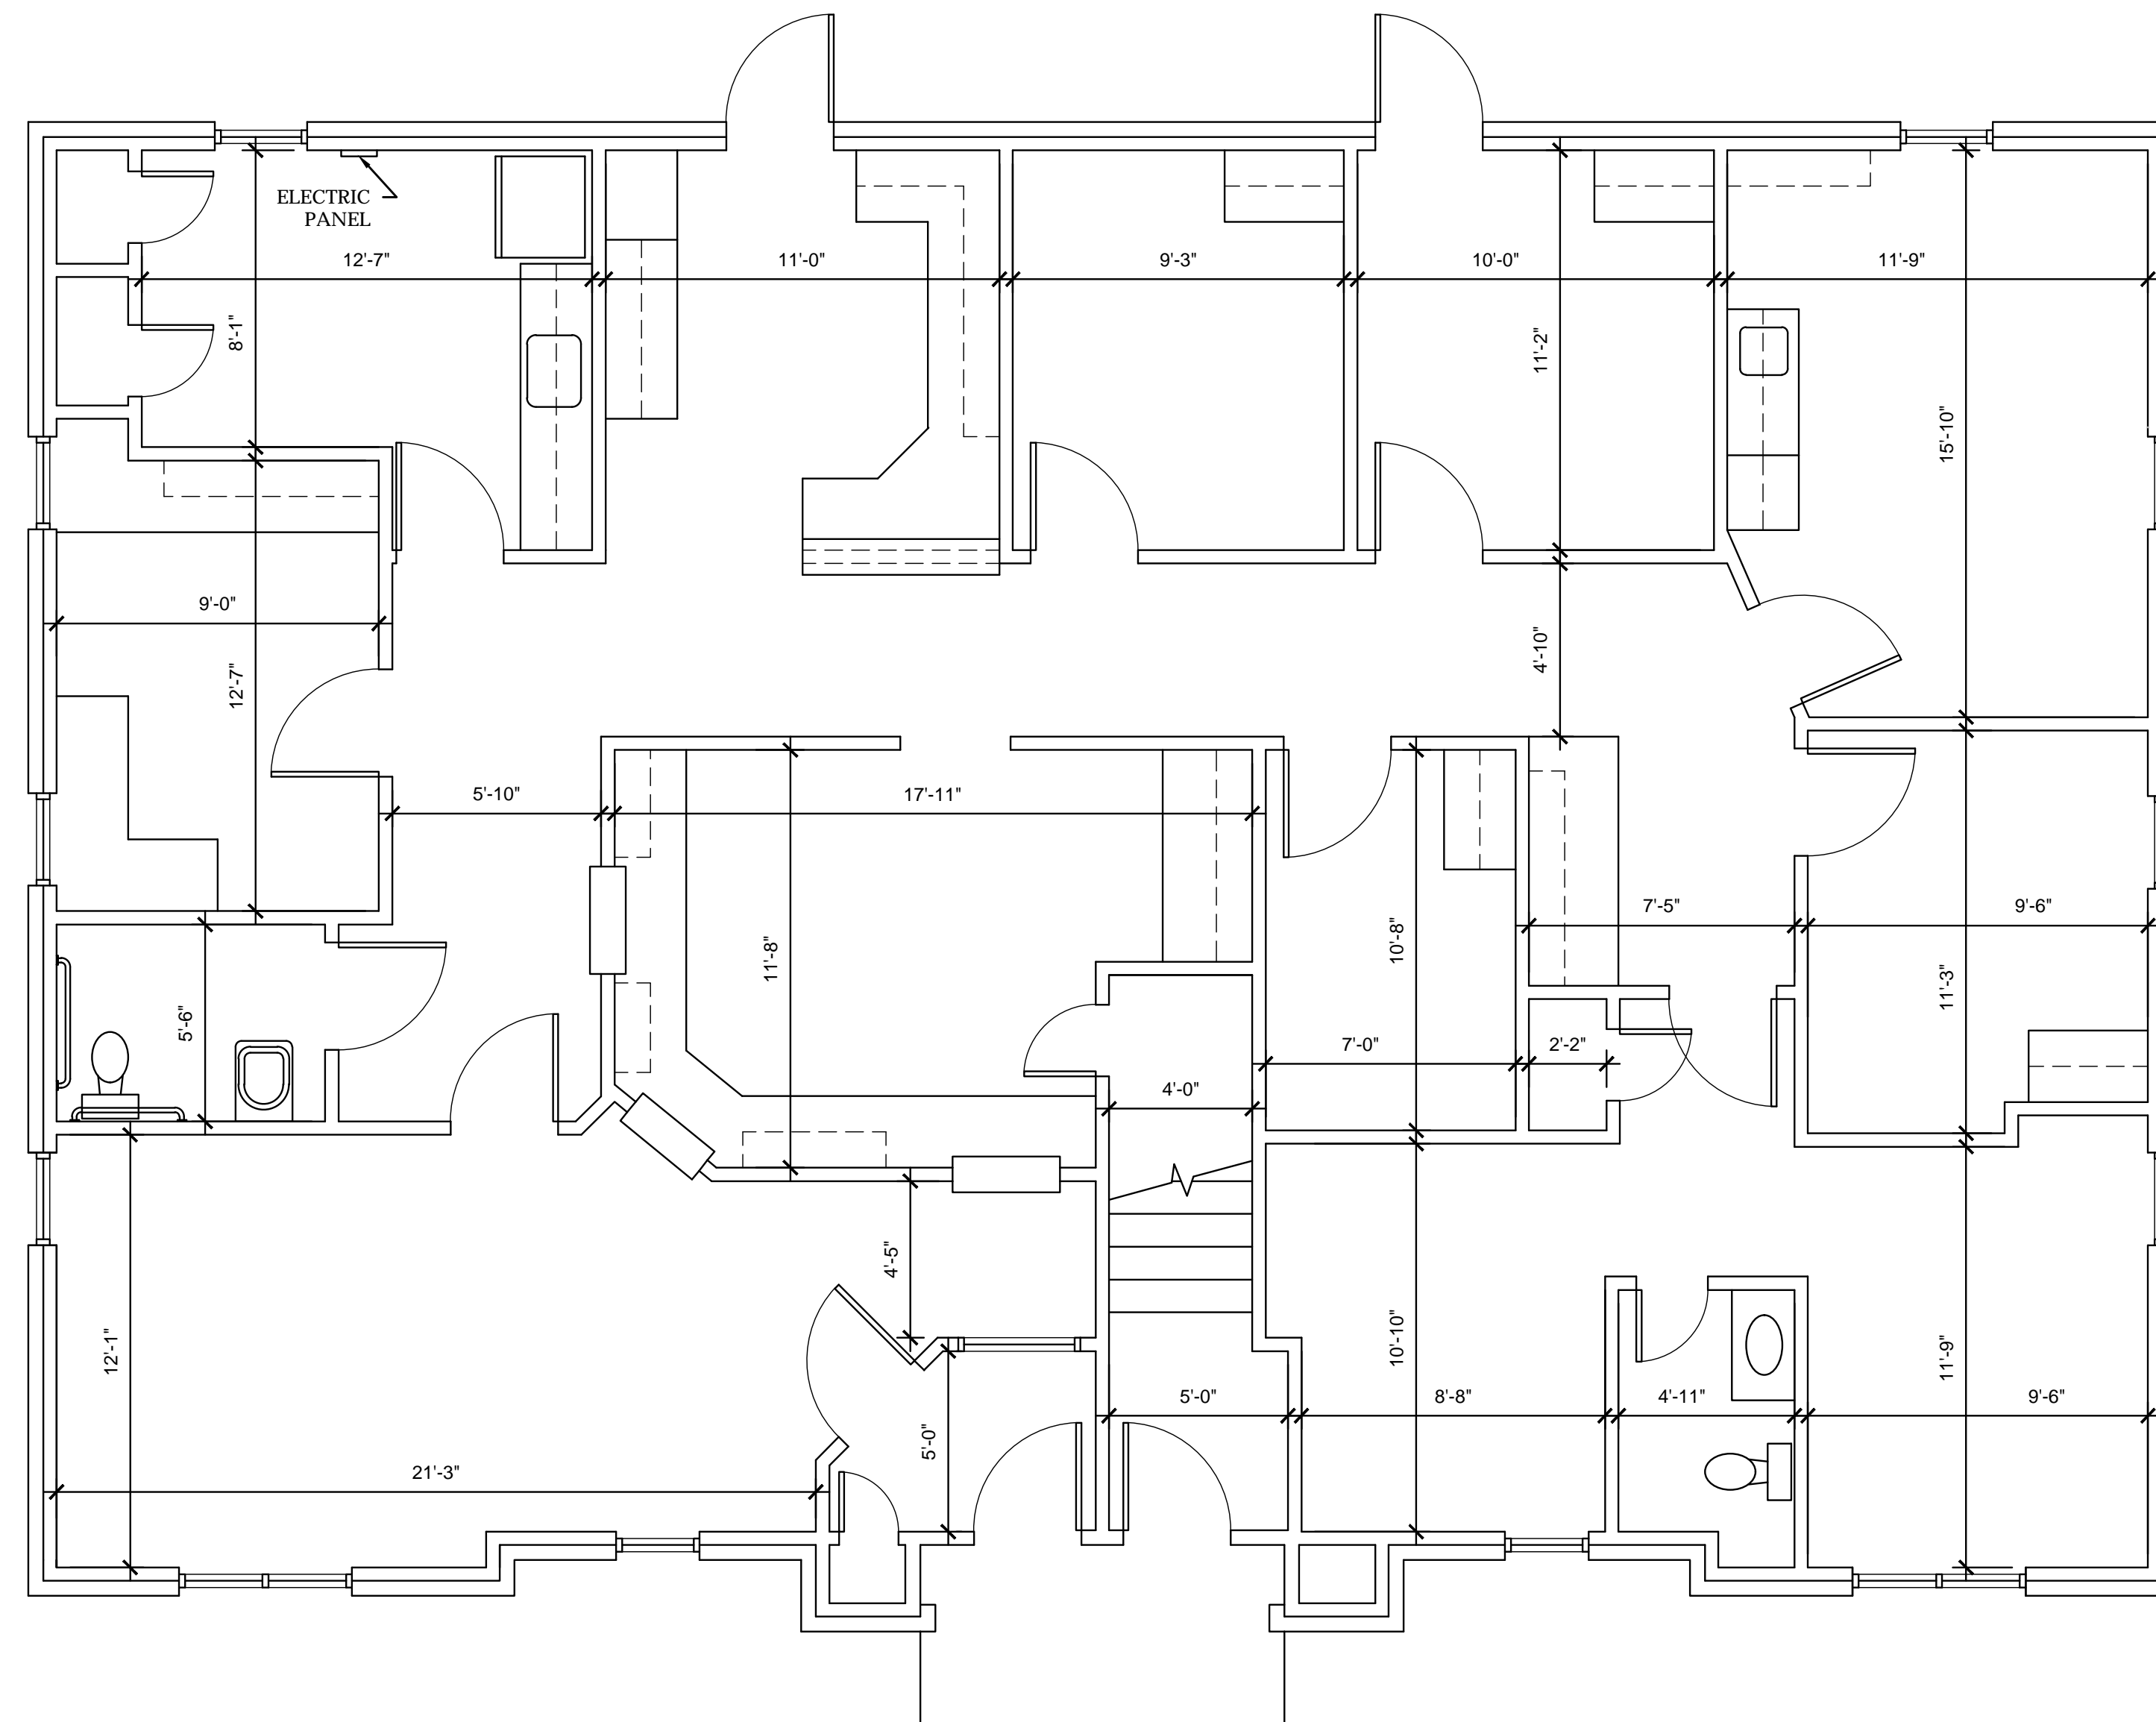

1 FIRST FLOOR PLAN
 SCALE: 1/4"=1'-0"
 ↓
 NORTH

AS BUILT FLOOR PLAN FOR:
 PINNACLE MEDICAL SOLUTIONS
 7165 GETWELL ROAD
 BUILDING H
 SOUTHAVEN, TENNESSEE

FLOOR PLANS

Client:
 Jim Brown

Project Number: 25103

Date: November 18, 2025

Revisions	