

CITY OF DES PLAINES
BUILDING DEPARTMENT
 APPROVED
 APPROVED AS NOTED
 NOT APPROVED REVISIONS REQUIRED
Date 12/17/2019 BY: afranco

H.C. LIFE SAFETY NOTES:

- Grab bars must be in accordance with the following:
- The diameter or width of a grab bar must be 1 1/4-inches to 1 1/2-inches.
 - The grab bar must have at least 1 1/4-inches clearance from the wall.
 - If the grab bar is set in a recess, the recess shall be a maximum of 3-inches deep and must extend at least 18-inches above the grab bar. IAC 400.310 (g)

All newly installed or replacement sidewalks are required to be accessible. IAC 400.510 (e) (10) (B)

Detectable warnings at curb ramps are required to be truncated domes in accordance with Highway Standards. The detectable warning must extend the width of the walking surface and extend for a distance of 24-inches in the direction of travel. The detectable warning must also contrast visually with the walking surface. IDOT BDE Memorandum 35-05.

Reach distance requirements are in accordance with the following:

- For a forward approach, the maximum high reach is 48-inches above the floor.
- For a forward approach, the minimum low reach is 15-inches above the floor.
- For a parallel approach, the maximum high reach is 54-inches above the floor.
- For a parallel approach, the minimum low reach is 9-inches above the floor.
- For a forward approach, with an obstruction 20-inches to 25-inches wide, the maximum high reach is 44-inches.
- For a parallel approach, with an obstruction a maximum of 34-inches high and 24-inches deep, the maximum high reach is 46-inches. IAC 400.220

Insulating materials, where concealed as installed in buildings of any type of construction, shall have a flame spread of 25 or less and a smoke-developed index of 450 or less when tested in accordance with ASTM E84. IBC 719.2

All exit signs must be illuminated at all times when the building is occupied. To assure continued illumination for duration of not less than 90 minutes in case primary power loss, the exit signs must be connected to an emergency electrical system that complies with Section 2702. LSC 7.10.4; 12.2.10

Tactile signage in accordance with ICC / ANSI A117.1 reading, "EXIT", is required at each door to an area of refuge, an exterior area for assisted rescue, an exit stairway, an exit ramp, an exit passageway, and the exit discharge. Signs must be installed adjacent to the latch side of the door, 60 inches above the floor measured to the center of the sign. IPC 1011.4 IPC 1011.3 LSC 7.10.1.3

Provide lighting for the illumination of the exit discharge if normally occupied during non-daylight hours.

Accessible routes shall be in accordance with the following:

- Floor surfaces shall be slip resistance. IAC 400.310 (a) ICC/ANSI A117.1 Chapter 4
- Changes in floor level up to 1/4-inch may be vertical. Changes in floor levels between 1/4-inch and 1/2-inch shall be beveled with a slope no greater than 1 in 2. Changes in floor level greater than 1/2-inch shall be accomplished by a ramp, curb ramp, elevator, or platform lift. IBC 1011.3

Where permanent identification is provided for rooms and spaces, accessibility signage shall be installed in accordance with the Illinois Environmental Barriers Act and ANSI A117.1. Signs shall be installed 5-feet above the floor to the centerline of the sign on the latch side of the door. IAC 400.310.u.5

Door thresholds cannot exceed 1/4-inch for swinging doors. IAC 400.310 (j) ICC/ANSI A117.1 405

Door hardware must comply with the following requirements:

- Closers shall be adjusted so that it takes at least 3-seconds for a door opened 70° to move to a position 3-inches from the latch.
- Door opening force shall be in accordance with the following:
 - Interior hinged doors shall have a maximum opening force of 5-pound-foot
 - Exterior hinged doors shall have a maximum opening force of 8.5-pound-foot

Door hardware must be installed no higher than 48-inches and cannot require tight grasping, pinching or turning of the wrist to operate. IAC 400.310 (i)

The intensity of floor lighting cannot be less than 1 foot-candle in all portions of the means of egress. IFC 1006.1 LSC 7.8.1.2; 12.2.8

The interior finish of all spaces/rooms must comply with the code requirements. IFC 1006.2 LSC 7.8.1.3; 12.2.8

Provide portable fire extinguishers within the building. The type, size, and spacing must match the specific hazard they are to protect. Contact the fire district for approval of the types and locations of portable fire extinguishers to be used prior to final occupancy. LSC 10.1; 10.2; 10.3; 12.3.3

Provide lighting for the illumination of the exit discharge if normally occupied during non-daylight hours. LSC 9.7.4 NFPA 10

STATE ADA NOTES

- ALL CONSTRUCTION TO COMPLY W/IL ACCOMMODATION CODE, APR. 1997
- AT LEAST 50% OF ALL PUBLIC ENTRANCES MUST BE ACCESSIBLE IAC 400.30
- IDENTIFY ROOMS W/APPROPRIATE SIGNAGE & LOC. AHEAD
- PROVIDE H.C. HARDWARE ALL DOORS IAC 400.306 (c)
- SELF CLOSING HANDBL, ANTI SCALP (10" MAX) ON HAND, 3/8" FLOORSTOPPER IN ACCORD W/ ASME / INCL. MAR. 10 '01
- ALL FLOOR COVERING MATERIALS TO BE SLIPRESISTANT (STATIC COEFFICIENT OF FRICTION 16, IAC 400.310 (c))
- ALL LITE & TO BE MTD. NO HIGHER THAN 54" AFF FOR REACH, & 48" AFF FOR FORWARD REACH IAC 400.306 (d)
- SAFETY GLAZING ALL REAR LOCATIONS
- COMPLY W/ INTERIOR FINISH & FLAME SPREAD RATINGS. NT. ITM NOT TO BE IN EXCESS OF 10% OF WALLS & CEIL. AREAS OF ANY ROOM OR SPACE SHALL BE OF CL I, II OR III, EXCEPT TRAIL AROUND FIRE ESC.

ALL TOILET RMS TO BE PROVIDED W/ A 30"x40" SECE ADJACENT TO H.C. NO FIXTURES ALLOWED TO ENCRUST IN SPACE WALL & CLG FINISHES TO BE 1/4" MIN IBC 803.9 CERTIFICATION

BUILDING DATA

OCCUPANCY GROUP B
ADJACENT OCCUPANCIES B
MIN SEPARATION - N/A
TTL BLDG AREA WEST 13,100 SF

OCCUPANCY LOAD: 18,100/100 181
CONST TYPE: IFS
COMMON PATH OF EGRESS TRAVEL 100'
EXIT TRAVEL DISTANCE 200'

36" MIN ABLE WIDTH
CODES: AS AMENDED BY CITY

2015 IBC
2013 IL STATE PLUMBING CODE
2015 MECH / GAS-FUEL CODES
2014 NEC
2015 IECC

I CERTIFY THAT THESE DRAWINGS WERE PREPARED IN MY OFFICE UNDER MY SUPERVISION AND TO THE BEST OF MY KNOWLEDGE COMPLY WITH THE BUILDING AND ZONING ORDINANCES OF THE CITY OF DES PLAINES, ILLINOIS.

JEFFERY J. HEANEY
8398
LICENSED ARCHITECT


11/30/2019

REVISIONS	BY
10/16/18	
11/19	
11/20/19	

INTERIOR REMODELING FOR
BMM LOGISTICS
2224 MINER ST, DES PLAINES, IL

Jeffery J. Heaney Architect A.I.A.
911 Washington Street • Glenview, IL • (847) 729-4190

Date	10/30/19
Scale	NTD
Drawn	JH
Job	18 178
Sheet	1
Of	3 Sheets

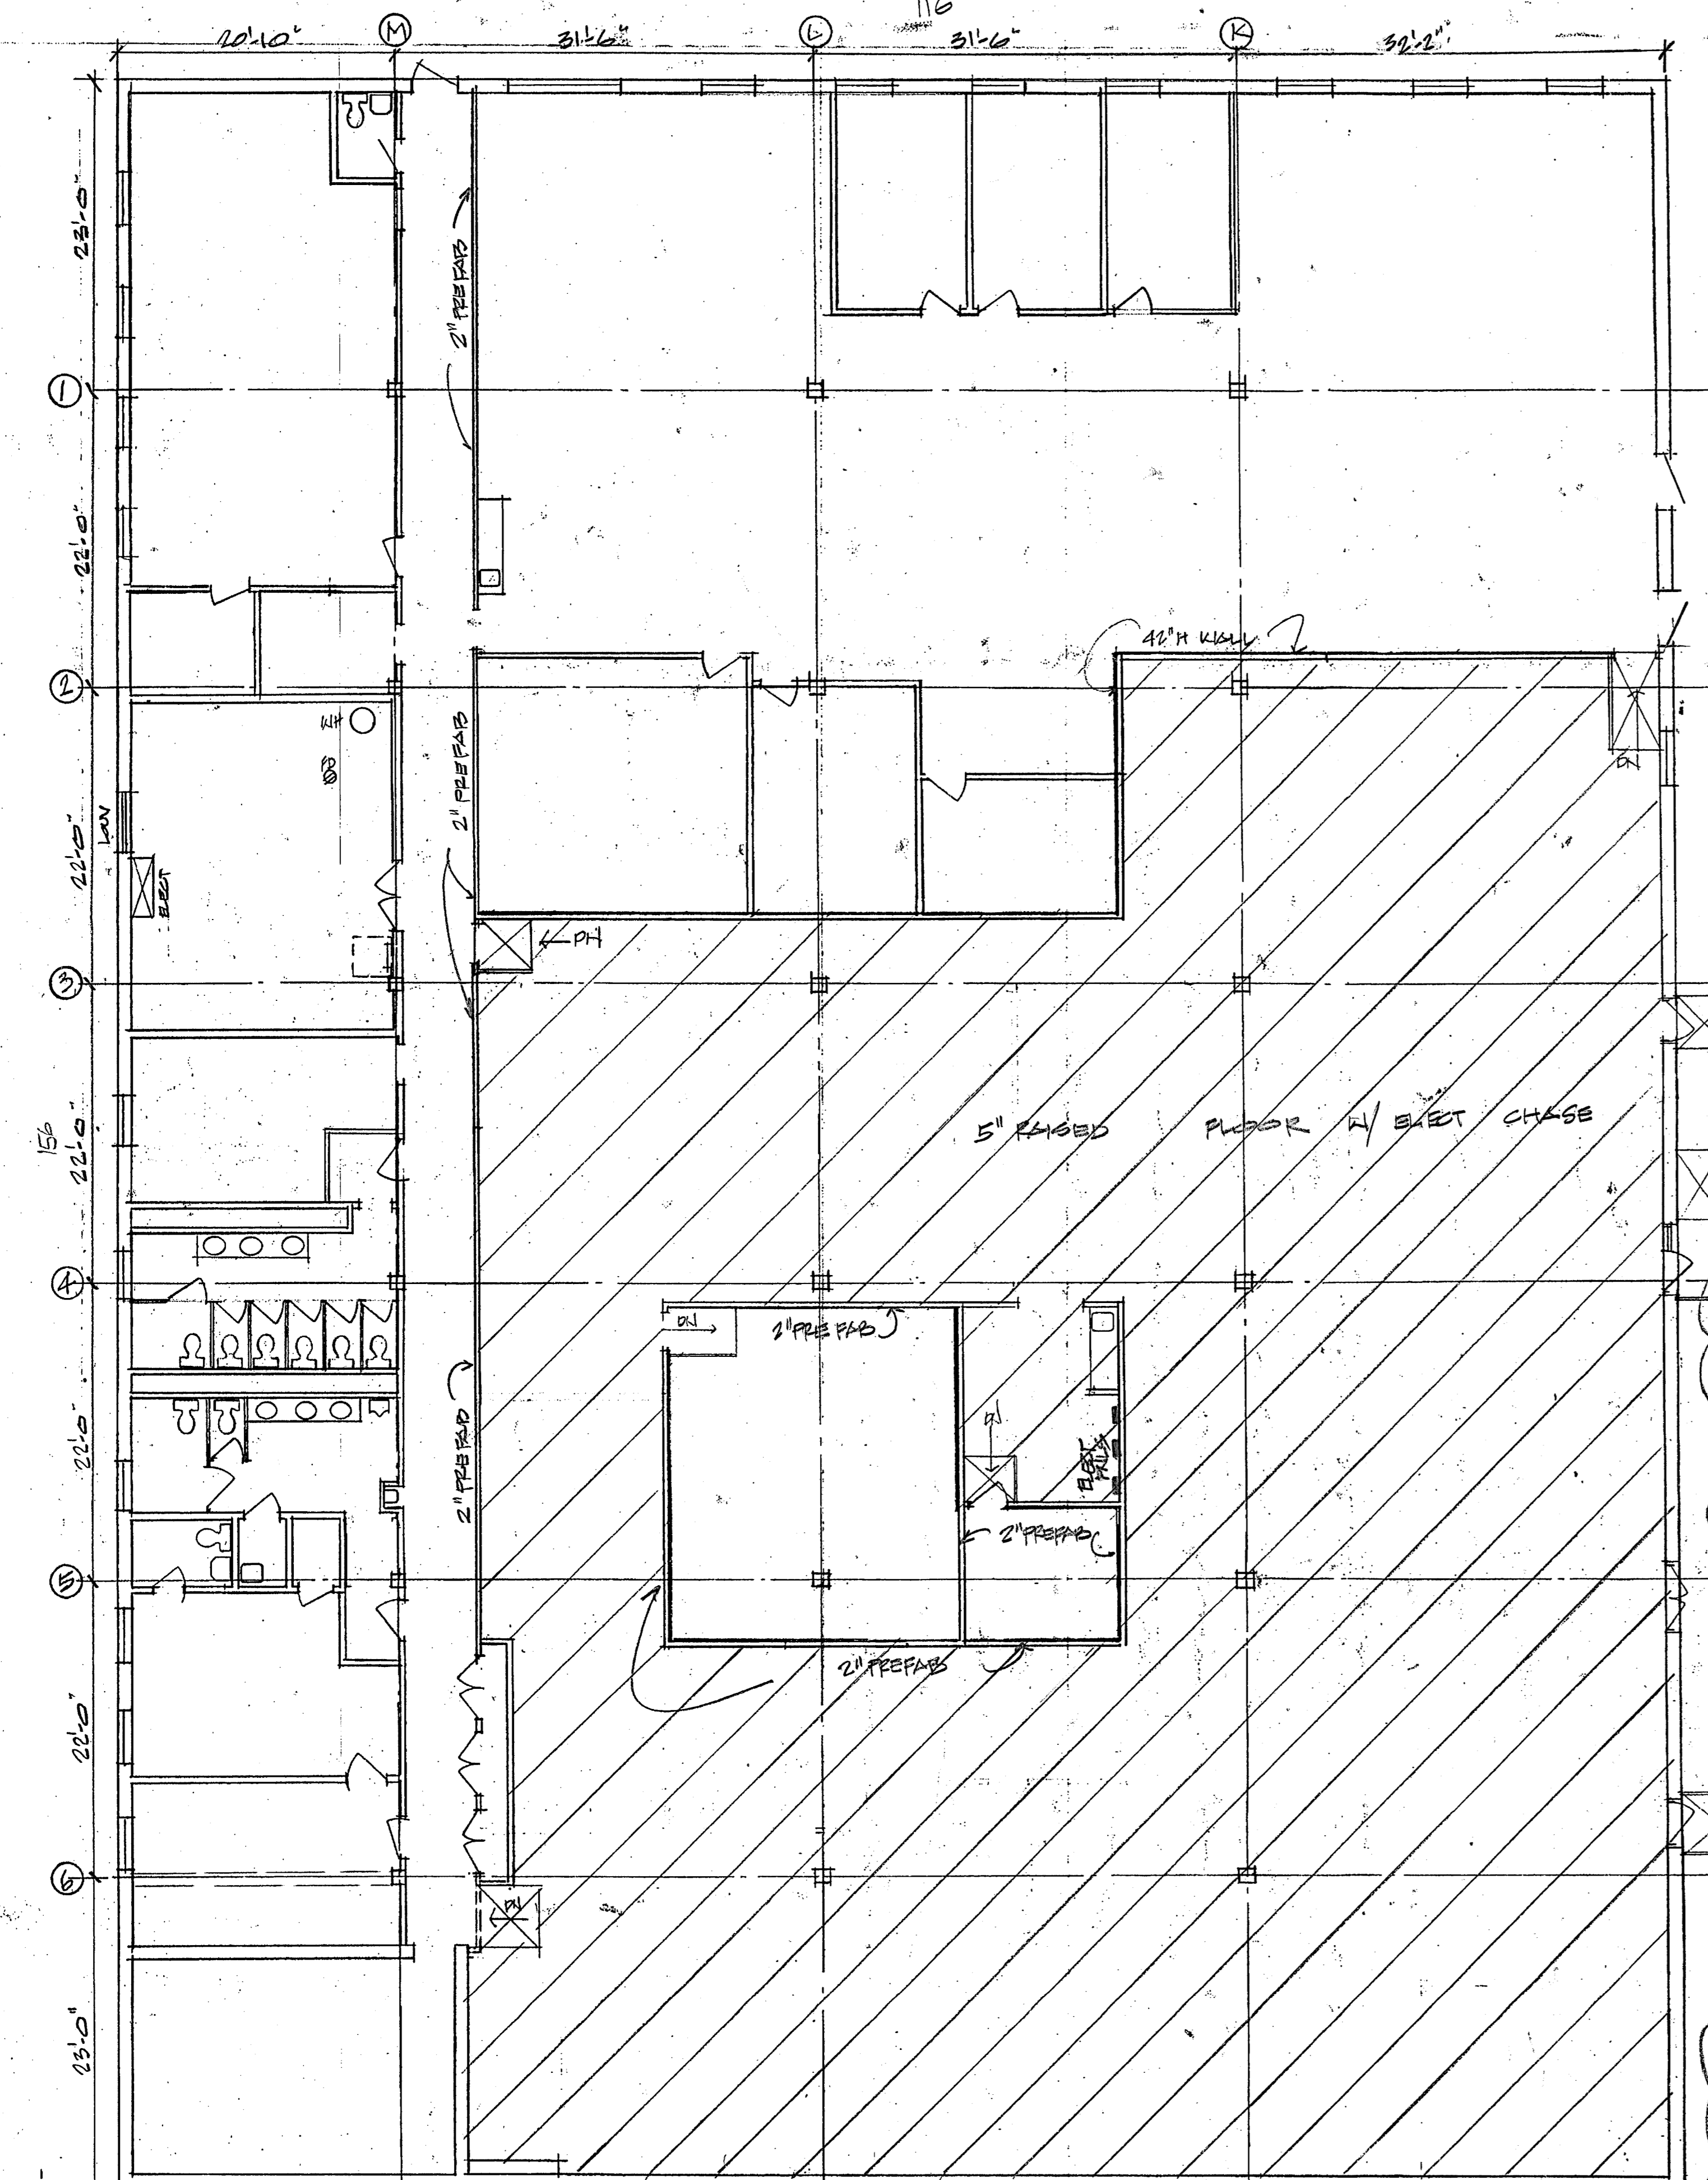

ACCESSIBILITY COMPLIANCE NOTE

Project to comply to IAC Sec. 400.510 (b), all elements to comply to:

- IAC Sec. 400.310 - New construction
- IAC Sec. 400.320 (k) Business & Mercantile.

All new doors to required areas and spaces will be 3'-0" min and have lever operated hardware or equal, and comply with ADA sections 4.13, 4.27, and IAC section 400.310 (J,R). All alarms to be audible and visual and will comply with both ADA section 4.28 and IAC section 400.310(S). Seating, tables and work surfaces - Provide 5% or at least one to comply fully with IAC section 400.310 (W). All vending machines not exceed 54" A.F.F. to highest operable part. All new doors leading into hazardous rooms to have knurled hardware. Accessible toilet rooms to have lever operated hardware or equal, and insulated pipes and shall comply with both ADA sections 4.16 & 4.17 and IAC sections 400.310 (m, n, & o). Signage will comply with both ADA section 4.30 and IAC section 400.310 (U). Accessible entrance must comply to IAC section 400.310 (K). All environmental controls to be 15" - 45" A.F.F. and comply to IAC section 400.310 (R). Public telephones comply with 400.310 (V). Parking to comply to IAC section 400.310 (L,C), provide diagonal striping, signage, and international symbol on pavement.

INDEX OF DRAWINGS

- | NO | DESCRIPTION |
|----|--|
| 1 | EXISTING AS BUILT, H.C. NOTES, BLDG DATA |
| 2 | DEMOLITION PLAN, GUARD |
| 3 | 1/8" NEW CONSTRUCTION, WALL SECT, RAMP DETAILS |
| 4 | 1/4" TOILET ROOMS, CONF RM PLAN |
| 5 | 1/4" DATA RM SW, CORNER PLAN |
| E1 | 1/4" FLOORING PLAN, ISOMETRICS |
| E1 | 1/8" ELECT PLAN |
| E2 | 1/8" REFLECTED CLG, LIGHTING, EHR, LIGHTING PLAN |

ARCHITECT COMPLIANCE STATEMENTS

I have prepared or caused to be prepared under my direct supervision, the attached plans and specifications and state that to the best of my knowledge and belief and to the extent of my contractual obligation, they are in compliance with the Environmental Barriers Act (410 ILCS 25) and the Illinois Accessibility Code (71 ILCS 400).


I certify that these drawings were prepared by me or under my direct supervision and control and to the best of my knowledge and belief comply with the requirements of the Chicago Building Code.

Signature: [Signature]
Date: 11/18/19


Signature: [Signature]
Date: 11/18/19

11/30/20
Affix Original Professional Seal Here


FLOOR PLAN EXISTING AS BUILT
1/8"=1'-0"
EXISTING AREA WEST BLDG 13,096 SQ. FT.

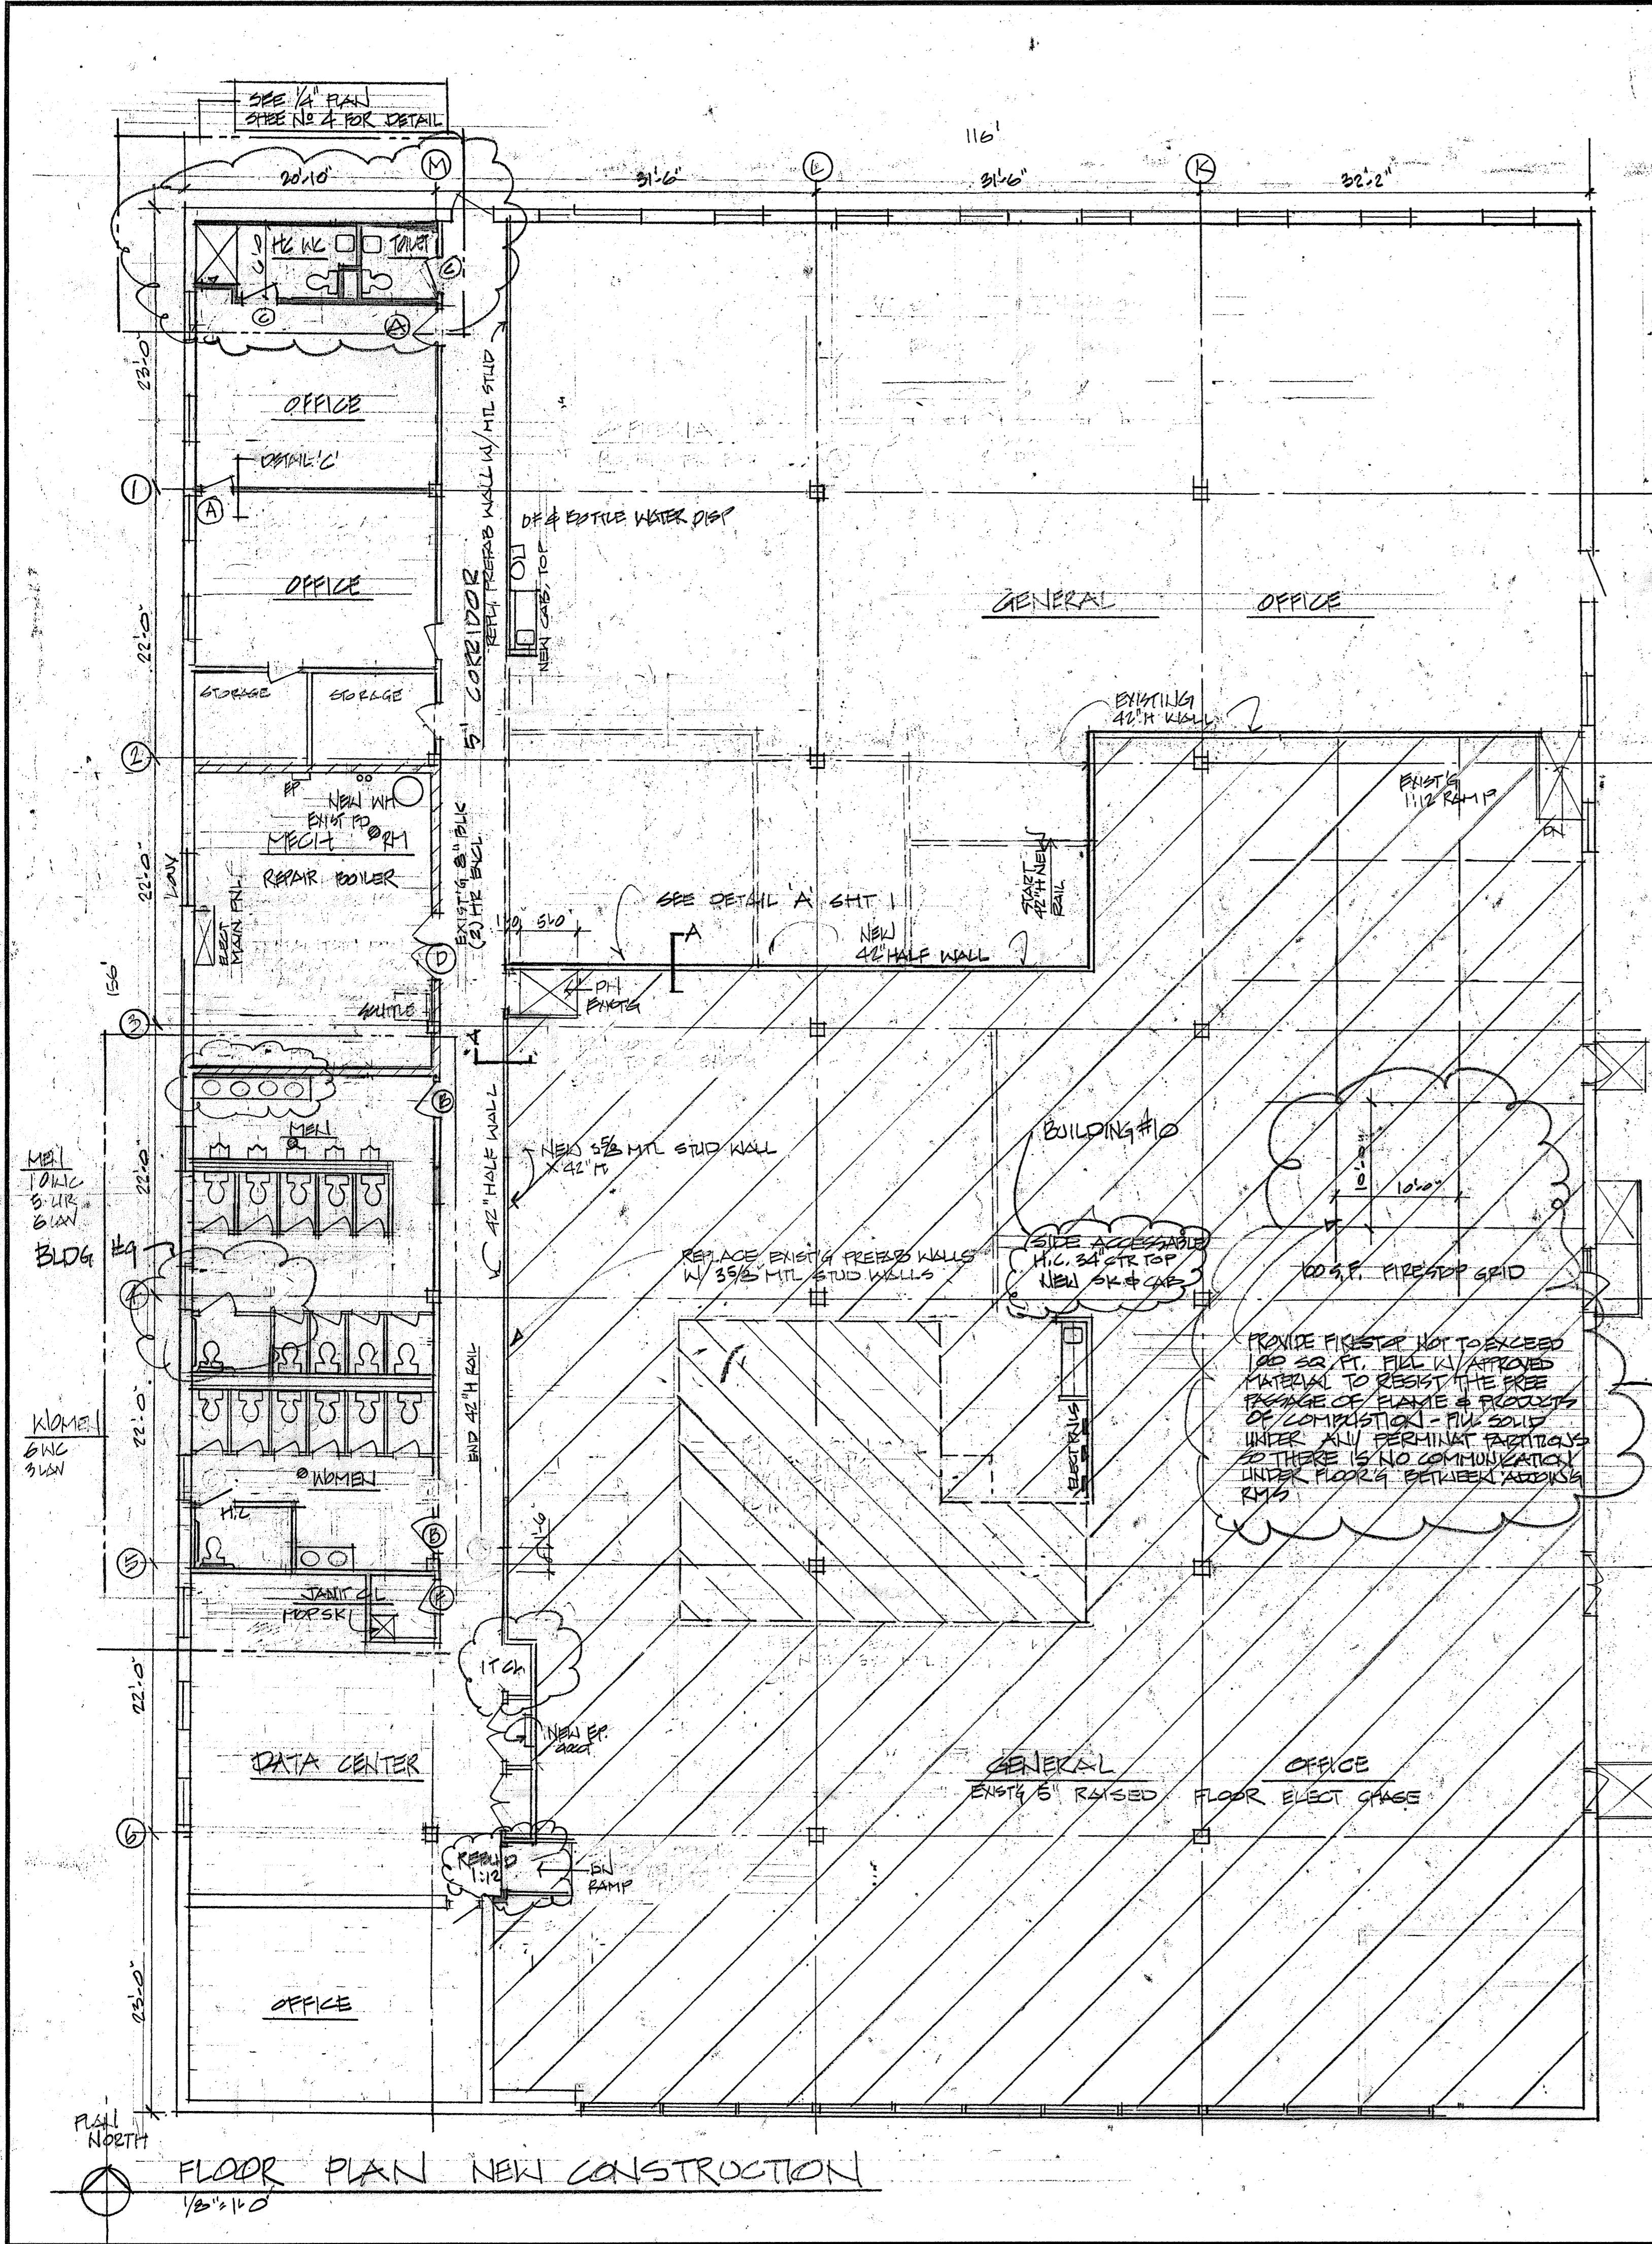

Egress door hardware shall be operable from the side egress is to be made without the use of a key or special knowledge or effort. Door handles, pulls, latches, locks and other devices shall be at a minimum height of 34 inches and a maximum height of 48 inches above the finished floor. The operating device shall be capable of operation with one hand and shall not require tight grasping, tight pinching, or twisting of the wrist to operate. Thumb-turn devices are not permitted.
IBC 1008.1.8, 1008.1.8.1, 1008.1.8.2, 1008.1.8.3

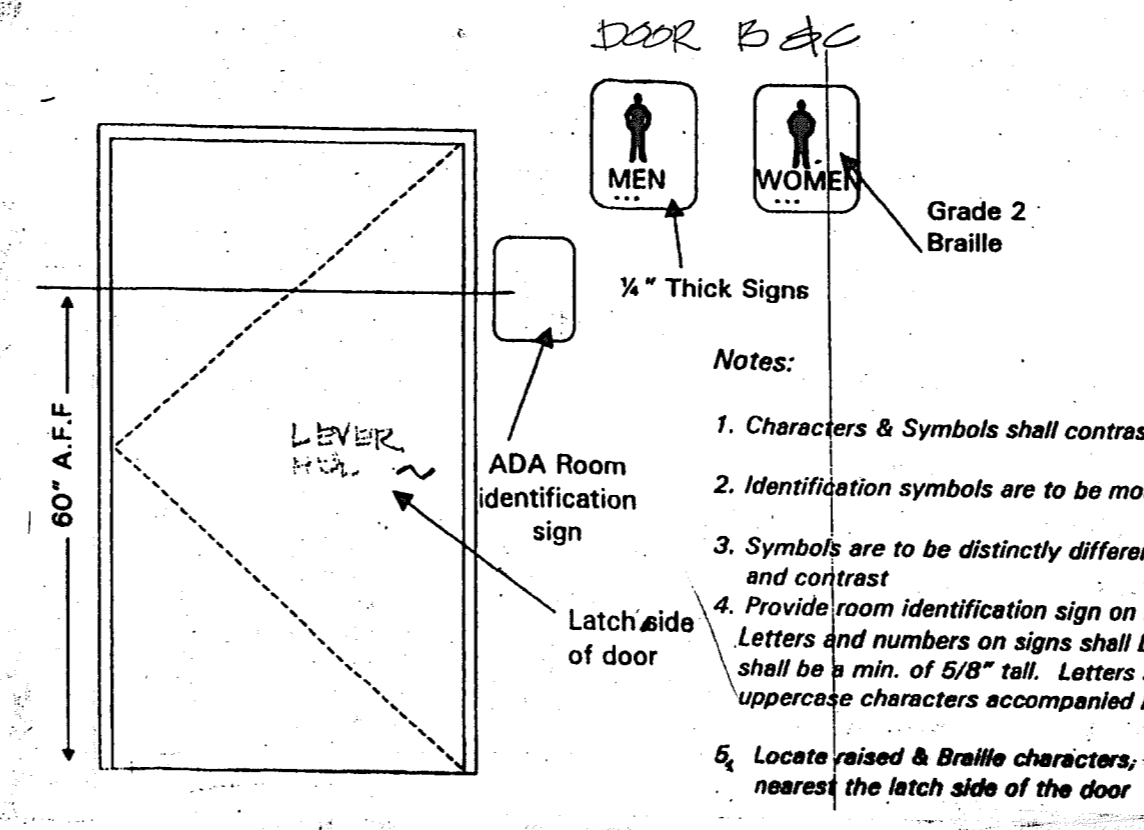

- Symbols of Accessibility
- Public telephones
 - Handicapped parking spaces
 - Accessible passenger loading zones
 - Accessible entrances when not all are accessible
 - Accessible restrooms, bathing and shower facilities when not all are accessible

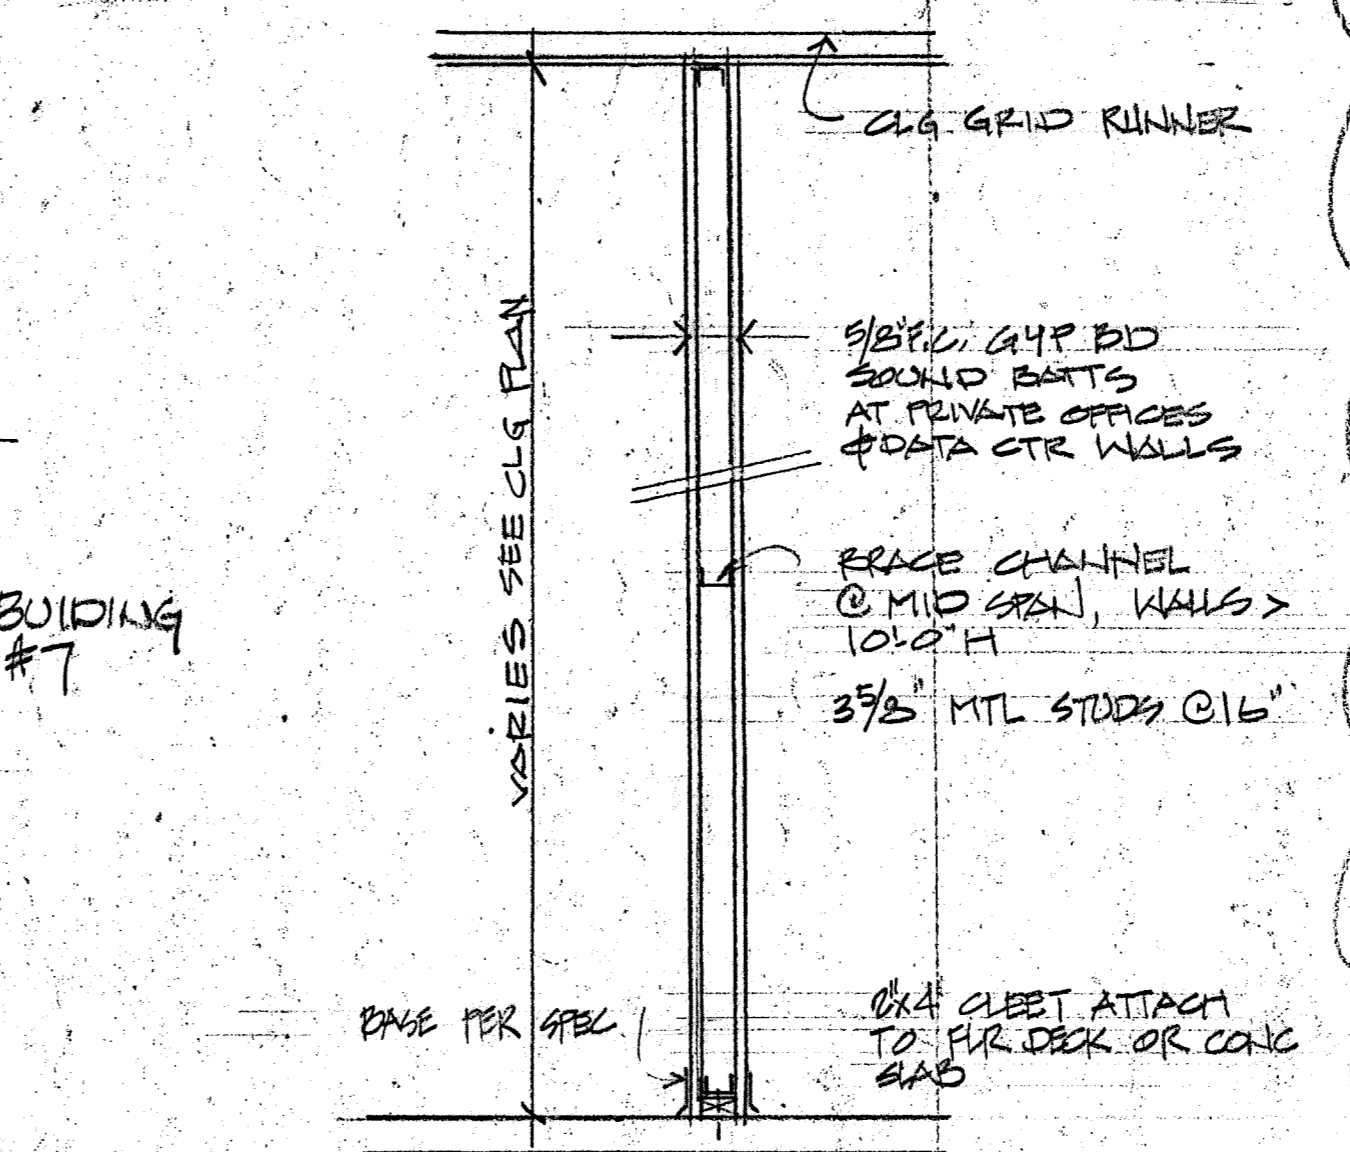


NEW INTERIOR WALL
1/2\"/>


DOOR SCHEDULE

MK	SIZE	TYPE	FRAME	REMARKS/HARDWARE
A	3'0\"/>			
B	3'0\"/>			
C	3'0\"/>			
D	3'0\"/>			
E	3'0\"/>			
F	3'0\"/>			


NOTE ALL EXIST'G HARDWARE TO COMPLY W/ STATE ADA REQTS
CONFIRM KEY & LOCKING REQTS W/O
ALT REPL EXIST'G OFFICE/CONFIRM DES W/ 10\"/>

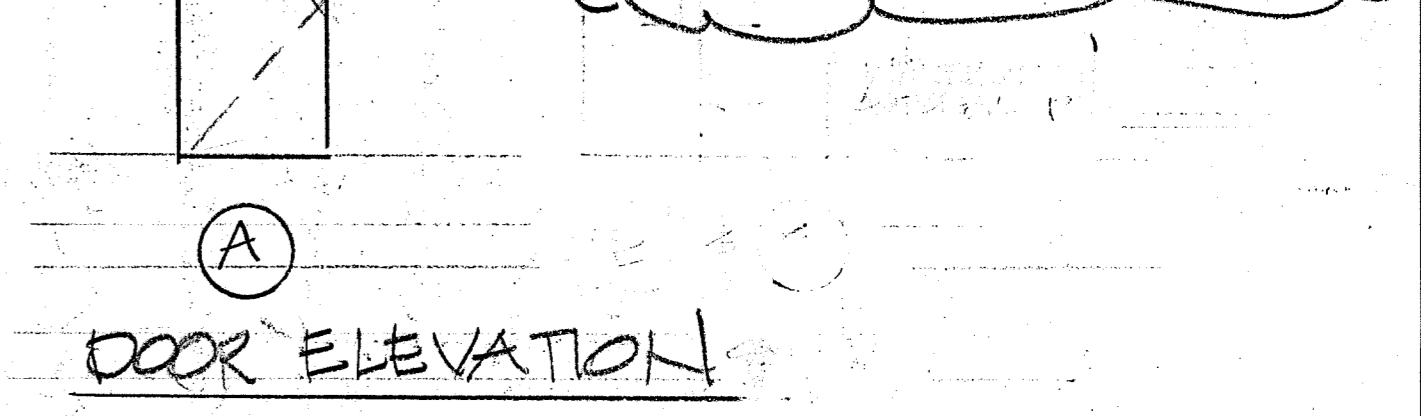


DOOR ELEVATION

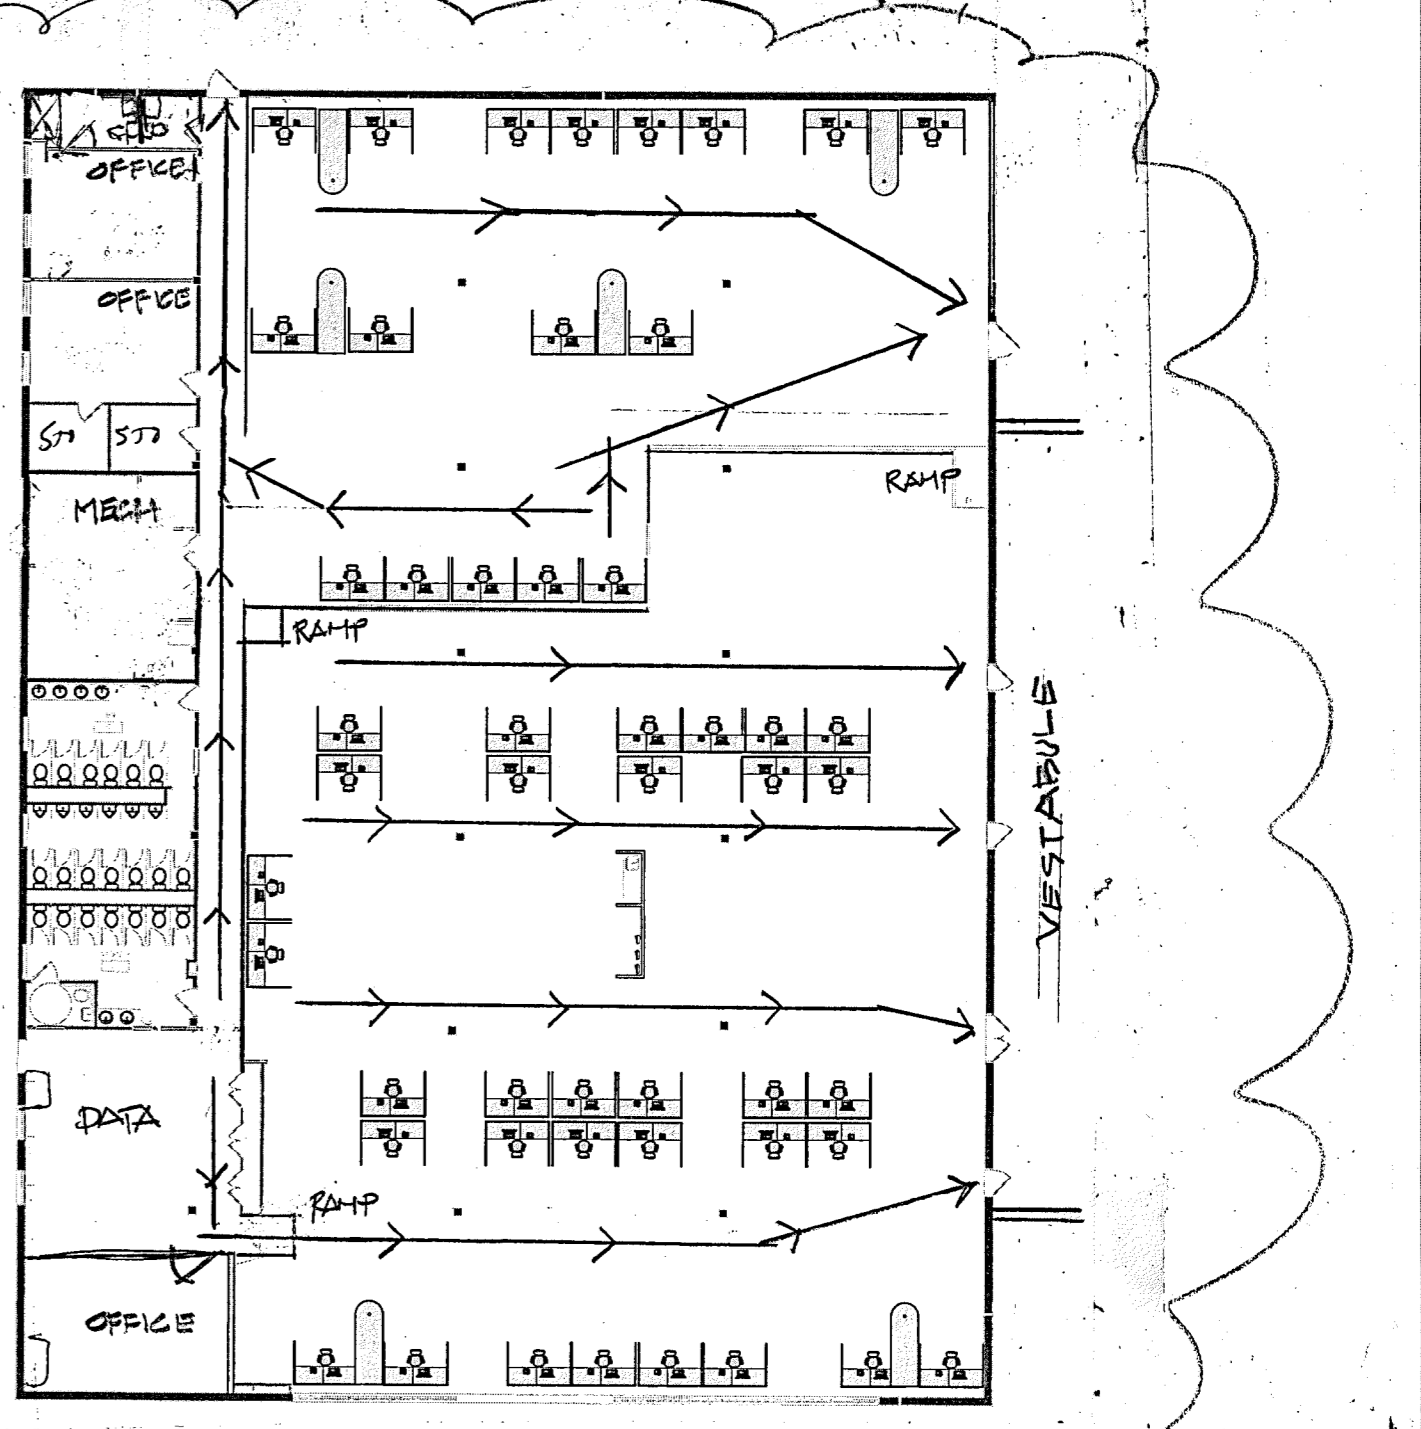


FIRE EVACUATION PLAN
NO GASLS

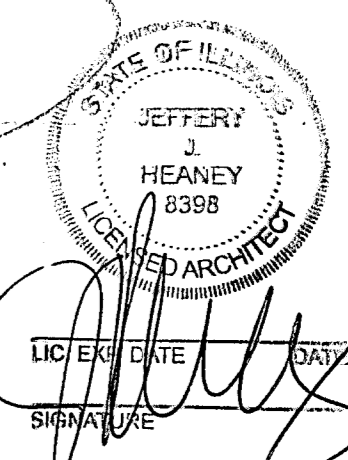

REVISIONS	BY
11/2/18	
11/20/19	

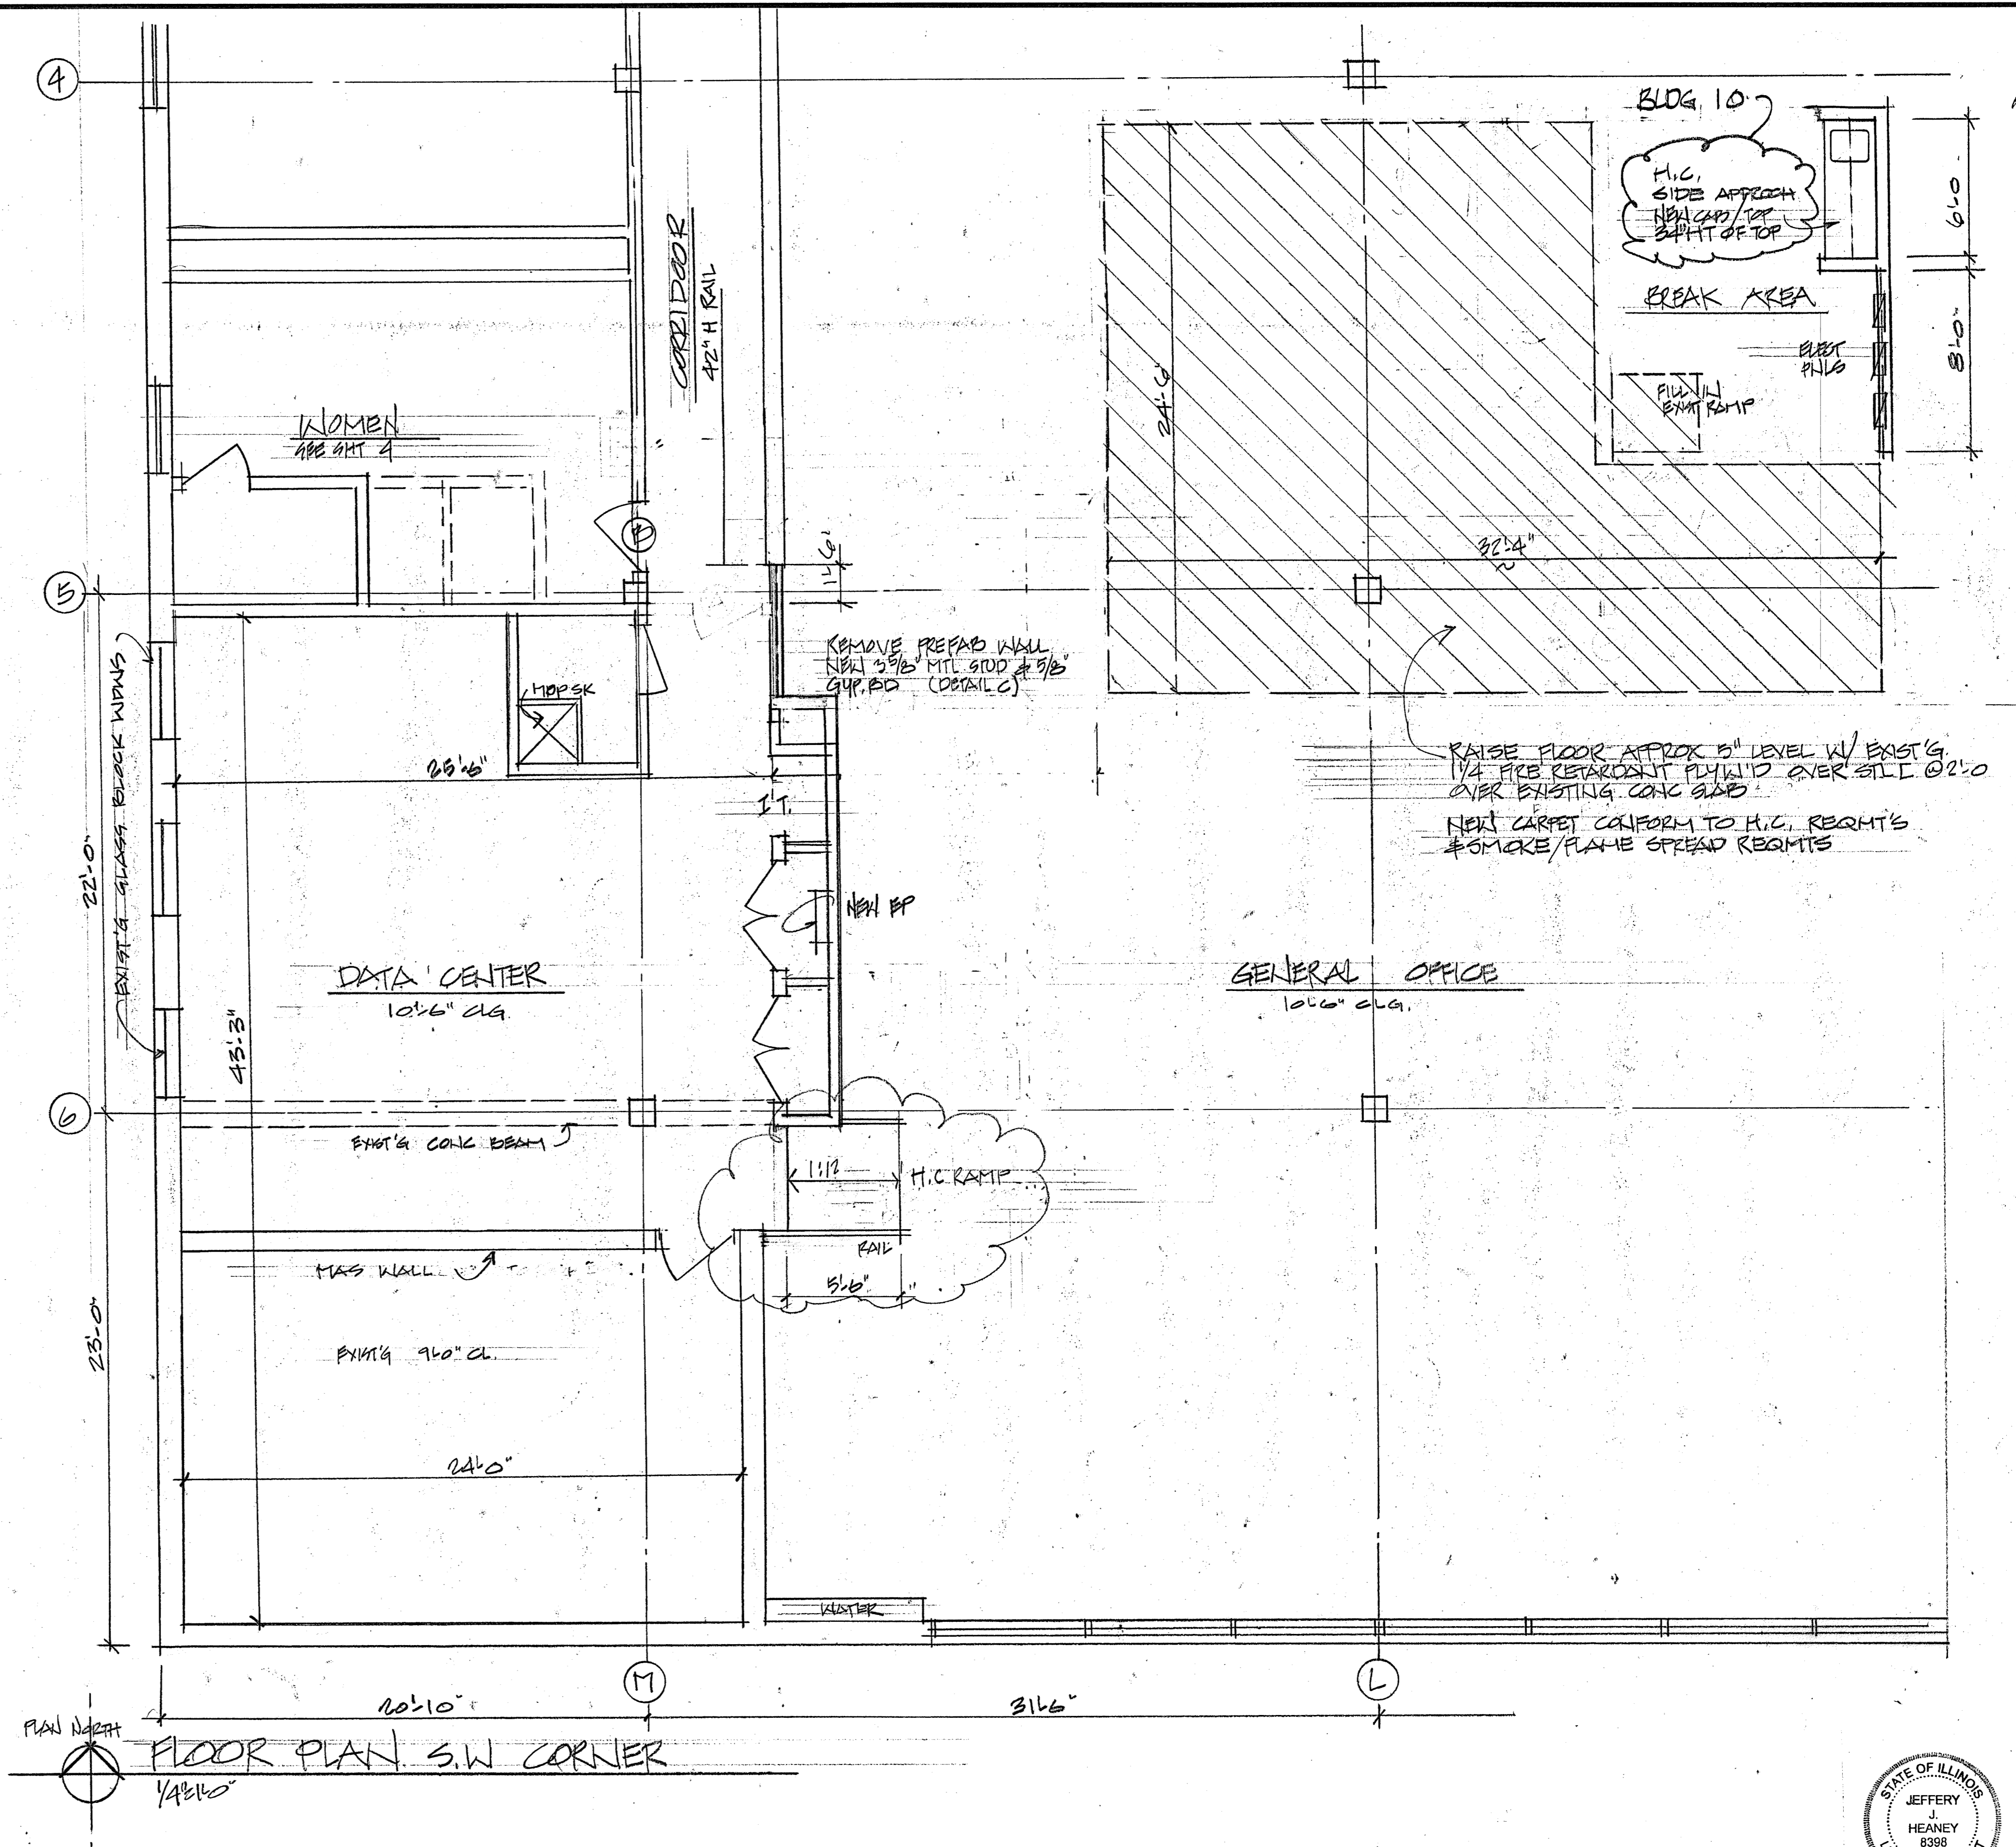

FLOOR PLAN S.W CORNER
48110

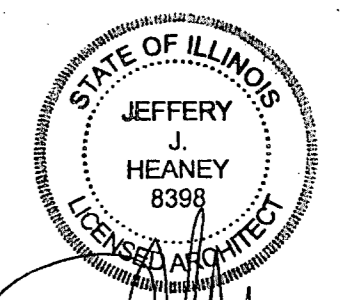

LIC. EXP. DATE 11/30/18
SIGNATURE


INTERIOR REMODELING FOR
EMM LOGISTICS
2004 MINER ST, DES PLAINES, IL

Jeffery J. Heaney Architect A.I.A.
911 Washington Street • Glenview, IL • (847) 729-4190


Date	10/30/18
Scale	1/4" = 1'-0"
Drawn	JH
Job	18-113
Sheet	5
Of 8	Sheets

1/4" FLR PLAN SW CORNER
2004 MINER ST DES PLAINES

REVISIONS	BY
11/12/18	

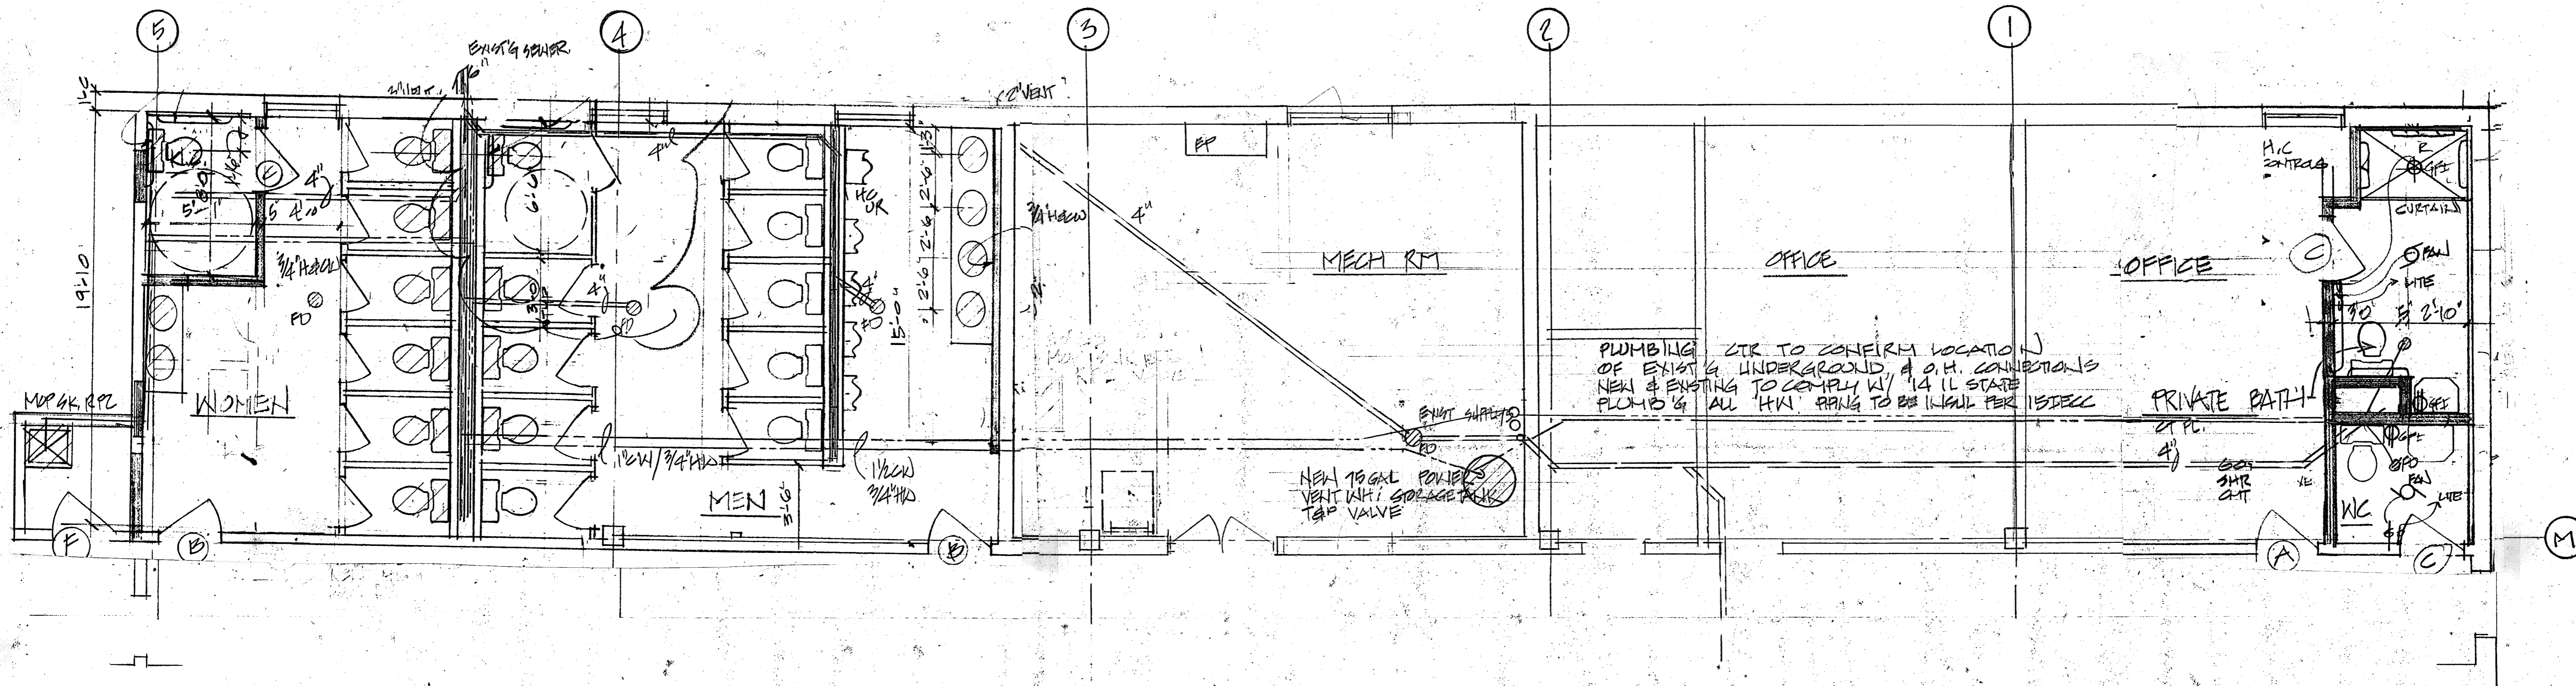


PLUMBING PLAN
1/4"=1'-0"

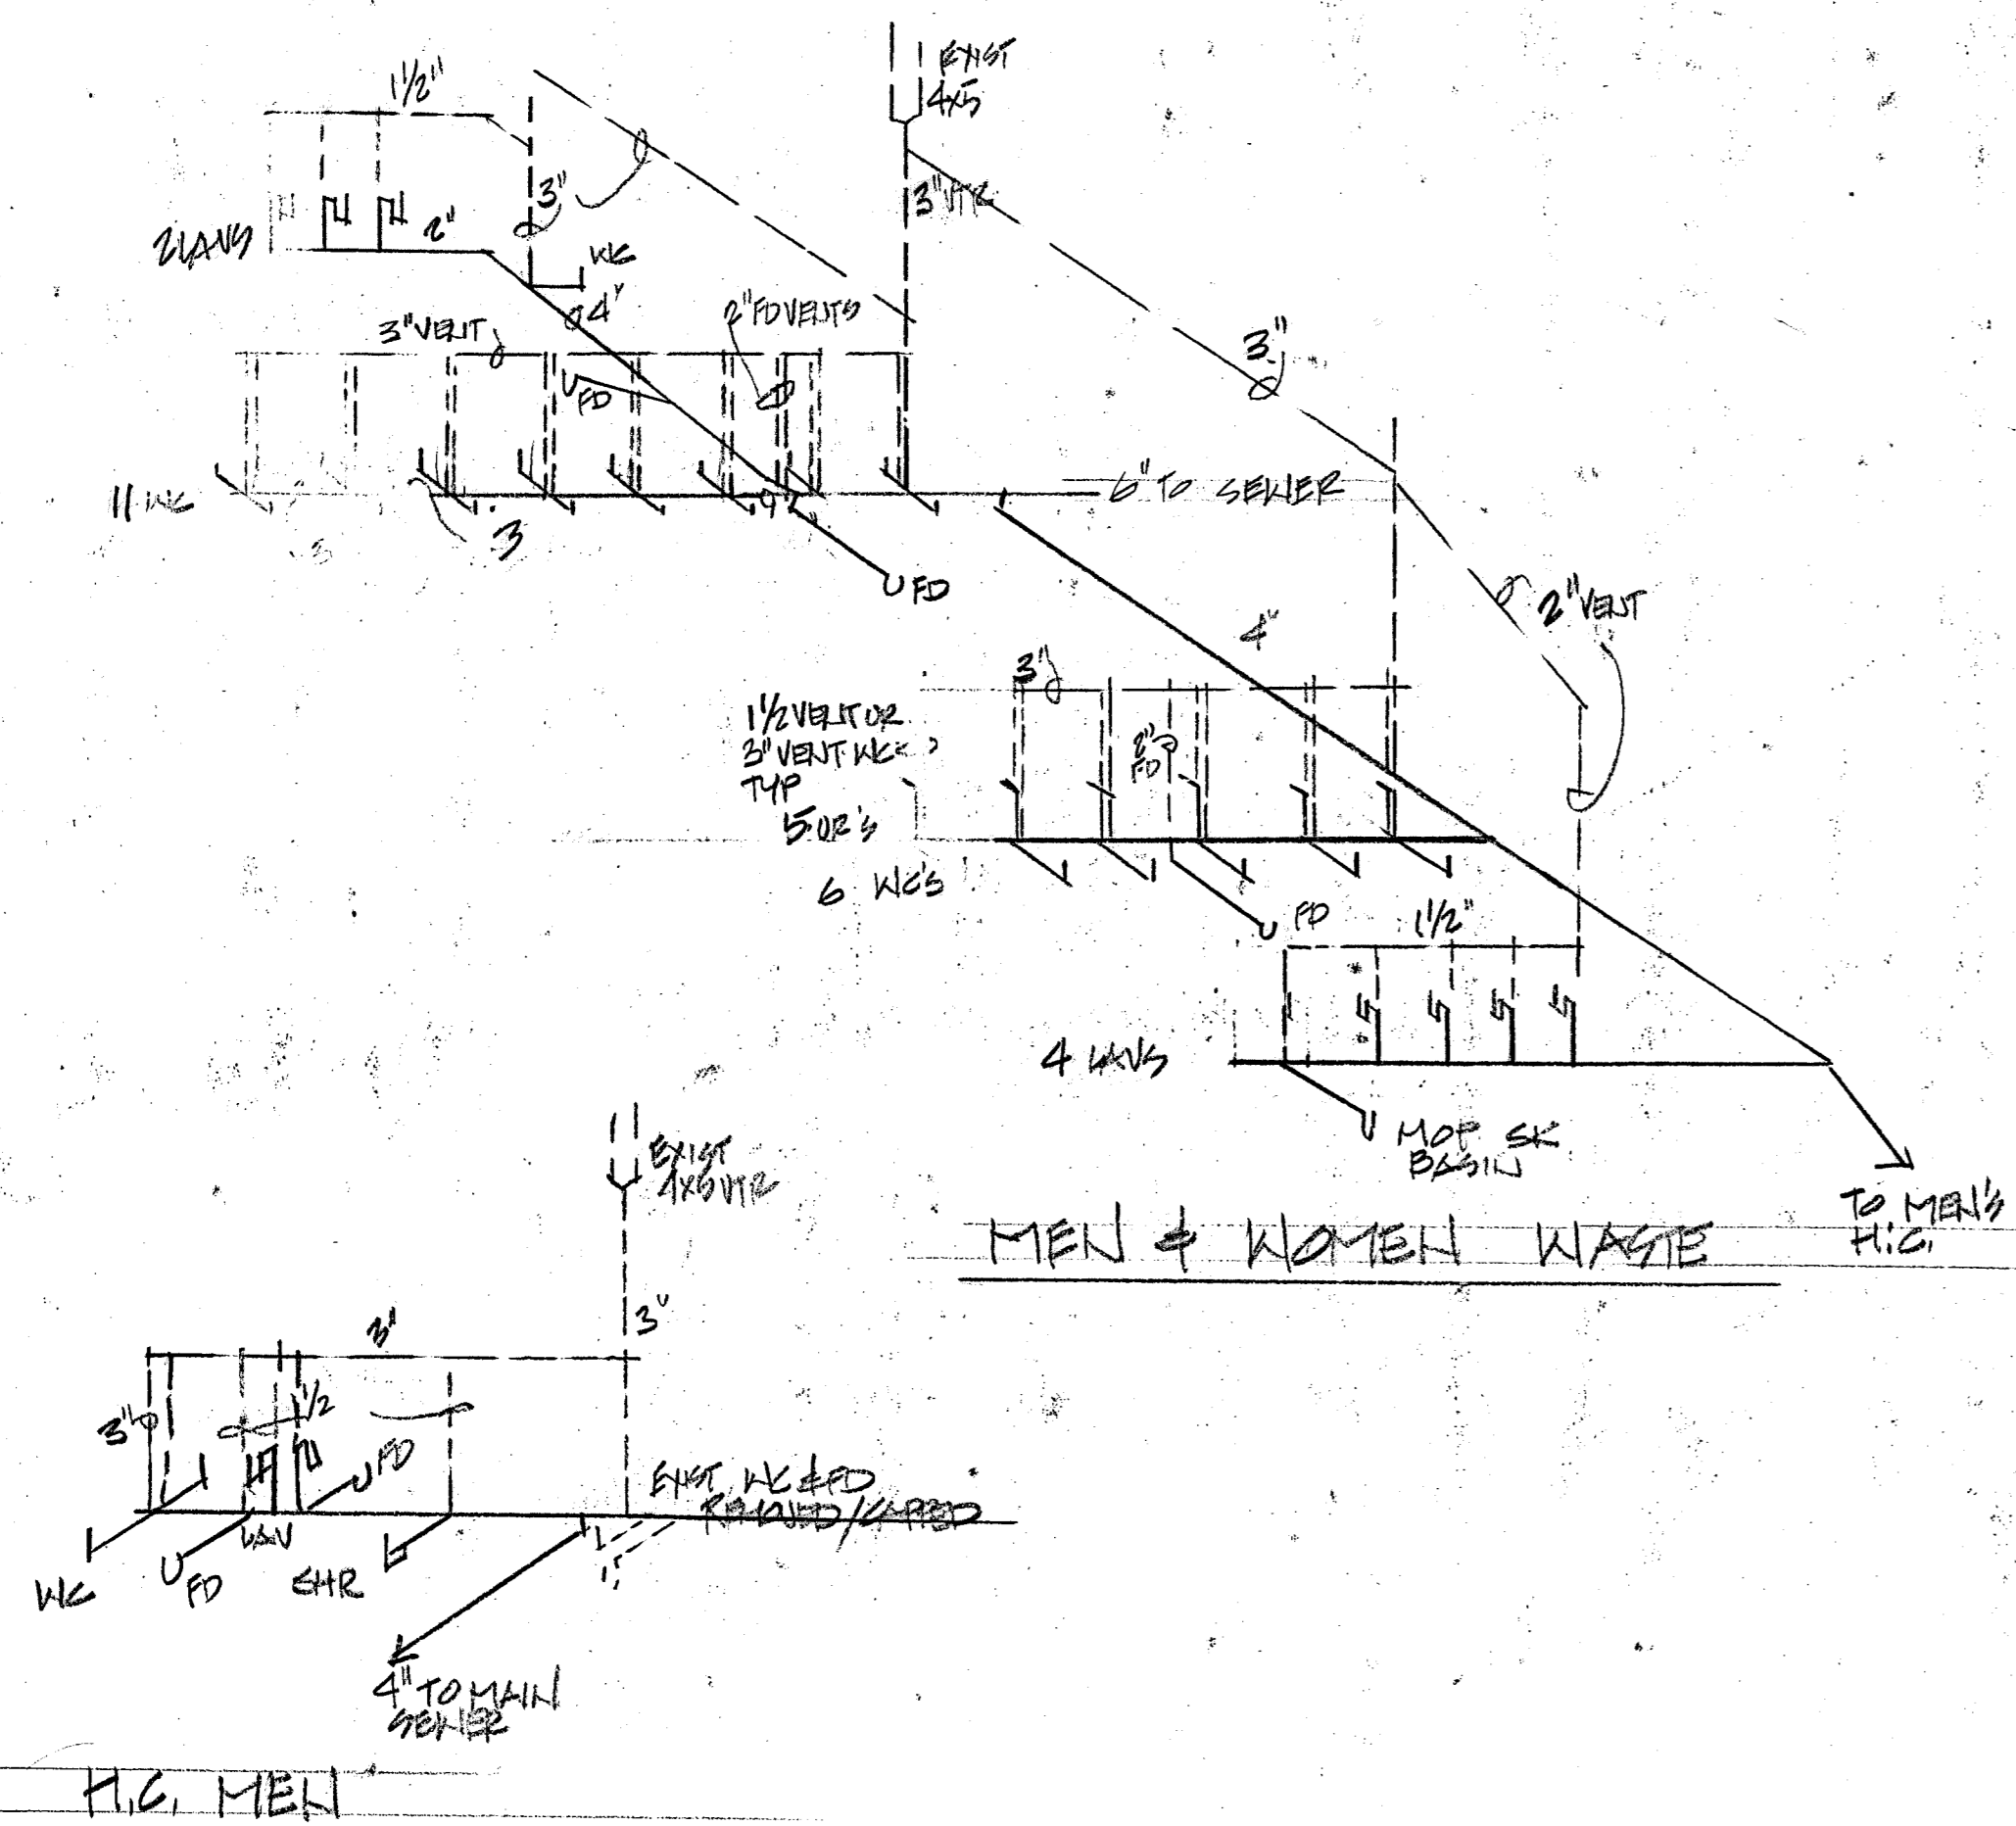


WASTE DIAGRAM

- MIN 4" RERID UNDER SLAB
- ALL NEW & EXISTING WORK TO COMPLY W/ 14 IL STATE PLUMBING CODE
- W'S & DRINALS TO BE WATER SAVING TYPE

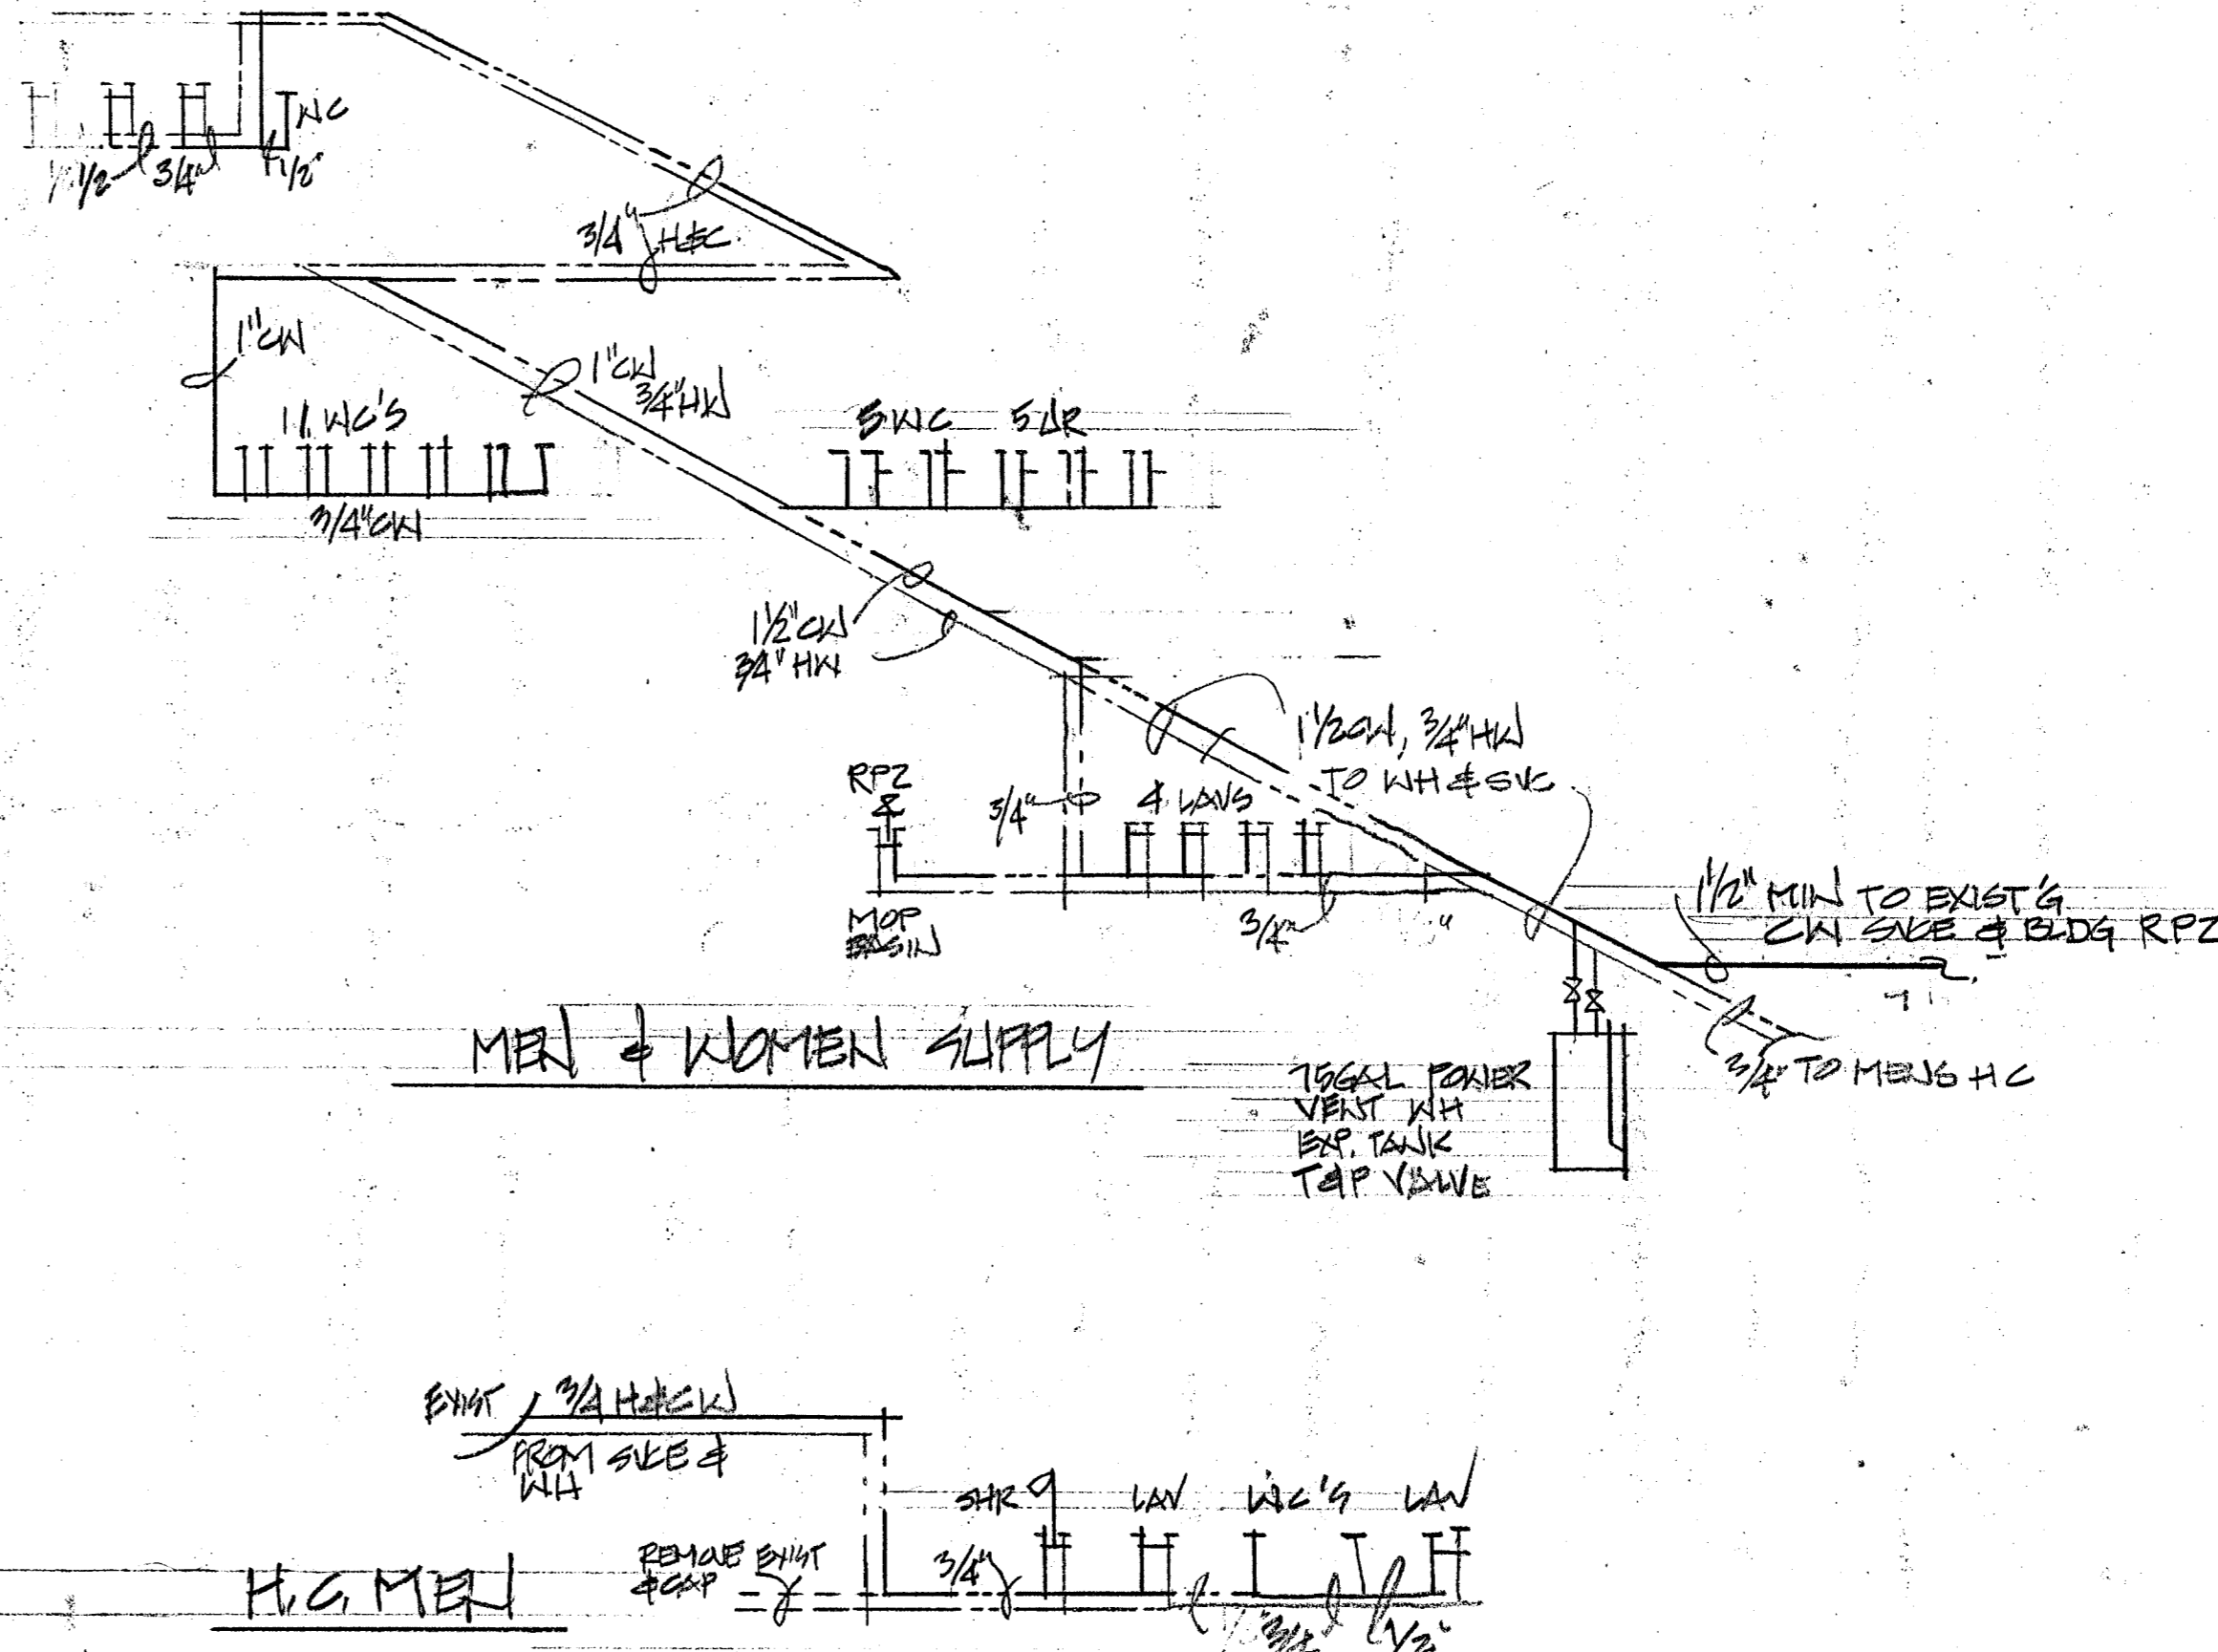

SUPPLY DIAGRAM

- VALVE ALL FIXTURES
- 2" AIR CHAMBERS ALL FIXTURES
- 2" AIR CHAMBERS ALL RISERS & STRS
- TUBE COOPER
- INSULATE HW PIPING PER IESTEC
- ALL NEW & EXIST'G WORK TO COMPLY W/ 14 IL STATE PLUMBING CODE

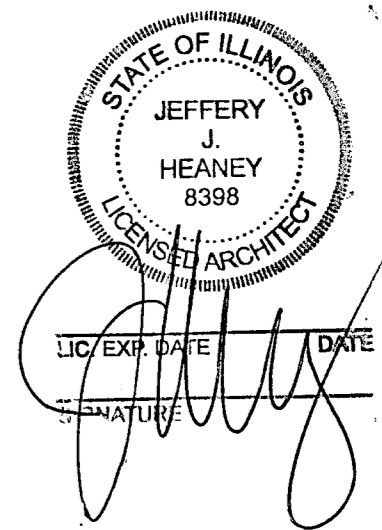

INTERIOR REMODELING FOR
BMM LOGISTICS
2004 MINER ST, DES PLAINES, IL

Jeffery J. Heaney Architect A.I.A.
911 Washington Street • Glenview, IL • (847) 729-4190

Date	10/30/18
Scale	NTD
Drawn	JH
Job	18-170
Sheet	191
Of 8	Sheets

TOILET RM FLOWING
2004 MINER ST DES PLAINES

HVAC SYMBOLS		
	SUPPLY DIFFUSER OR SUPPLY GRILLE (NO AIR FLOW IN SHADDED REGION)	
	RETURN DIFFUSER	
	EXHAUST DIFFUSER	
	MANUAL VOLUME DAMPER	
	FIRE DAMPER WITH ACCESS DOOR	
	SMOKE DAMPER WITH ACCESS DOOR	
	FRESH AIR DAMPER WITH ACCESS DOOR	
	AUTOMATIC MOTOR OPERATED DAMPER	
	BACKDRAFT DAMPER	
	AIR FLOW MEASURING STATION	
	DUCT TURNED UP (SOLID LINES)	
	DUCT TURNED DOWN (DASHED LINES)	
	RETURN BRANCH DUCT TO RETURN GRILLE/DIFFUSER	
	SUPPLY BRANCH DUCT TO SUPPLY GRILLE/DIFFUSER	
	EXHAUST BRANCH DUCT TO EXHAUST GRILLE/DIFFUSER	
	SIDEWALL SUPPLY, RETURN OR EXHAUST GRILLE	
	STAINLESS WELDED DUCTWORK PER SPECIFICATION	
	INSULATED METAL PANEL	
	BOOT TAP OR 45 DEGREE ENTRY FITTING	
	R (RISE) OR D (DROP) ARROW IN DIRECTION OF AIR FLOW	
	ACCESS DOOR	
	90 DEGREE ELBOW WITH TURNING VANES	
	STANDARD RADIUS ELBOW WITH CENTER RADIUS EQUAL TO 1-1/2 TIMES WIDTH OF DUCT	
	INTERNALLY INSULATED DUCTWORK	
	FLAT OVAL SPIRAL DUCT (WIDTH X HEIGHT)	
	ROUND SPIRAL DUCT	
	RECTANGULAR DUCT (WIDTH X HEIGHT)	
	SPIN IN FITTING WITH MANUAL VOLUME DAMPER AND FLEXIBLE DUCT CONNECTION	
	CONICAL FITTING	
	SQUARE TO ROUND TRANSITION	
	TYPICAL TERMINAL BOX WITH REHEAT COIL, TWO WAY CONTROL VALVE, BOX DESIGNATION	
	TYPICAL TERMINAL BOX WITH REHEAT COIL, THREE WAY CONTROL VALVE, BOX DESIGNATION	
	TYPICAL CHILLED BEAM (2'x4' or 2'x6')	
	90 DEGREE TEE (ROUND OR FLAT OVAL ONLY)	

CONTROL SYMBOLS			
	AIR FLOW MEASURING STATION		HUMIDITY TRANSMITTER (PNEUMATIC)
	AIR FLOW SWITCH		LOW LIMIT SAFETY THERMOSTAT
	ALARM		MAGNETIC INDUCTIVE FLOW METER SENSOR
	BACKDRAFT DAMPER		MANUAL SWITCH (ELECTRIC)
	CO2 SENSOR		MODEM
	CURRENT SENSOR		MOTOR STARTER CENTER
	DUCT DETECTOR		MOTOR STARTER
	CURRENT TO PNEUMATIC TRANSDUCER		OPERATORS WORK STATION
	DAMPER END SWITCH (BINARY)		OUTDOOR AIR DAMPER
	DIFFERENTIAL PRESSURE SENSOR (ANALOG)		OUTDOOR AIR VOLUME PROBE, TRANSDUCER AND MONITOR
	DIFFERENTIAL PRESSURE SWITCH (BINARY)		PNEUMATIC RELAY
	DIFFERENTIAL PRESSURE SWITCH (HIGH LIMIT) (BINARY)		PRESSURE ELECTRIC SWITCH
	ELECTRO PNEUMATIC SWITCH		PRESSURE CONTROLLER (PNEUMATIC)
	ELECTRO PNEUMATIC TRANSDUCER		PRESSURE SENSOR (ELECTRONIC)
	EXHAUST AIR DAMPER		PRESSURE TRANSMITTER
	FACE & BY-PASS DAMPER		RETURN AIR DAMPER
	FAN DISCHARGE DAMPER		SMOKE DETECTOR
	FAN INLET DAMPER		START/STOP SWITCH
	FAN INLET VORTEX DAMPER		STEAM FLOW MEASUREMENT DEVICE PLATE & MASS FLOW COMPUTER
	FLOW CONTROLLER		VERRIDE TIMER
	FLOW SENSOR		TEMPERATURE CONTROLLER (PNEUMATIC)
	HAND OFF-AUTO SWITCH		TEMPERATURE SENSOR (ELECTRONIC)
	HUMIDITY CONTROLLER (PNEUMATIC)		TEMPERATURE TRANSMITTER (PNEUMATIC)
	HUMIDITY HIGH LIMIT (ELECTRONIC)		TERMINAL BOX ACTUATOR
	HUMIDITY SENSOR (ELECTRONIC)		TURBINE METER
	VARIABLE SPEED MOTOR CONTROLLER		VELOCITY PRESSURE SENSOR (ELECTRONIC)
	VIBRATION SWITCH		VOLUME DAMPER (MANUAL)
	VORTEX SHEDDING AIR FLOW TRANSMITTER		VORTEX SHEDDING FLOW METER
	20 PSIG MAN AIR		HOLDING COIL
	PRESSURE GAUGE		HUMIDOSTAT (SPACE)
	SWITCH (PNEUMATIC)		THERMOSTAT (SPACE)
	THERMOSTAT (SPACE) NIGHT CYCLE		0-30 PSIG AIR GAUGE
	LAN LOCAL AREA NETWORK		TEMPERATURE CONTROL CONTRACTIONS
	TEMPERATURE CONTROL CONTRACTIONS		ENVIRONMENTAL CONTROL CONTRACTOR
	ELECTRICAL CONTRACTOR		PNEUMATIC
	ELECTRICAL WIRING		ANALOG INPUT (DCC CONTROLLER)
	ANALOG INPUT (DCC CONTROLLER)		ANALOG OUTPUT (DCC CONTROLLER)
	BINARY INPUT (DCC CONTROLLER)		BINARY OUTPUT (DCC CONTROLLER)
	BINARY OUTPUT (DCC CONTROLLER)		LIGHT DOT LINES INDICATE FUTURE WORK

NOTE: ALL SYMBOLS AND ABBREVIATIONS MAY NOT BE USED ON THIS PROJECT

VALVE AND FITTING SYMBOLS	
	PIPING FLEXIBLE CONNECTION
	PIPE TURNED UP (UNLESS NOTED OTHERWISE)
	PIPE TURNED DOWN
	CHILLED WATER SUPPLY
	PIPE OUT TOP
	PIPE OUT BOTTOM
	THREADED NIPPLE W/ CAP
	PIPE WITH BLIND FLANGE
	CONCENTRIC REDUCER
	ECCENTRIC REDUCER
	ISOLATION VALVE (PUMPING SCHEMATIC)
	CHECK VALVE
	GATE VALVE
	BALL VALVE
	GLOBE VALVE
	BUTTERFLY VALVE
	TEMPERATURE CONTROL - 2 WAY MODULATING VALVE
	TEMPERATURE CONTROL - 3 WAY 2 POSITION ISOLATION VALVE
	CALIBRATED BALANCE VALVE
	SAFETY RELIEF VALVE
	STRAINER
	FLOW METER
	FLOOR DRAIN
	AUTOMATIC FLOW CONTROL VALVE
	FLOW MEASURING DEVICE
	MANUAL AIR RELIEF VENT
	AUTOMATIC AIR RELIEF VENT
	LUBRICATED PLUG VALVE
	STEAM PRESSURE REDUCING VALVE
	ANGLE VALVE
	REFRIGERANT HOT GAS BY-PASS VALVE
	SHUT-OFF COOK (HYDROCOOKS)
	SOLENOID VALVE
	REFRIGERANT EXPANSION VALVE
	WATER PRESSURE REDUCING/REGULATING VALVE
	STEAM TRAP
	DIELECTRIC UNION BETWEEN STEEL AND COPPER
	STRAINER (STEAM)
	PRESSURE AND TEMPERATURE PLUG
	REFRIGERANT SIGHT GLASS
	THERMOMETER
	ELECTRIC BASEBOARD HEATER
	SENSOR (TEMP/HUMIDITY)
	FLOW SWITCH
	CLEAN OUT
	INDICATED EXPANSION LOOP (COLD SPRING)
	ANCHOR
	GUIDE
	REFRIGERANT SHUT-OFF VALVE
	EXPANSION JOINT
	DIFFERENTIAL SWITCH

FLOOR PLAN SYMBOLS	
	SECTION WITH TOP NUMBER INDICATING SECTION DESIGNATION AND BOTTOM NUMBER INDICATING DRAWING THAT DETAIL IS SHOWN ON OR DRAWING THAT DETAIL IS DRAWN ON
	DETAIL WITH TOP LETTER INDICATING DETAIL DESIGNATION AND BOTTOM NUMBER INDICATING DRAWING THAT DETAIL IS SHOWN ON OR DRAWING THAT DETAIL IS DRAWN ON
	GENERAL NOTE
	PLAN NOTE LIST
	PLAN NOTE
	DOUBLE CHECK VALVE
	DOMESTIC COLD WATER BOOSTER PUMP
	DUAL OUTLET
	DIRECT DIGITAL CONTROL
	DEFLECTOR
	DEGREE
	DEPARTMENT
	DOMESTIC HOT WATER BOOSTER PUMP
	GASKET
	ISOCNECT
	KITCHEN EQUIPMENT CONTRACTOR
	KILN
	LENGTH
	LAB AIR COMPRESSOR
	LAB AIR DRYER
	LOCAL AREA NETWORK
	LEAVING AIR TEMPERATURE
	LINEAR BAR OFFSETS
	LBS POUNDS
	LINEAR DIFFUSER
	LINEAR DUCT
	LAMINAR FLOW DIFFUSER
	LEAVING FLUID TEMPERATURE
	LOCATION
	LOW PRESSURE CONDENSATE RETURN
	LOW PRESSURE STEAM
	LEAVING
	LAB VACUUM PUMP
	LEAVING WATER TEMPERATURE
	MEDICAL AIR INTAKE
	MIXED AIR TEMPERATURE
	MAXIMUM
	RETURN X 1000
	MECHANICAL CONTRACTOR
	MINIMUM CIRCUIT AMPACITY
	MOTOR CONTROL CENTER
	MOTORIZED DAMPER
	MECHANICAL MANUFACTURER
	MINIMUM
	MISCELLANEOUS
	MAXIMUM OVERCURRENT PROTECTION
	MEDIUM PRESSURE CONDENSATE RETURN
	MEDIUM PRESSURE STEAM
	MOUNTED
	NOT APPLICABLE
	NORMALLY CLOSED OR NOISE CRITERIA
	NOT IN CONTRACT
	NORMALLY OPEN
	NOT TO SCALE

NOTE: ALL SYMBOLS AND ABBREVIATIONS MAY NOT BE USED ON THIS PROJECT

HVAC PIPING SYMBOLS	
	HEATING WATER SUPPLY
	HEATING WATER RETURN
	PERIMETER HEATING WATER SUPPLY
	PERIMETER HEATING WATER RETURN
	CHILLED BEAM HEATING WATER SUPPLY
	CHILLED BEAM HEATING WATER RETURN
	ACCESS DOOR
	ADJUSTABLE OR ADJACENT
	AIRFLOW CONTROL VALVE
	ABOVE FINISHED FLOOR
	AIR FLOW MEASURING STATION
	AIR HANDLING UNIT
	AIR PRESSURE DROP
	APPROXIMATE
	AIR RECEIVER
	ARCHITECT AIR SEPARATOR
	ATMOSPHERE
	A/C VENT
	AIR VOLUME MEASURING STATION
	A/C WASTE
	BOILER
	BLOWER COIL UNIT
	BACKDRAFT DAMPER
	BRAKE HORSEPOWER
	BACKWARD INCLINE BUILDING
	BOTTOM
	BRINE PUMP
	BULK SALT STORAGE
	BRITISH THERMAL UNIT
	BTU PER HOUR
	COMPRESSED AIR
	CAPACITY
	CONSTANT AIR VOLUME
	COOLING COIL
	COOLING COIL PUMP
	CONDENSATE PUMP DISCHARGE
	CENTRIFUGAL FAN
	CUBIC FEET PER MINUTE
	HEAD
	HEAT EXCHANGER
	HEAT RECOVERY SUPPLY
	HEAT RECOVERY RETURN
	REFRIGERANT HOT GAS
	REFRIGERANT SECTION
	RISER
	CARBON DIOXIDE MANIFOLD
	COMPRESSOR
	CONCRETE
	CONNECTION
	CONSTRUCTION
	CONDENSATE PUMP
	CONDENSATE PUMP DISCHARGE
	CABINET UNIT WATER
	COLD WATER
	COLD WATER MAKE UP
	CHILLED WATER PUMP
	CHILLED WATER RETURN
	CHILLED WATER SUPPLY
	DIFFUSER OR DAMPER
	DEGREE OR BTU PER HOUR
	DOUBLE CHECK VALVE
	DOMESTIC COLD WATER BOOSTER PUMP
	DUAL OUTLET
	DIRECT DIGITAL CONTROL
	DEFLECTOR
	DEGREE
	DEPARTMENT
	DOMESTIC HOT WATER BOOSTER PUMP
	GASKET
	ISOCNECT
	KITCHEN EQUIPMENT CONTRACTOR
	KILN
	LENGTH
	LAB AIR COMPRESSOR
	LAB AIR DRYER
	LOCAL AREA NETWORK
	LEAVING AIR TEMPERATURE
	LINEAR BAR OFFSETS
	LBS POUNDS
	LINEAR DIFFUSER
	LINEAR DUCT
	LAMINAR FLOW DIFFUSER
	LEAVING FLUID TEMPERATURE
	LOCATION
	LOW PRESSURE CONDENSATE RETURN
	LOW PRESSURE STEAM
	LEAVING
	LAB VACUUM PUMP
	LEAVING WATER TEMPERATURE
	MEDICAL AIR INTAKE
	MIXED AIR TEMPERATURE
	MAXIMUM
	RETURN X 1000
	MECHANICAL CONTRACTOR
	MINIMUM CIRCUIT AMPACITY
	MOTOR CONTROL CENTER
	MOTORIZED DAMPER
	MECHANICAL MANUFACTURER
	MINIMUM
	MISCELLANEOUS
	MAXIMUM OVERCURRENT PROTECTION
	MEDIUM PRESSURE CONDENSATE RETURN
	MEDIUM PRESSURE STEAM
	MOUNTED
	NOT APPLICABLE
	NORMALLY CLOSED OR NOISE CRITERIA
	NOT IN CONTRACT
	NORMALLY OPEN
	NOT TO SCALE

MECHANICAL ABBREVIATIONS	
ABBREVIATION	DESCRIPTION
AE	ARCHITECT AND ENGINEER
AC OR ACU	AIR CONDITIONING UNIT OR AIR COMPRESSOR
AC	AIR COOLED CONDENSING UNIT
ACD	AIR CONDITIONING CONDENSATE DRAIN
AD	ADJUSTABLE OR ADJACENT
ADJ	ADJUSTABLE OR ADJACENT
AFV	AIRFLOW CONTROL VALVE
AF	ABOVE FINISHED FLOOR
AFMS	AIR FLOW MEASURING STATION
AHU	AIR HANDLING UNIT
APD	AIR PRESSURE DROP
APPROX	APPROXIMATE
AR	AIR RECEIVER
ARCH	ARCHITECT
AS	AIR SEPARATOR
ATM	ATMOSPHERE
AV	A/C VENT
AVMS	AIR VOLUME MEASURING STATION
AW	A/C WASTE
B	BOILER
BCU	BLOWER COIL UNIT
B	


1/11/2019 9:19:04 PM
 BIM 360/118.SPH.452 - BMM Des Plaines Office TRC MEP Central_V19.rvt

TAG	LOCATION	AREA SERVED	CFM	OUTLET VEL. (FPM)	T.S.P. (IN. WG.)	FAN TYPE	FAN RPM	MOTOR					DESIGN REFERENCE										NOTES						
								HP	RPM	VOLTS	PHASE	CYCLE	ACCESS DOOR	BELT DRIVE	DIRECT DRIVE	BELT GUARD	BIRD SCREEN	OUTLET GUARD	DRAIN	GRAVITY BDD	MOTORIZED DAMPER	ROOF CURB		VIBRATION ISOLATION	ROOF PROTECTION SYS.	UNIT MTD. DISC. SW.	ALL ALUMINUM	SPECIAL COATING	WALL CAP
TE-1	MENS/WOMENS RR	RESTROOM	400	0	0.75	CEILING	1380	3	1380	120	1	60	No	No	Yes	No	No	No	No	No	No	No	No	No	Yes	47	GREENHECK	SP-A710-VG	
TE-2	PRIVATE RR	RESTROOM	100	0	0.83	CEILING	1050	3	1050	120	1	60	No	No	Yes	No	No	No	No	No	No	No	No	Yes	13	GREENHECK	SP-B150		


TAG	NECK/INLET SIZE (IN.)	FACE SIZE (IN.)	MIN CORE AREA (SQ. FT)	NOMINAL LENGTH (IN.)	SLOT WIDTH (IN.)	NUMBER OF SLOTS	MATERIAL	FINISH	MAX. NC	MAX THROW (FT)	MAX A.P.D (IN. WG.)	DESIGN REFERENCE		NOTES
												PRICE	MODEL	
SD1	8	24 X 24	-	-	-	-	STEEL	WHITE	27	10	0.12	PRICE	SPD	
SD2	10	24 X 24	-	-	-	-	STEEL	WHITE	27	12	0.15	PRICE	SPD	

TOILET ROOM EXHAUST RATE				
ROOM NAME	ROOM NUMBER	ROOM AREA	FIXTURE COUNT	EXHAUST (CFM)
PRIVATE RESTROOM	19	63 SF	1	100
WOMENS RESTROOM	24	231 SF	7	400
MENS RESTROOM	25	440 SF	13	400
UNISEX RESTROOM	32	39 SF	1	100

- PLAN NOTES**
- CONNECT NEW 6" SUPPLY AIR DUCT WITH BALANCING DAMPER TO EXISTING
 - TERMINATE EXHAUST DUCT WITH WEATHER CAP.
 - REMOVE EXISTING EXHAUST FAN AND EXHAUST DUCT THROUGH ROOF. PATCH ROOF OPENINGS WEATHERTIGHT.

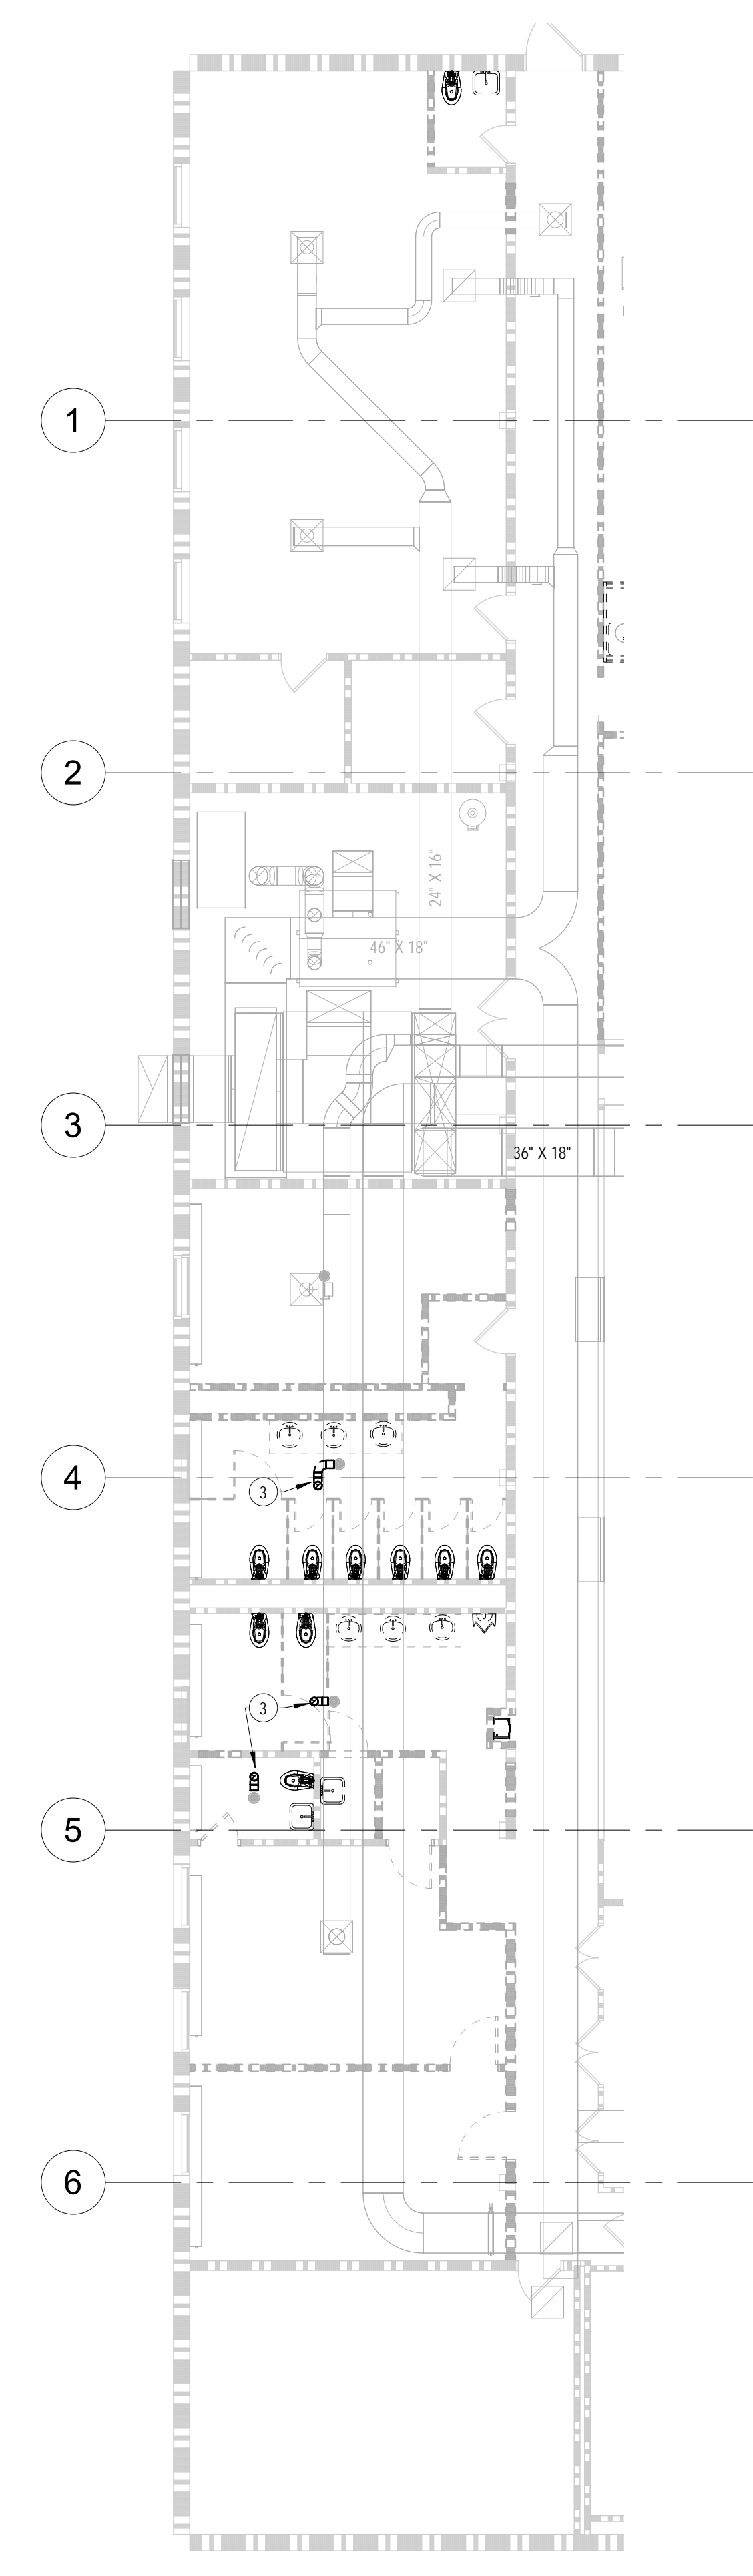

1 PARTIAL FIRST FLOOR MECHANICAL DEMOLITION PLAN
 1/8" = 1'-0"

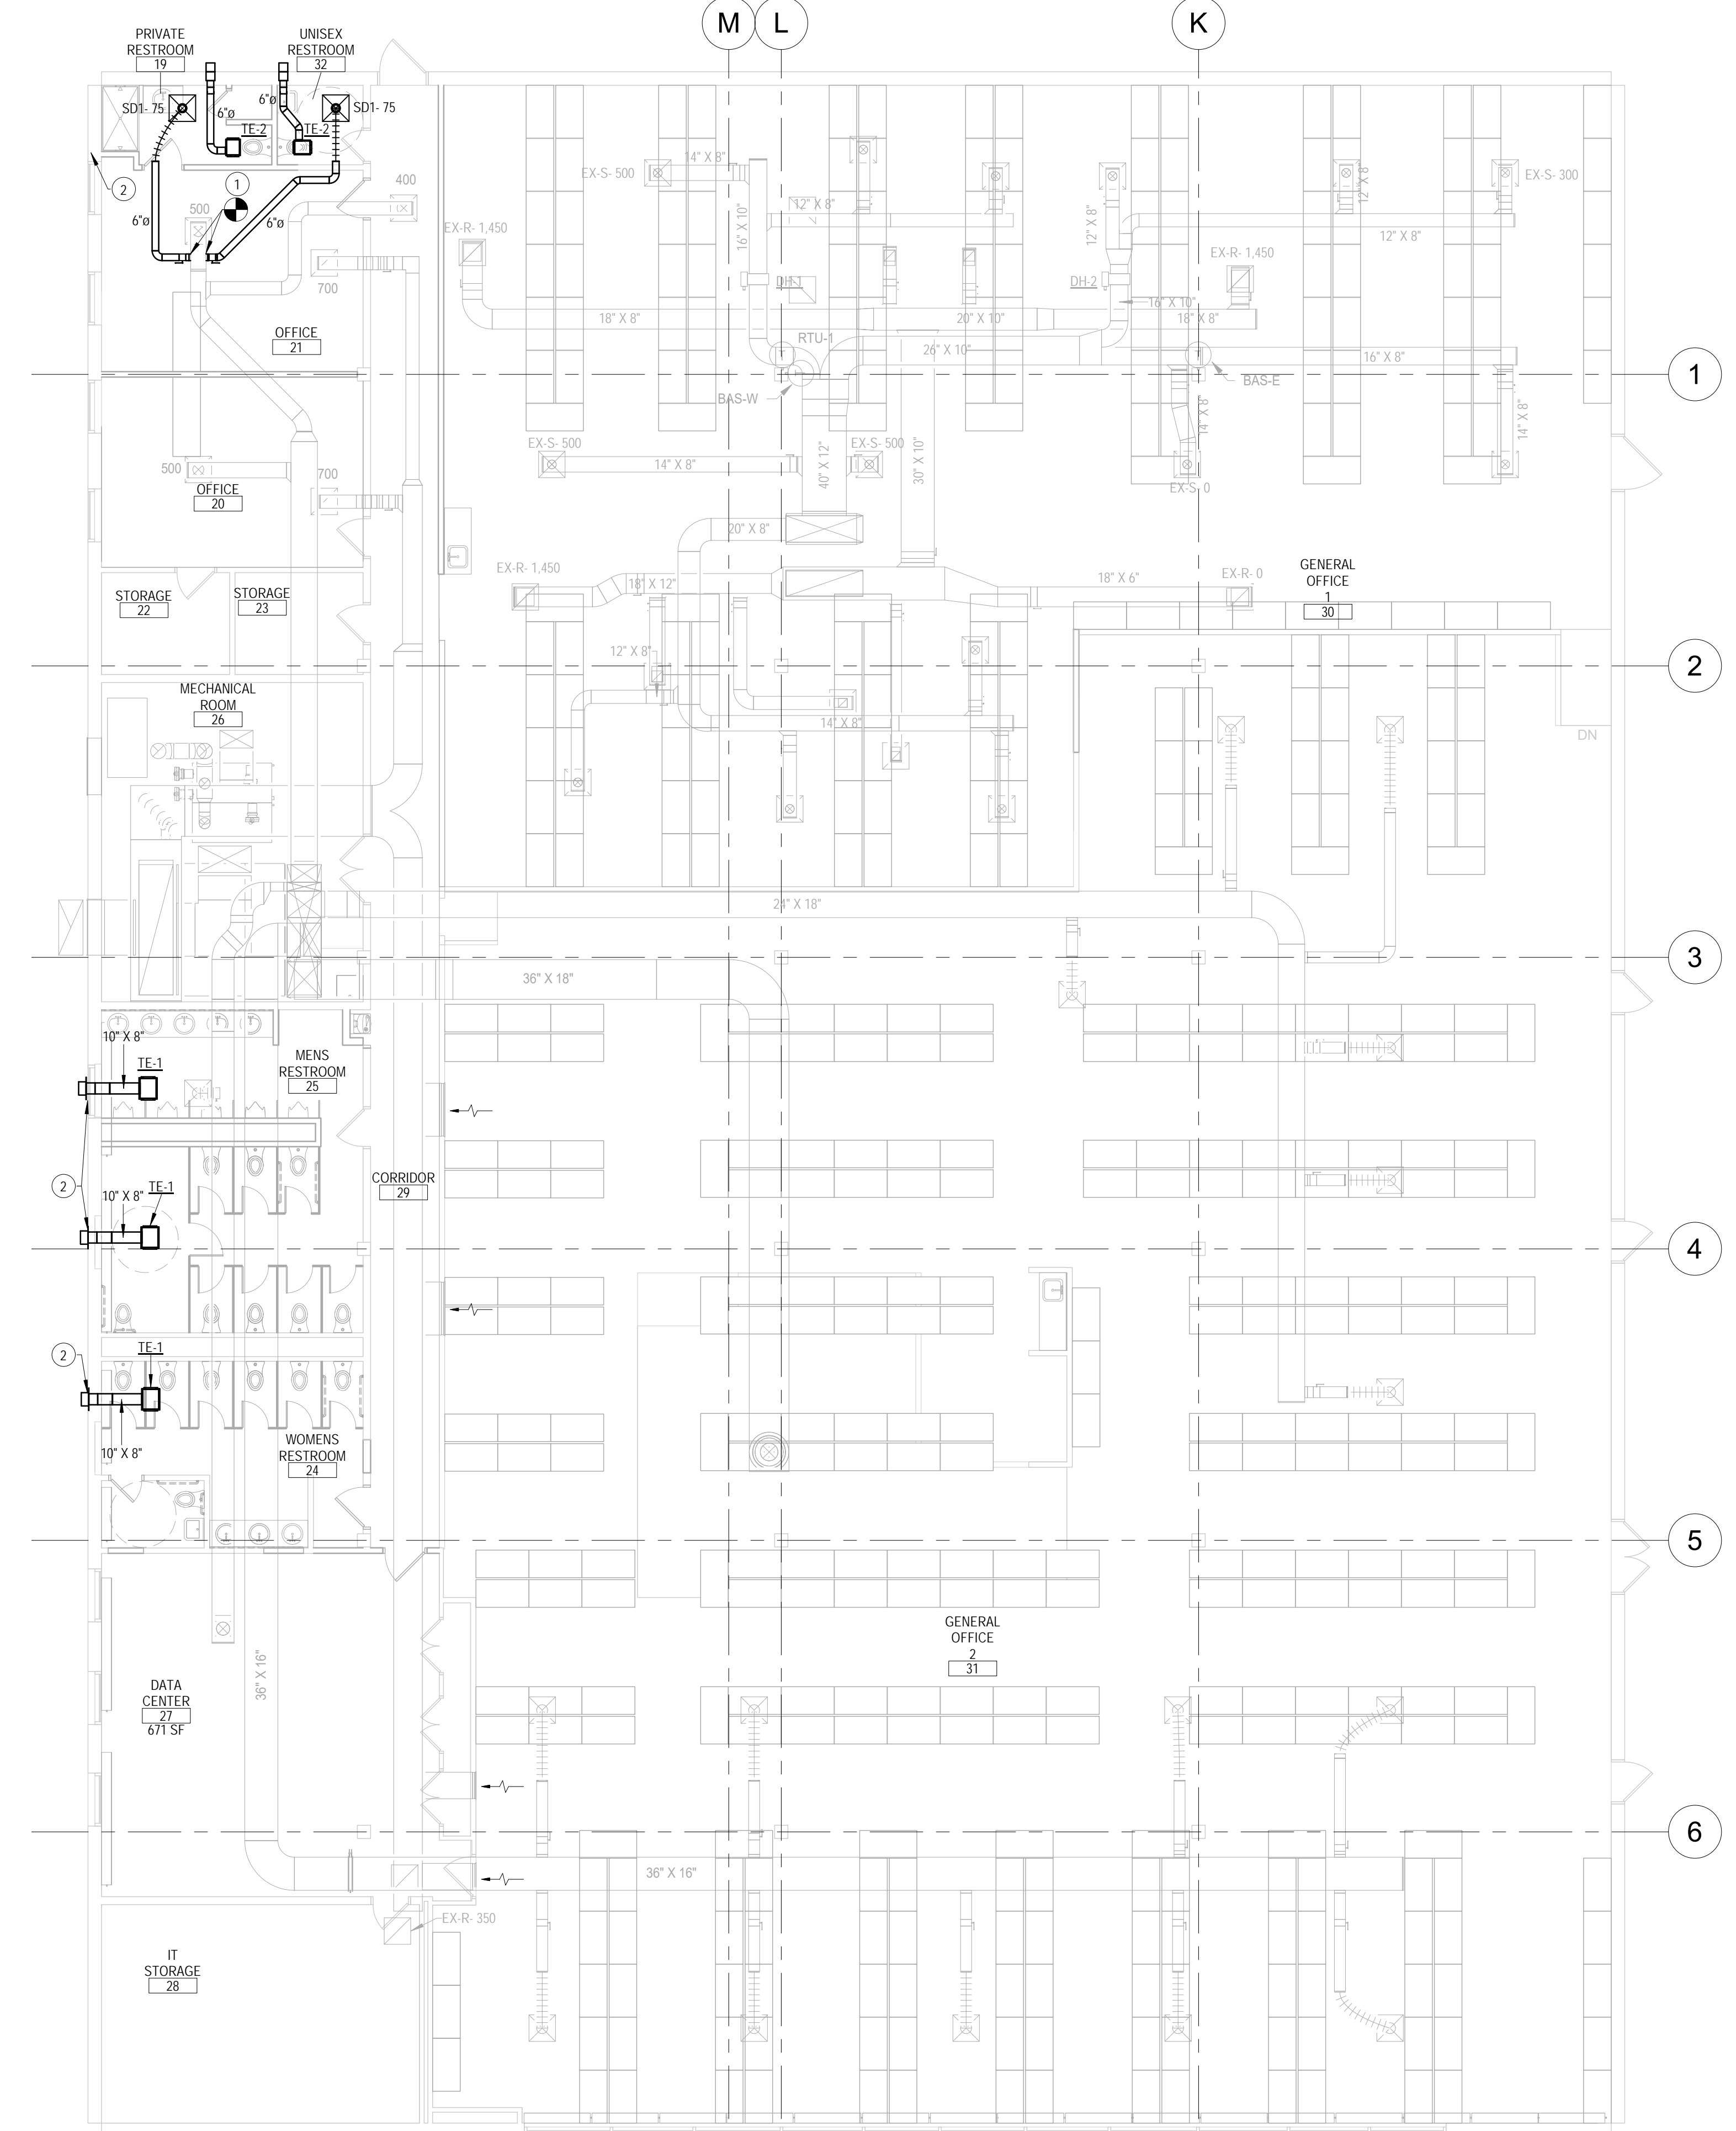

2 FIRST FLOOR MECHANICAL PLAN
 1/8" = 1'-0"



BUILDING DEPT
 01/14/2019
 REVISIONS

CONSTRUCTION DOCUMENTS

PROJECT
BMM LOGISTICS
 2004 MINER ST., DES PLAINES, IL
 BMM TRANSPORTATION, INC.

53 W. Jackson Blvd, Suite 1601
 Chicago, IL 60604
 www.trcww.com

TRC
 WORLDWIDE ENGINEERING


JOB NUMBER: 18SP452
 ISSUE DATE: 12/17/2018
 DRAWN BY: 2
 REVISIONS: MARK, DATE, DESCRIPTION

AMERICAN CONSULTING ENGINEERS COUNCIL
 REGISTERED PROFESSIONAL ENGINEER
 062-053512

SHEET NUMBER
H210

FIRST FLOOR MECHANICAL DUCTWORK PLAN


19:28:59 AM
20/11/2018 10:42 - BMM Doc Plaines Office/18-42_BMM Doc Plaines Office_TPO_MEP_CENTRAL_V18.rvt

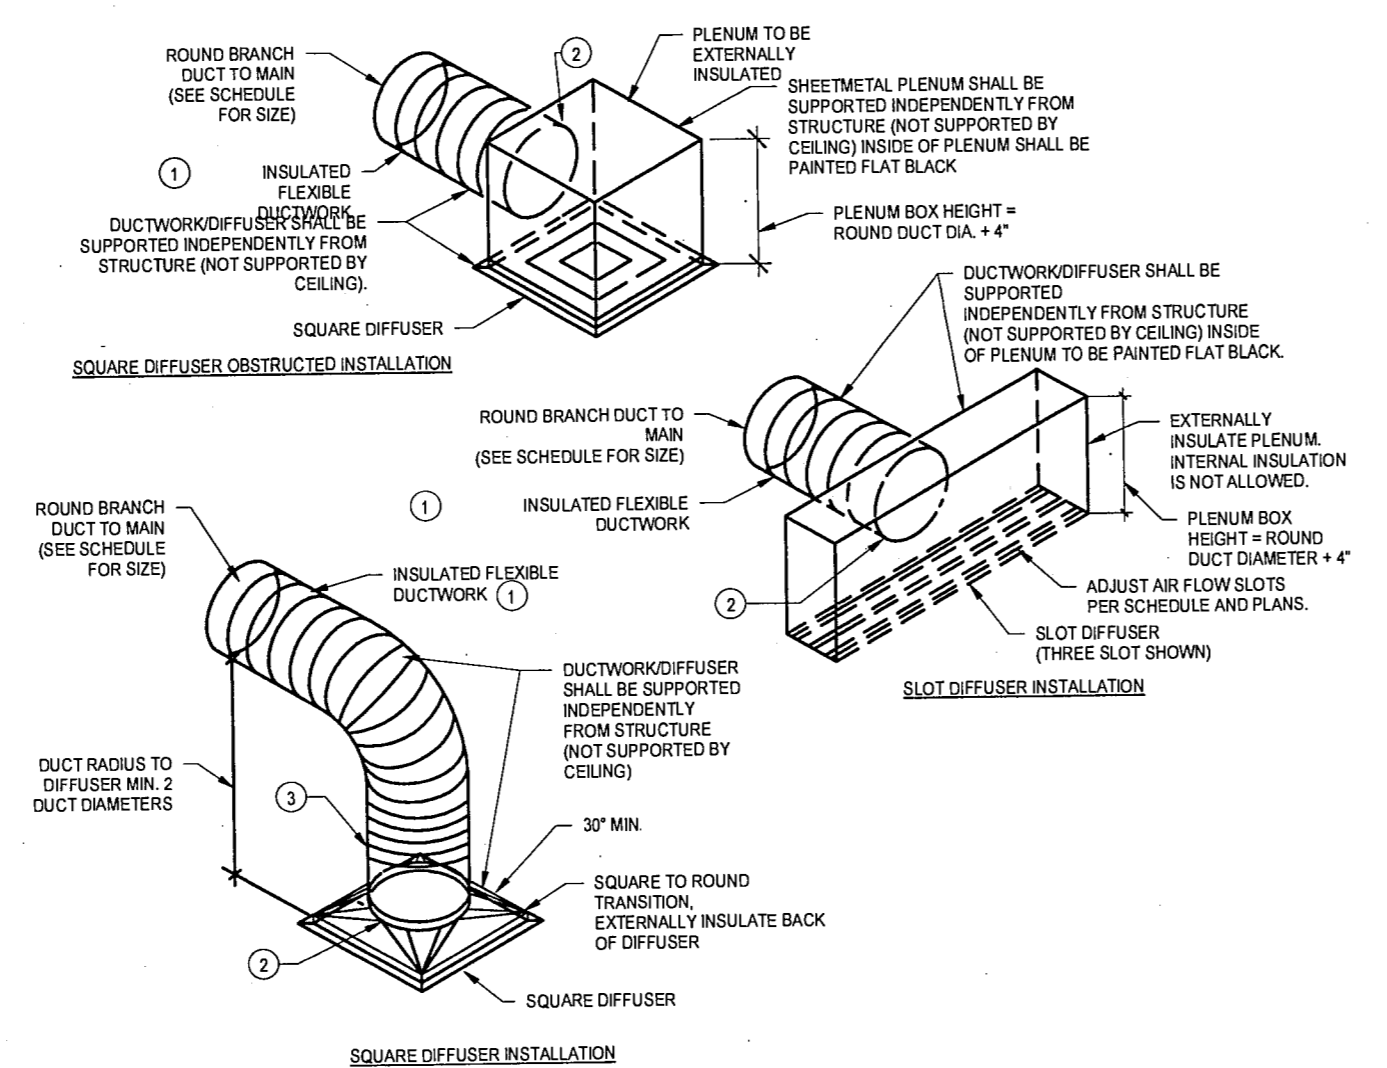


PLAN NOTES

- 1) A MINIMUM OF FIVE (5) FEET LENGTH OF FLEXIBLE DUCT SHALL BE PROVIDED TO EACH DIFFUSER. DUCTWORK SHALL CONTAIN 180° OF BENDING. FLEXIBLE DUCTWORK LENGTH SHALL NOT EXCEED (50/100) FEET EXCEPT WHERE SPECIFICALLY NOTED. FLEX DUCT SHALL NOT CONTACT CEILING AND SHALL BE PROPERLY SUPPORTED SO AS TO HAVE NO KINKS.
- 2) THE WRAP CONNECT FLEX DUCT HELICAL COIL TO ROUND METAL DIFFUSER NECK AND TO ROUND METAL DUCTWORK AT OTHER END OF FLEX DUCT. PULL FLEX DUCT VAPOR BARRIER OVER LOWER TIE-WRAP AND INSTALL SECOND TIE-WRAP OVER THE VAPOR BARRIER. INSULATE METAL DUCT ON DIFFUSER OVER TOP OF SECOND TIE-WRAP AND INSTALL INSULATOR'S TAPE ON EDGES.
- 3) PROVIDE A MINIMUM OF 18" OF STRAIGHT, VERTICALLY ORIENTED, FLEXIBLE DUCT AT THE DIFFUSER NECK. IF UNABLE TO PROVIDE STRAIGHT DUCT RUN THEN PROVIDE OBSTRUCTED INSTALLATION PLENUM IN ACCORDANCE WITH THIS DETAIL.

1 DIFFUSER DETAIL
NO SCALE

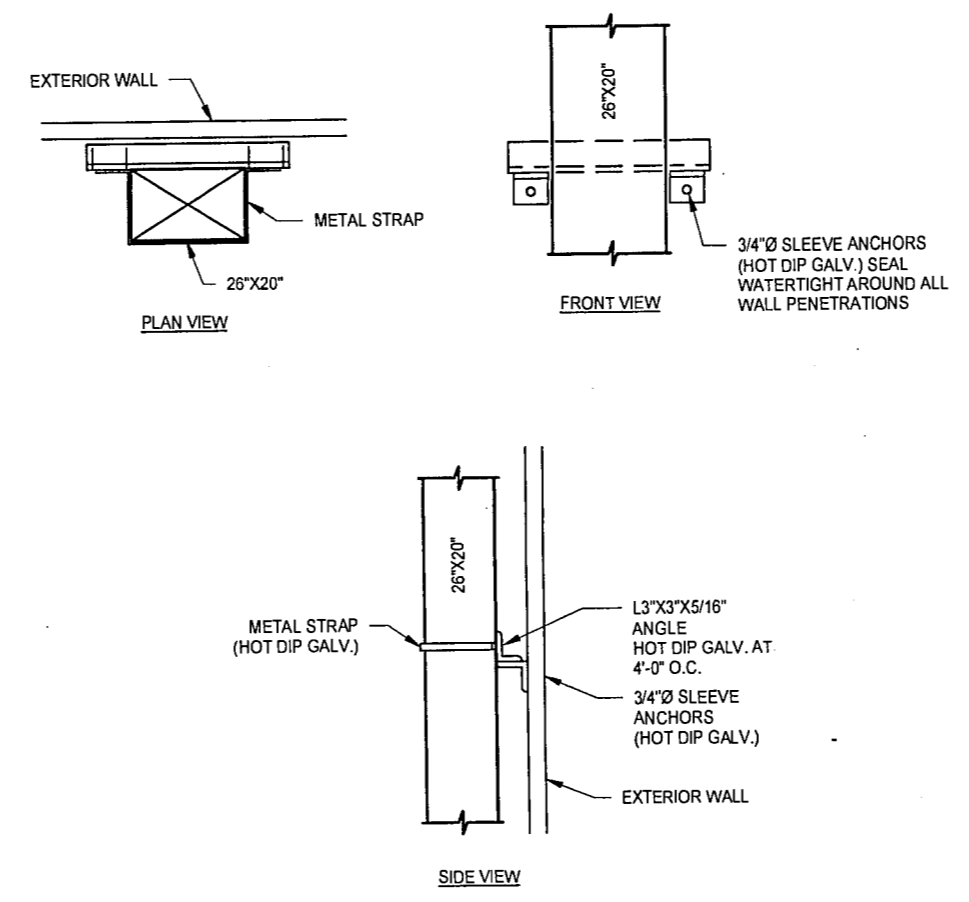

2 DUCTWORK SUPPORT DETAIL
NO SCALE

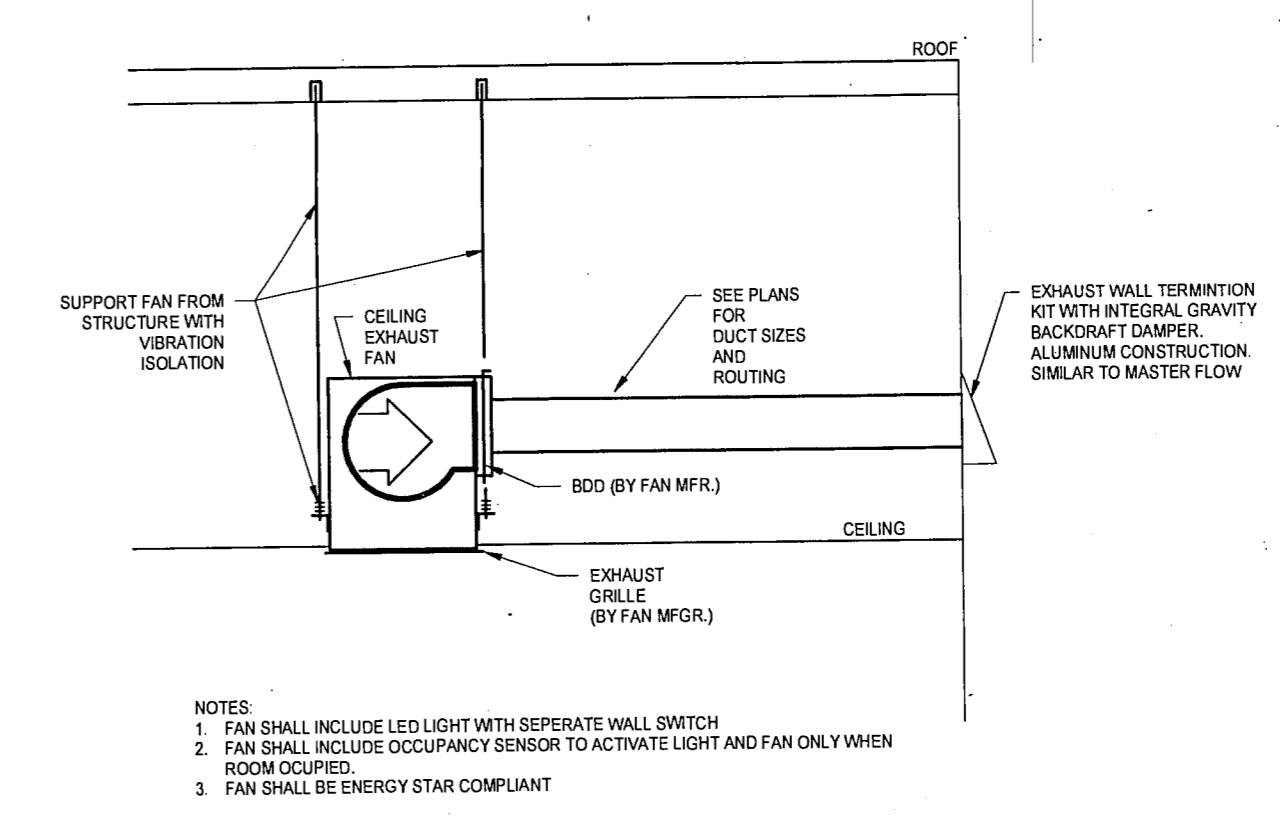


3 EXHAUST FAN CEILING DETAIL
NO SCALE

BUILDING DEPT
1/09/2019
REVISIONS


CONSTRUCTION DOCUMENTS

53 W. Jackson Blvd, Suite 1801
Chicago, IL 60604
www.troww.com

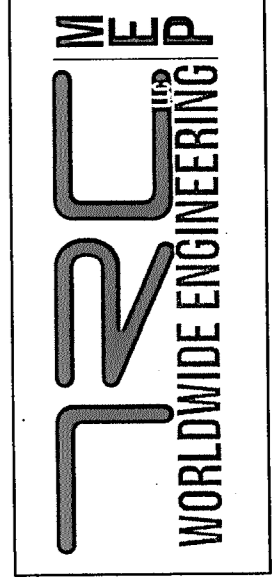

PROJECT
BMM LOGISTICS
2004 MINER ST., DES PLAINES, IL
BMM TRANSPORTATION, INC.

JOB NUMBER	1ESPH452	
ISSUE DATE	12/17/2018	
DRAWN BY		
REVISIONS		
MARK	DATE	DESCRIPTION

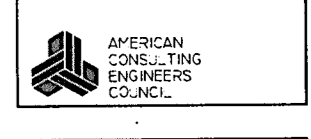

SHEET NUMBER
H801

HVAC DETAILS