


1 *Reduced As-built*
Suite 907

Scale: 1/8" = 1'-0"
North

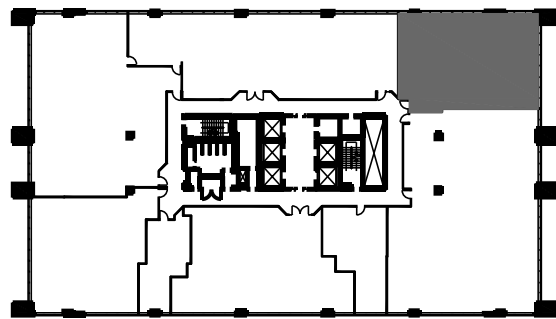

Proximity Plan

Suite 907
The Chancery
2,296 RSF