


ALL IDEAS, DESIGNS, ARRANGEMENTS AND PLANS ON THIS DRAWING ARE OWNED BY AND THE PROPERTY OF HUGHES TURNER PHILLIPS ASSOCIATES, LLC AND WERE CREATED AND DEVELOPED FOR USE ON, AND IN CONNECTION WITH, SAID PROJECT. NONE OF SUCH IDEAS, DESIGNS, ARRANGEMENTS, OR PLANS SHALL BE USED BY OR DISCLOSED TO ANY FIRM, PERSON OR COMPANY OR ANY PURPOSE WITHOUT THE WRITTEN PERMISSION OF HUGHES TURNER PHILLIPS ASSOCIATES, LLC. ANY GENERAL CONDITIONS, LAEET EDITIONS, SHALL PREVAIL ON ALL WORKING DRAWINGS, DETAIL PLANS, APPENDICES AND ETC.

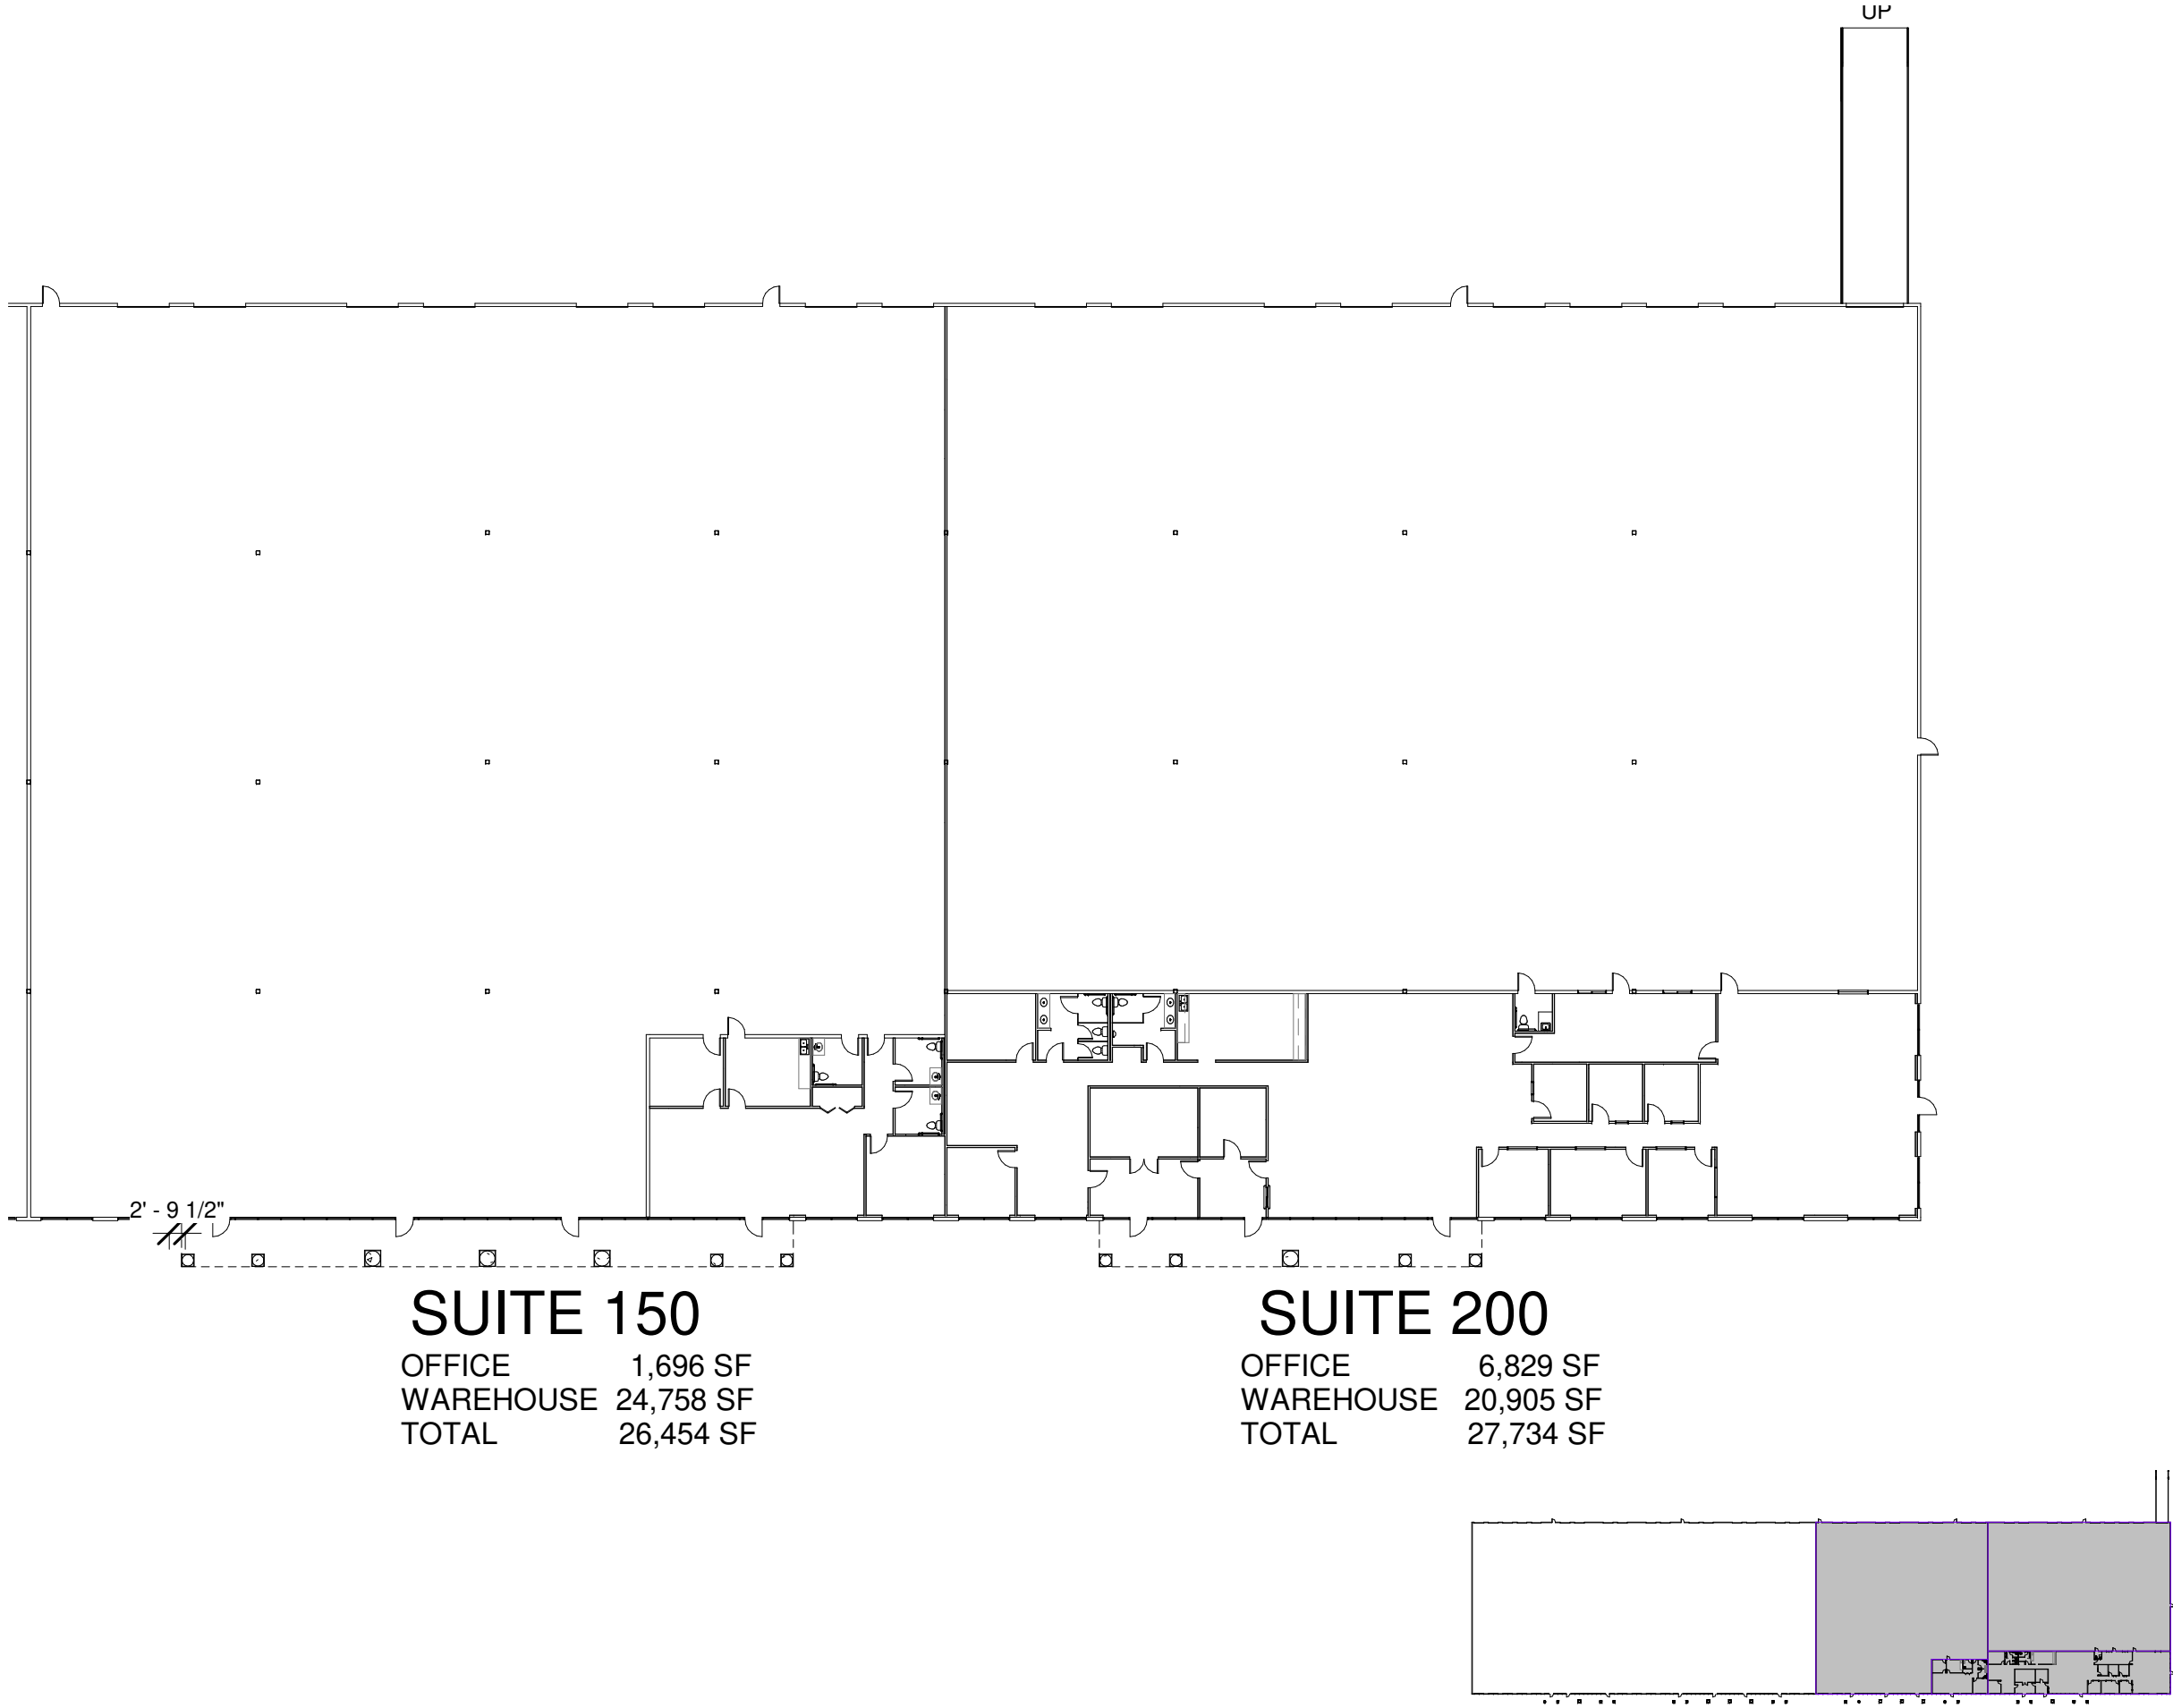

2 Location Plan
1" = 160'-0"

SHEET NUMBER: AB-1	PROJECT #: Project Number DATE: 8-30-22 SCALE: As indicated DRAWN BY: SHP	CLIENT: American Realty Advisors As-Built Plan	PROJECT: Suite 150 & 200 76 Southwoods Drive Building 800 Atlanta, GA 30354	 HUGHES TURNER PHILLIPS ARCHITECTURE INTERIOR DESIGN SPACE PLANNING 2975 CLAYMONT ROAD, SUITE 100 ATLANTA, GA 30329 404.233.3553 FAX 404.261.1388