

1


**Reduced As-built**

Suite 703

Scale: 1/8" = 1'-0"



North

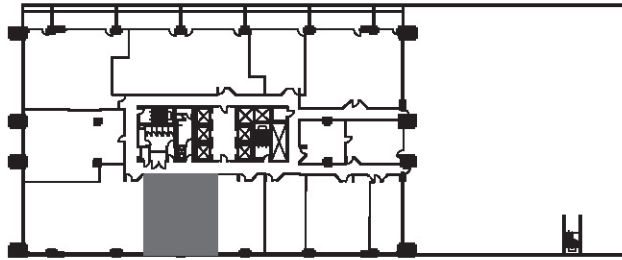

Proximity Plan

Suite 703

**The Chancery**

1,719 RSF

Reduced As-built Plan  
 Issued: March 2025  
 Drawn by: MCP / WCS  
 TPS Project #: 171001

The Chancery  
 Level Seven; Suite 703  
 1120 Lincoln Street  
 Denver, Colorado

**TPS**  
 1660 Lincoln St, Ste. 100  
 Denver, Colorado 80264  
 (303) 861-4800  
 www.TPS.design