

LAKEVIEW MEDICAL ARTS CENTER

13000 N 103RD AVE | SUN CITY, AZ 85351


Floor 1

Suite 59

AS-BUILT

1,121 SF

AVAILABLE

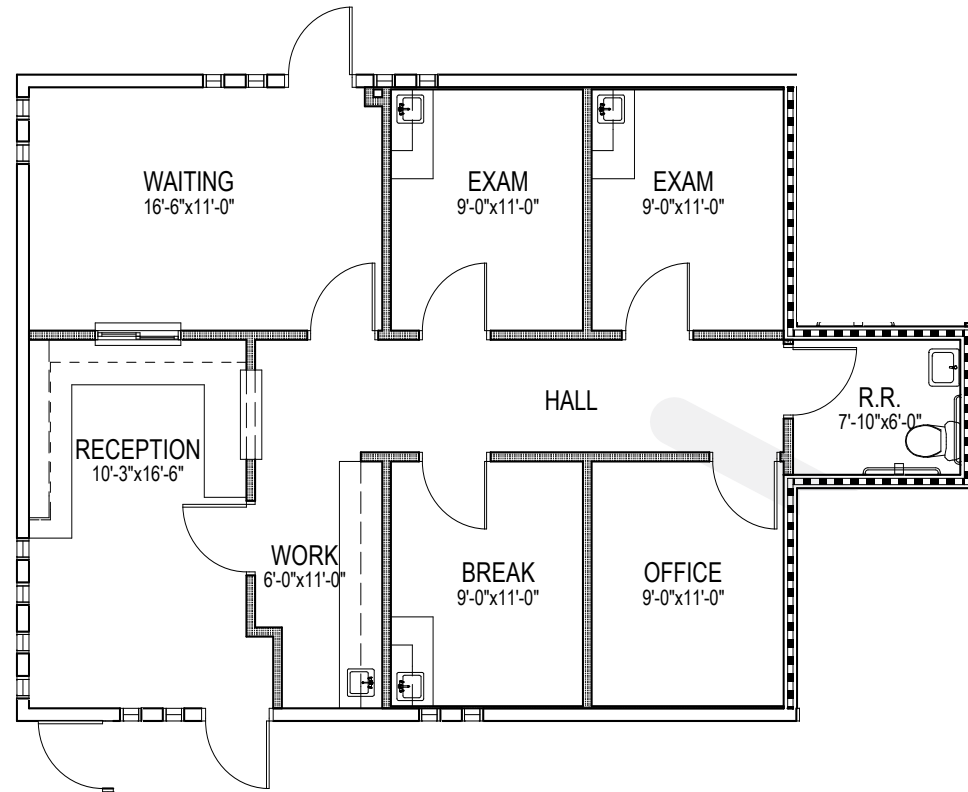

RACHAEL THOMPSON
Senior Vice President
602.513.5122
rachael.thompson@kidder.com

PERRY GABUZZI, CCIM
Senior Vice President
602.513.5116
perry.gabuzzi@kidder.com



View Portfolio

**km Kidder
Mathews**