


# 15 Spinning Wheel

15 Spinning Wheel Road  
Hinsdale, Illinois 60521

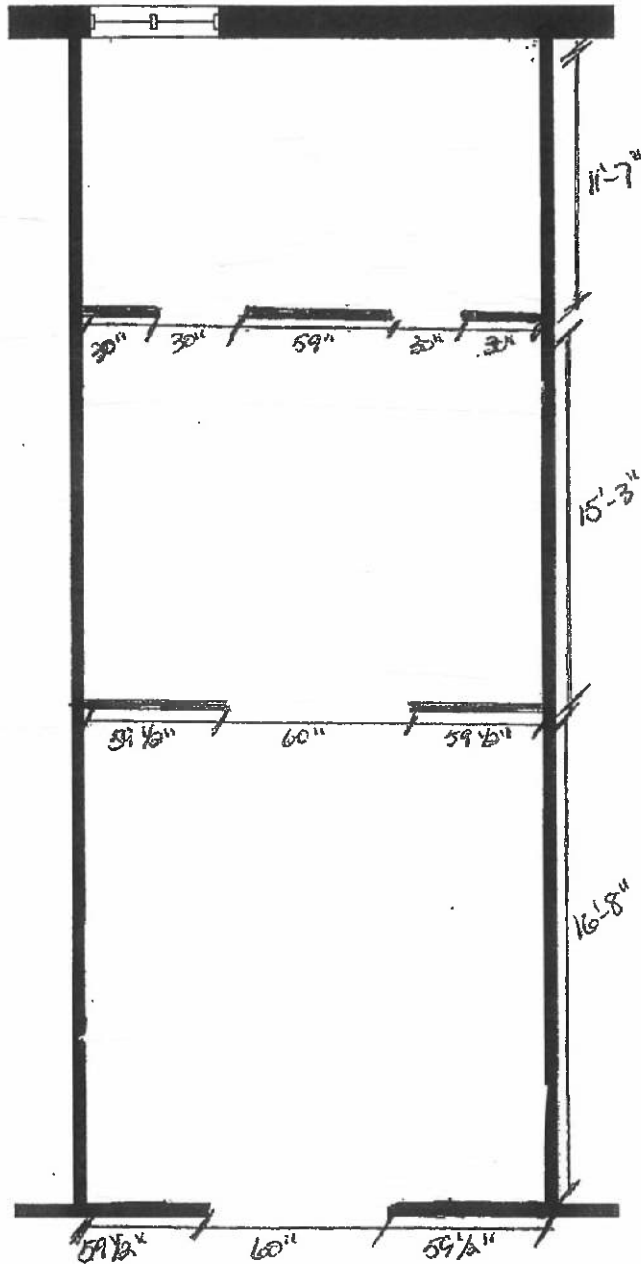

## Suite 316 - As-Built Conditions

654 Rentable Square Feet

Scale:

N.T.S.

01\_316\_18

