
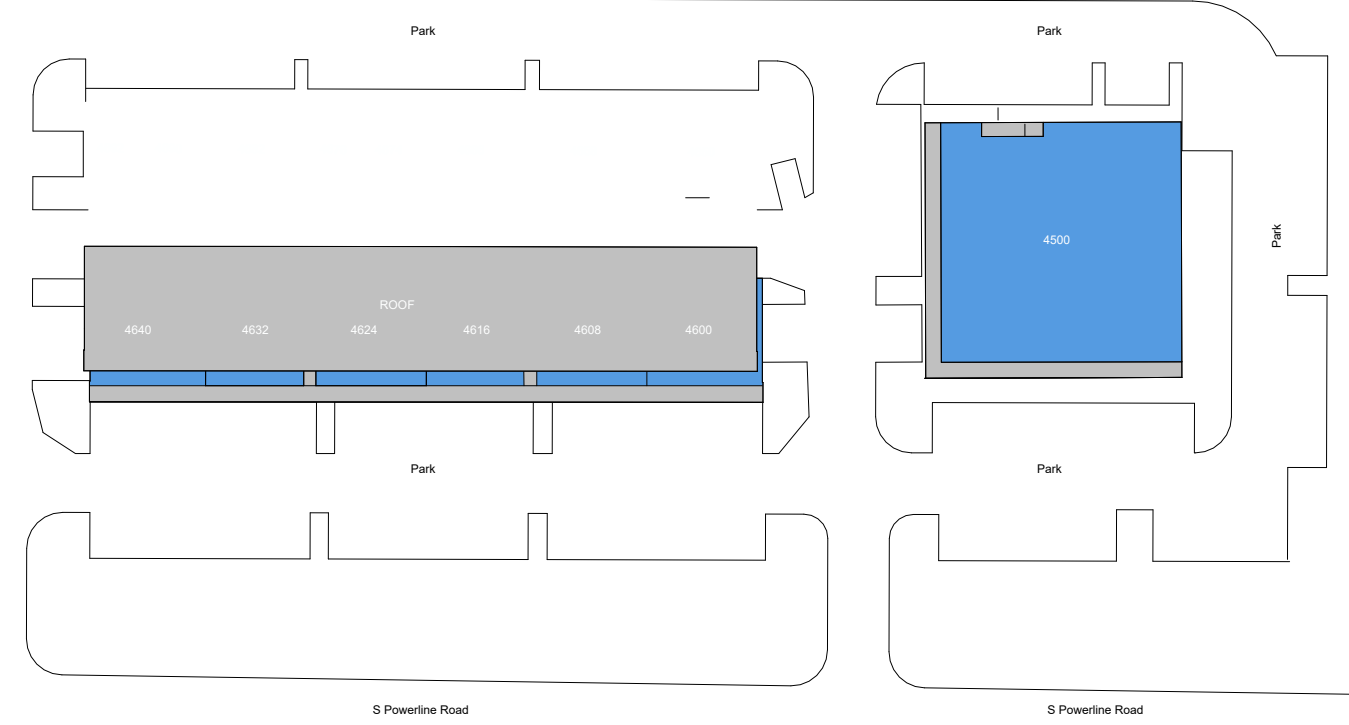


# Property Key

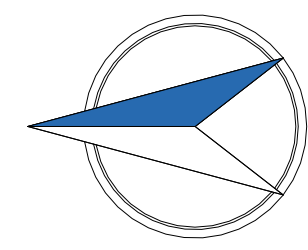


# Deerfield

4650 N Powerline Rd, Pompano Beach, 33073 FL

Building: 4650

Suite: 4674

Sheet **E1**

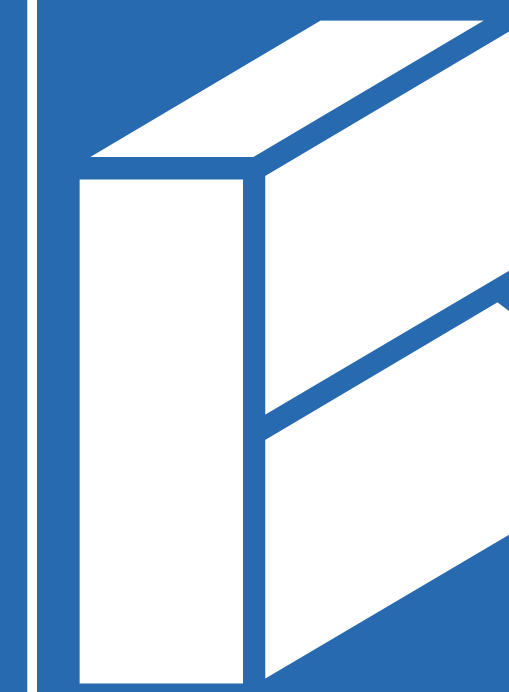

# BAY SPACE


Scale: Not to Scale  
Sheet Size: 42" x 30"  
Not For Construction

## Usable Square Foot Analysis

	SQFT	BUILDING PERCENTAGE
Office Area	1,100	100 %
Warehouse Area	0	0 %
Total Area	1,100	

## Building Information

Deck Height:	15' - 7 3/4"
Clear Height:	13' - 0 1/4"
Ceiling Height:	13' - 0 1/4"
Sprinklered:	<input type="checkbox"/> Yes <input checked="" type="checkbox"/> No
Mechanical Area:	0 SQFT

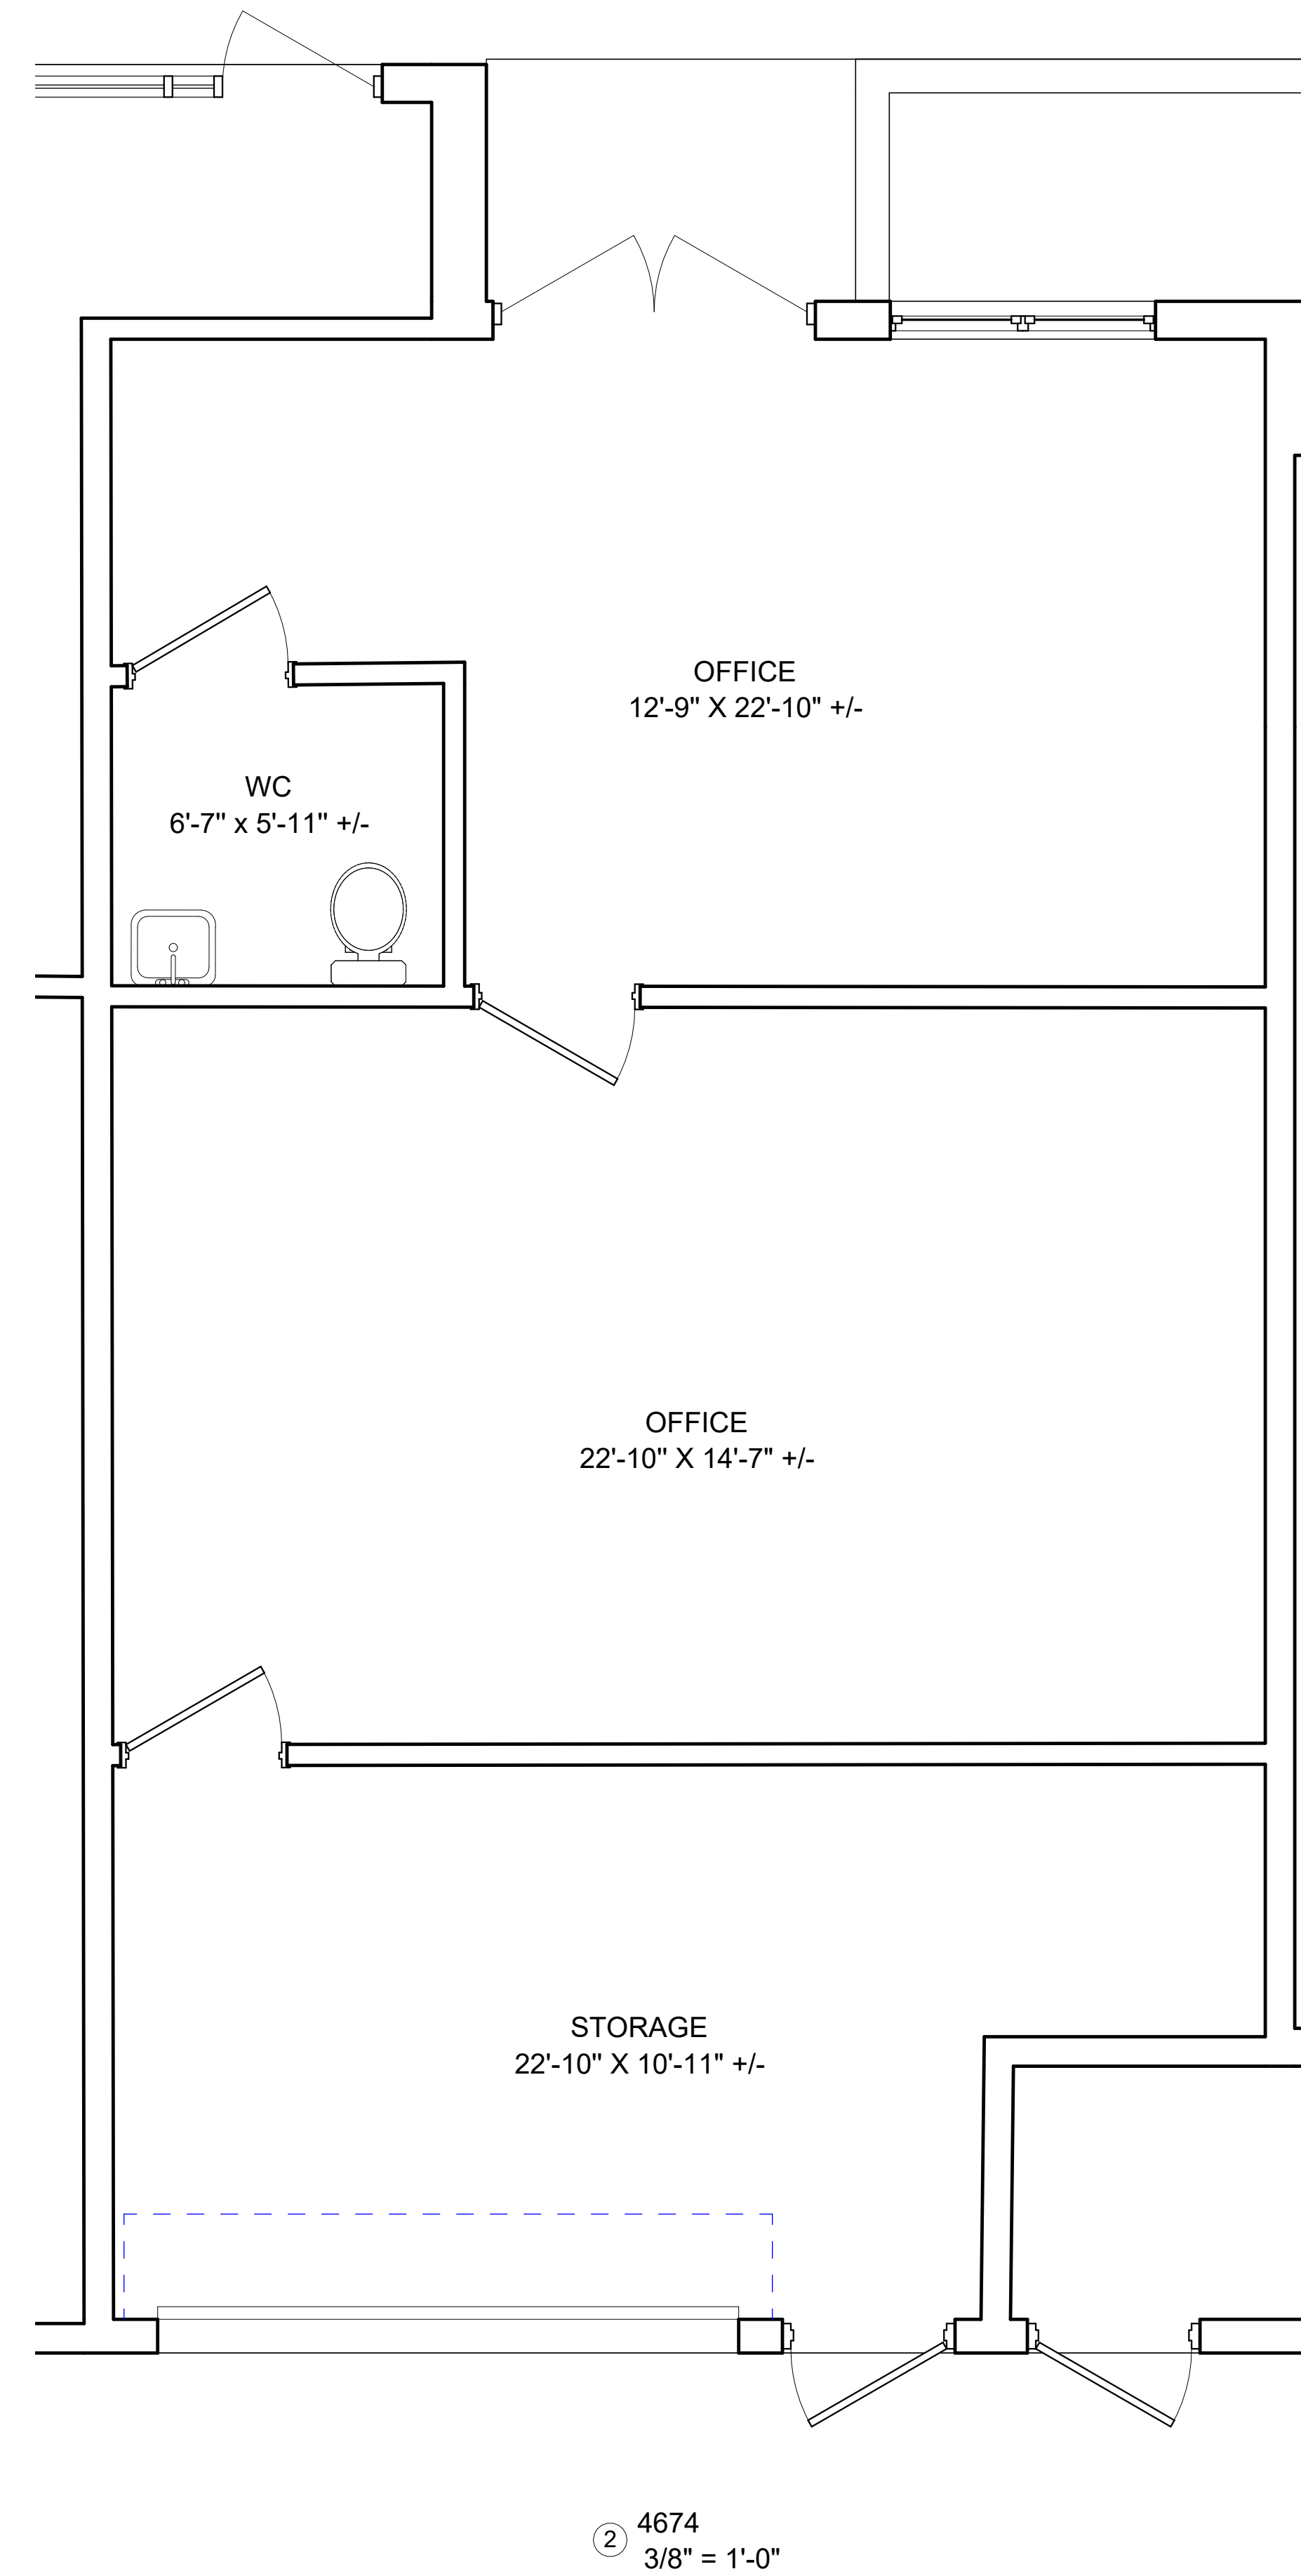

As Built Floor Plan for Marketing

